


Sec. 6

Tp. 2. S.

R. 2. E.

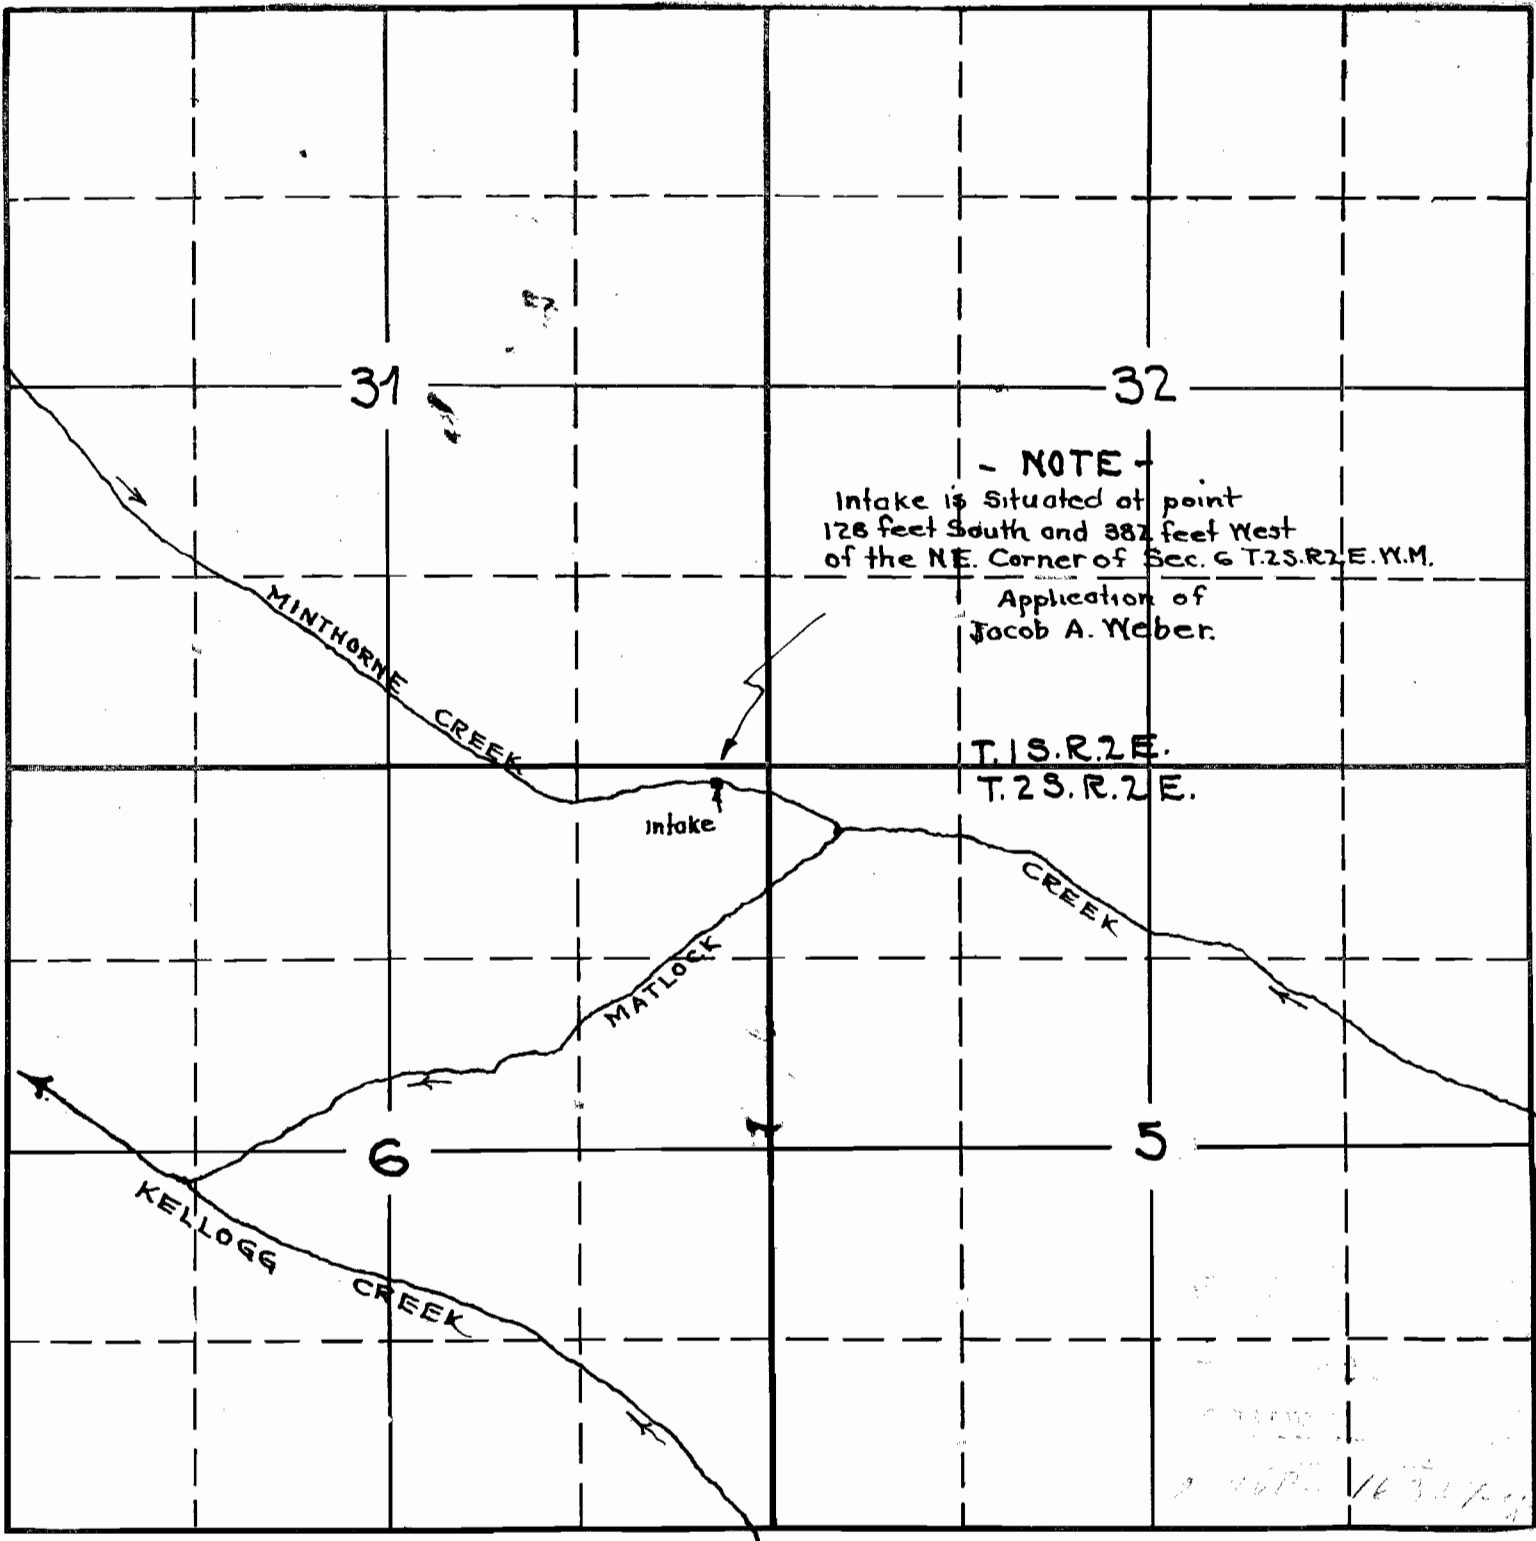


App. No. 16327  
 Per. No. 12131

SECTION

\_\_\_\_\_  
\_\_\_\_\_  
\_\_\_\_\_

TOWNSHIP \_\_\_\_\_, RANGE \_\_\_\_\_, W. M.

North

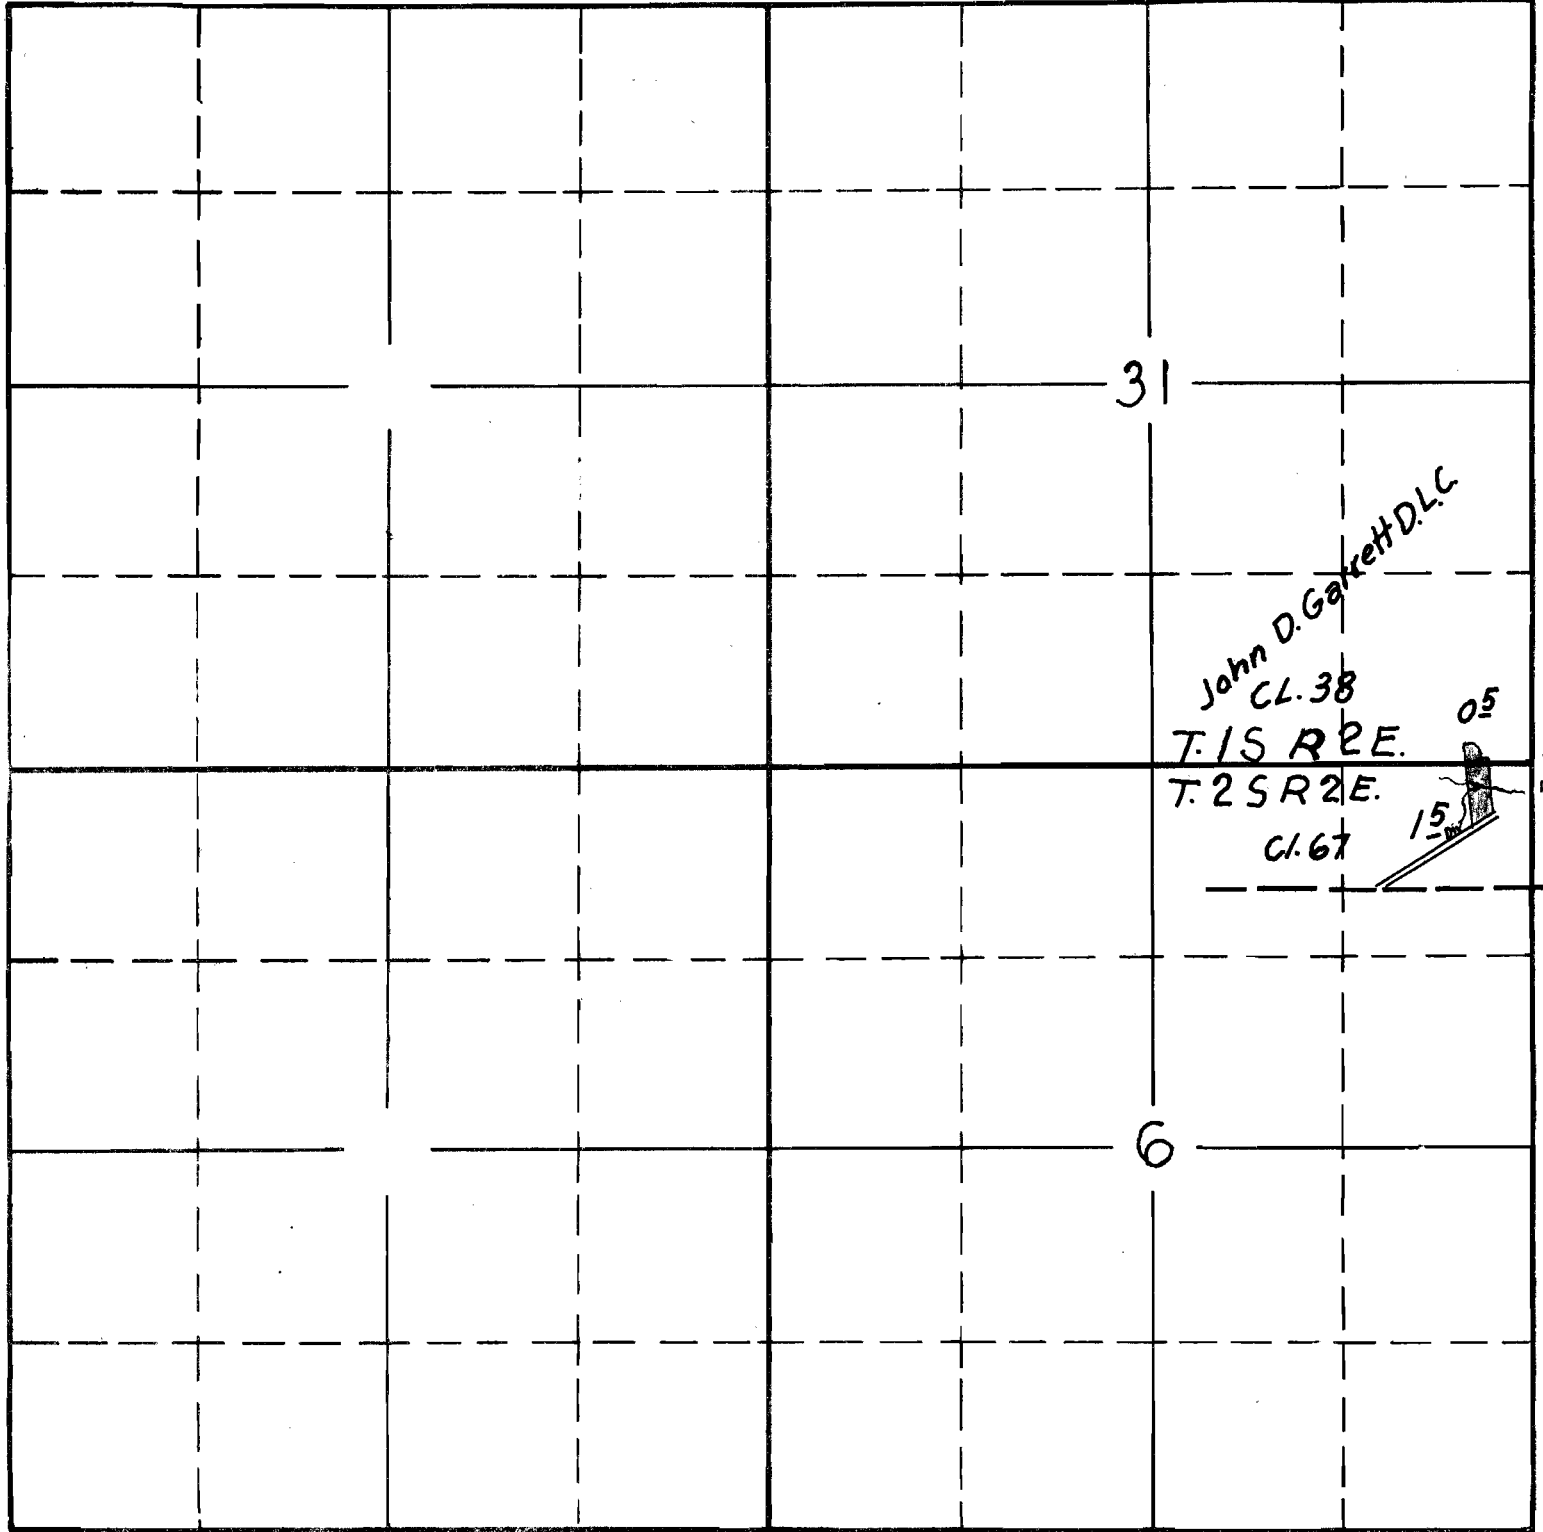

South

APPLICATION No. 16327  
PERMIT No. 12131