


SECTION

36

TOWNSHIP 13 S, RANGE 12 W, W. M.

North

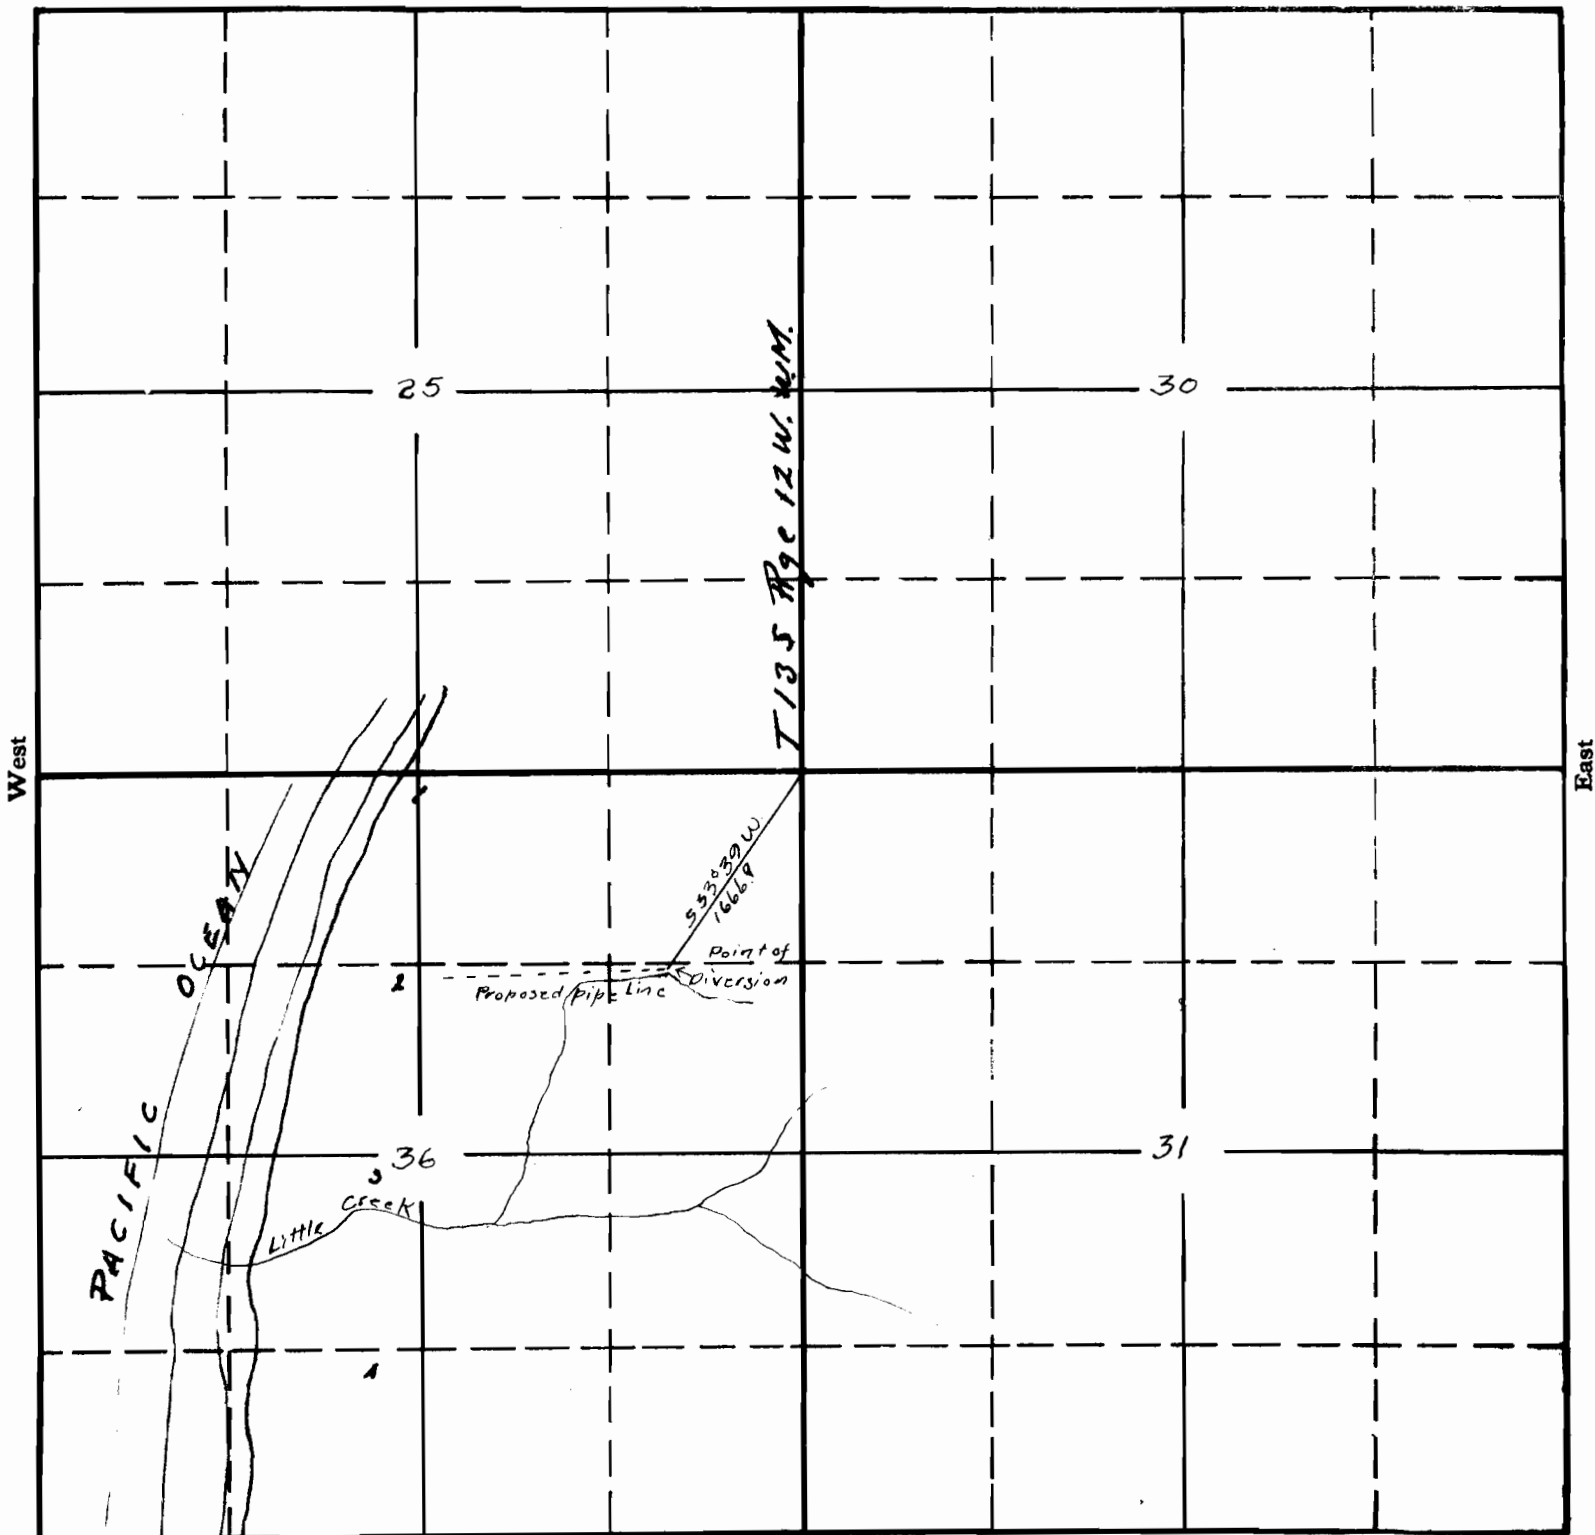

South

16342

APPLICATION No. 16342

PERMIT No. 12141