


SECTION

TOWNSHIP 4S, RANGE 8W, W. M.

North

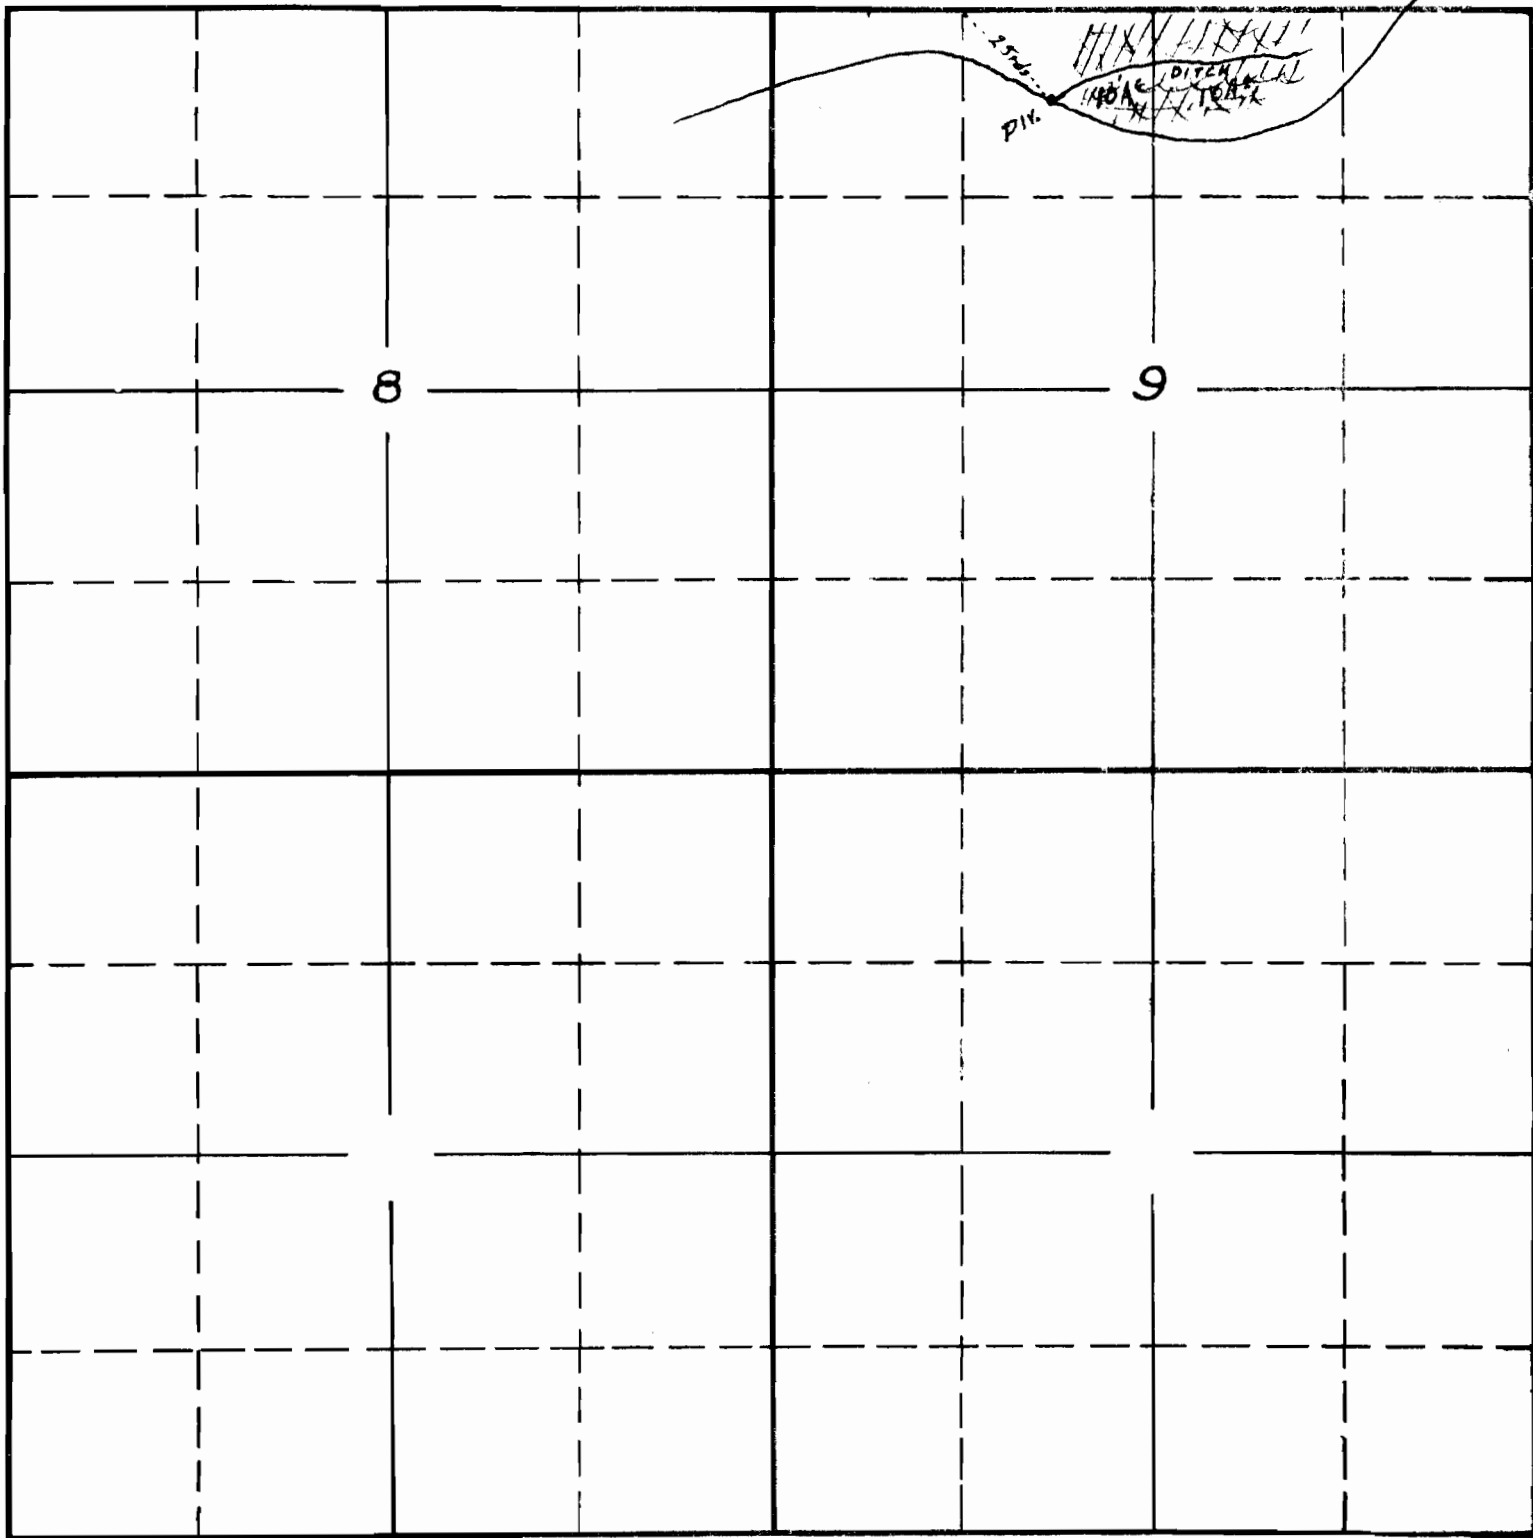


South

1/16A - 16350
APPLICATION No. 16350
PERMIT No. 12164

SECTION

TOWNSHIP 45 , RANGE 8W , W. M.

North

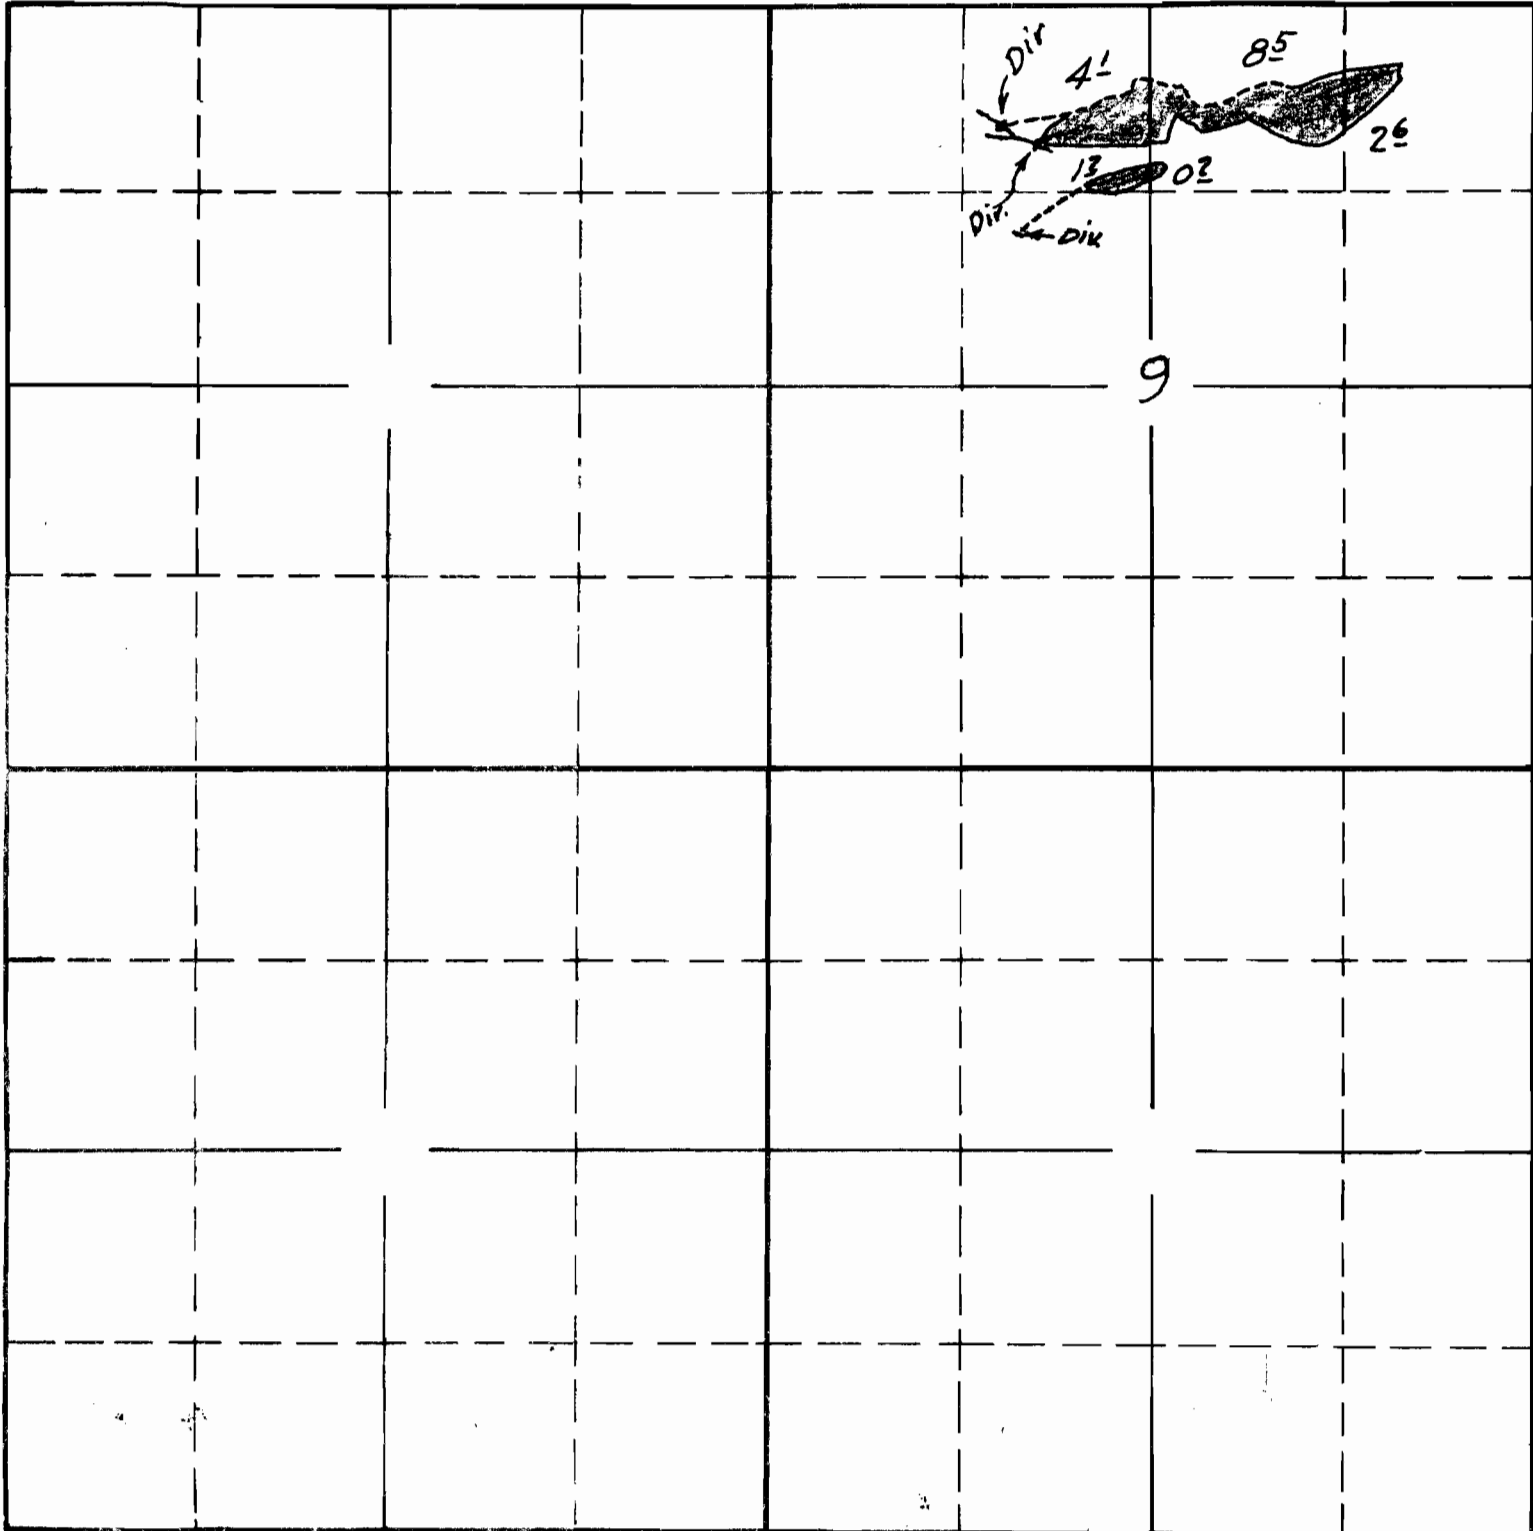

Surveyed June 25, 1940 C.A.C.

South

APPLICATION No. 16350
PERMIT No. 12164