


STATE ENGINEER
RECEIVED
MAY 19 1917
DIVISION

Application No. ~~14507~~ 16353

Permit No. ~~10510~~ 12166

Salmon & Kelchner

T. 38 S., R. 4 and 5 W. W. M.
Sec's. 19, 24

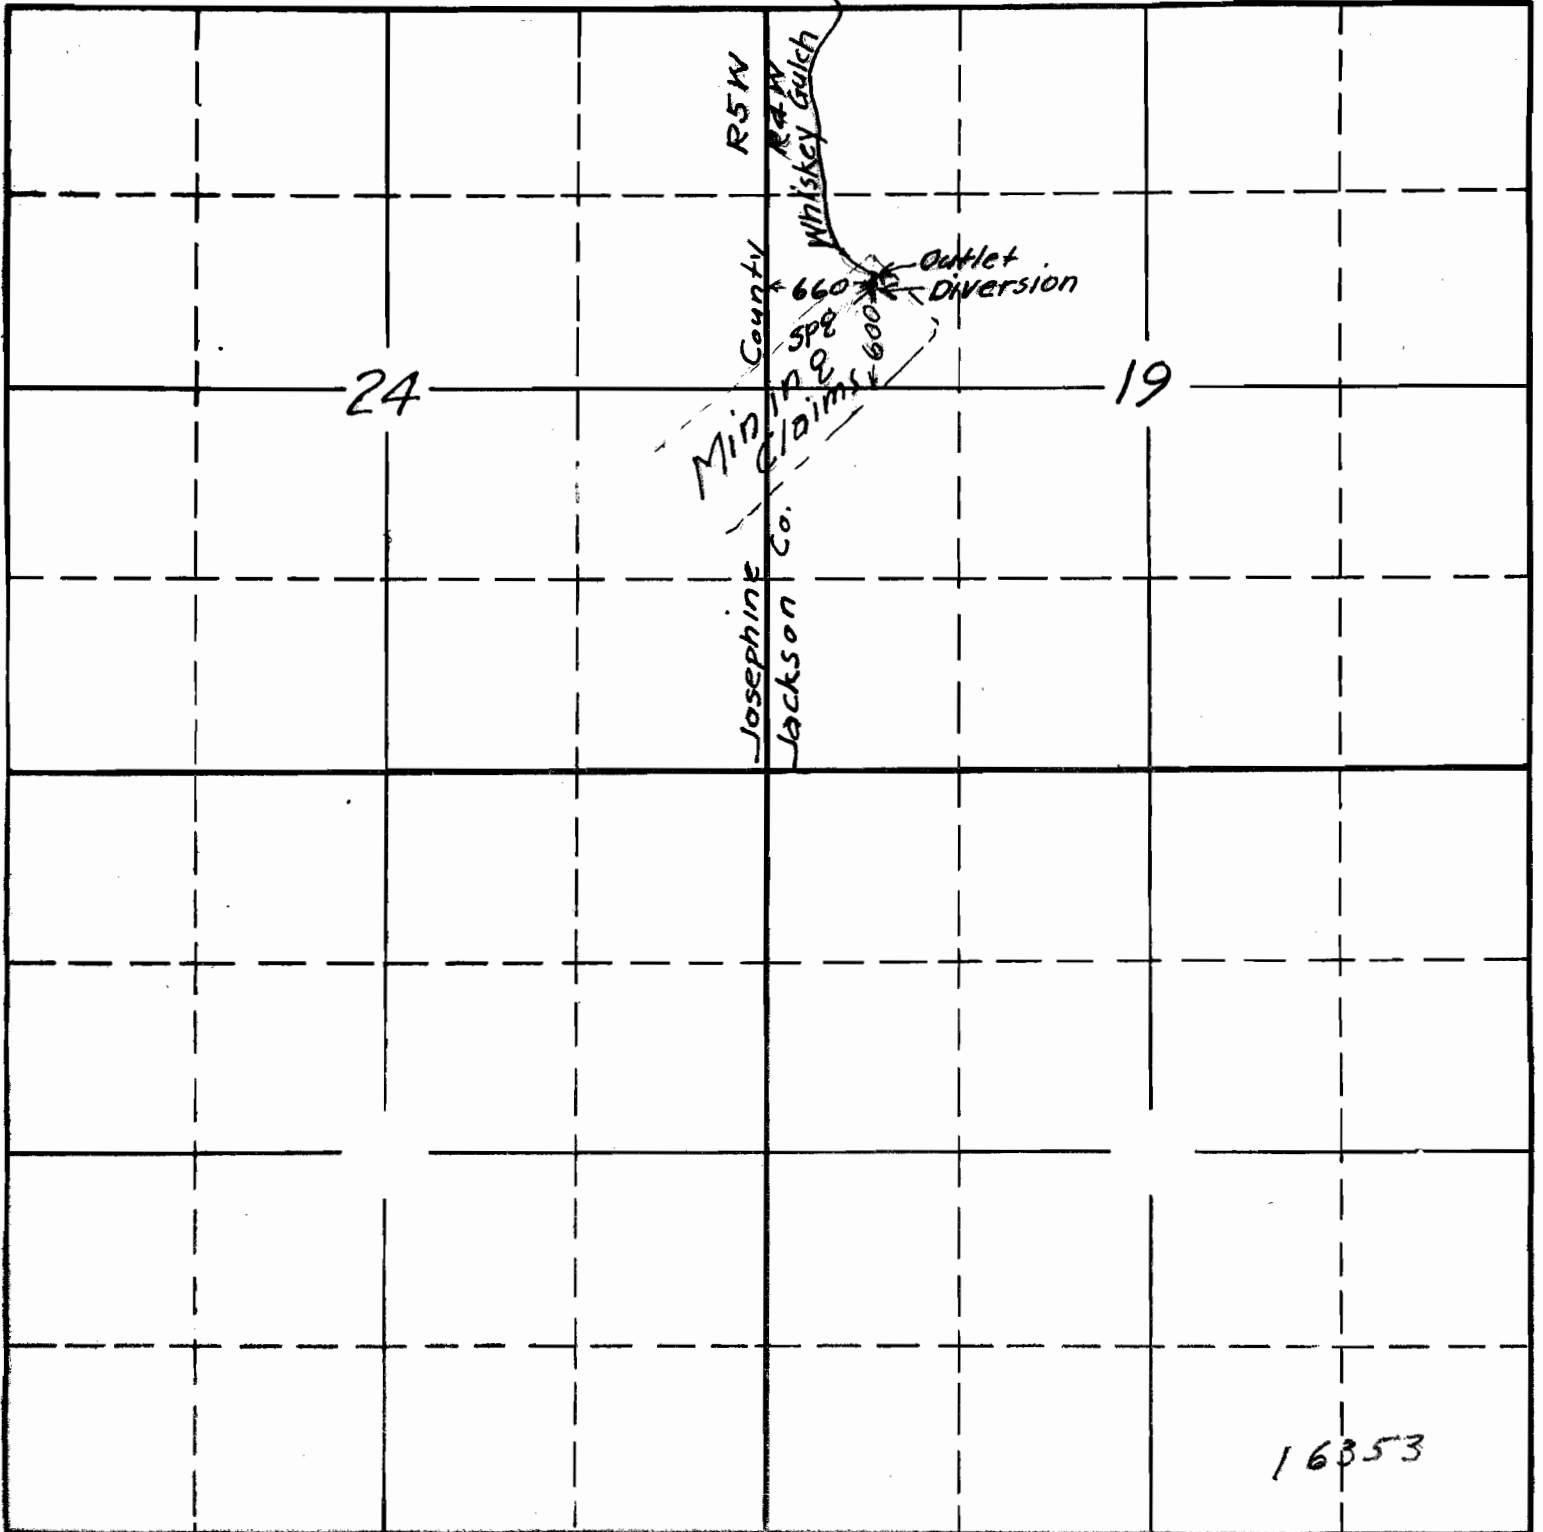

Sec. _____
Tp. _____
R. _____