


SECTION

TOWNSHIP 10S, RANGE 5E, W. M.

North

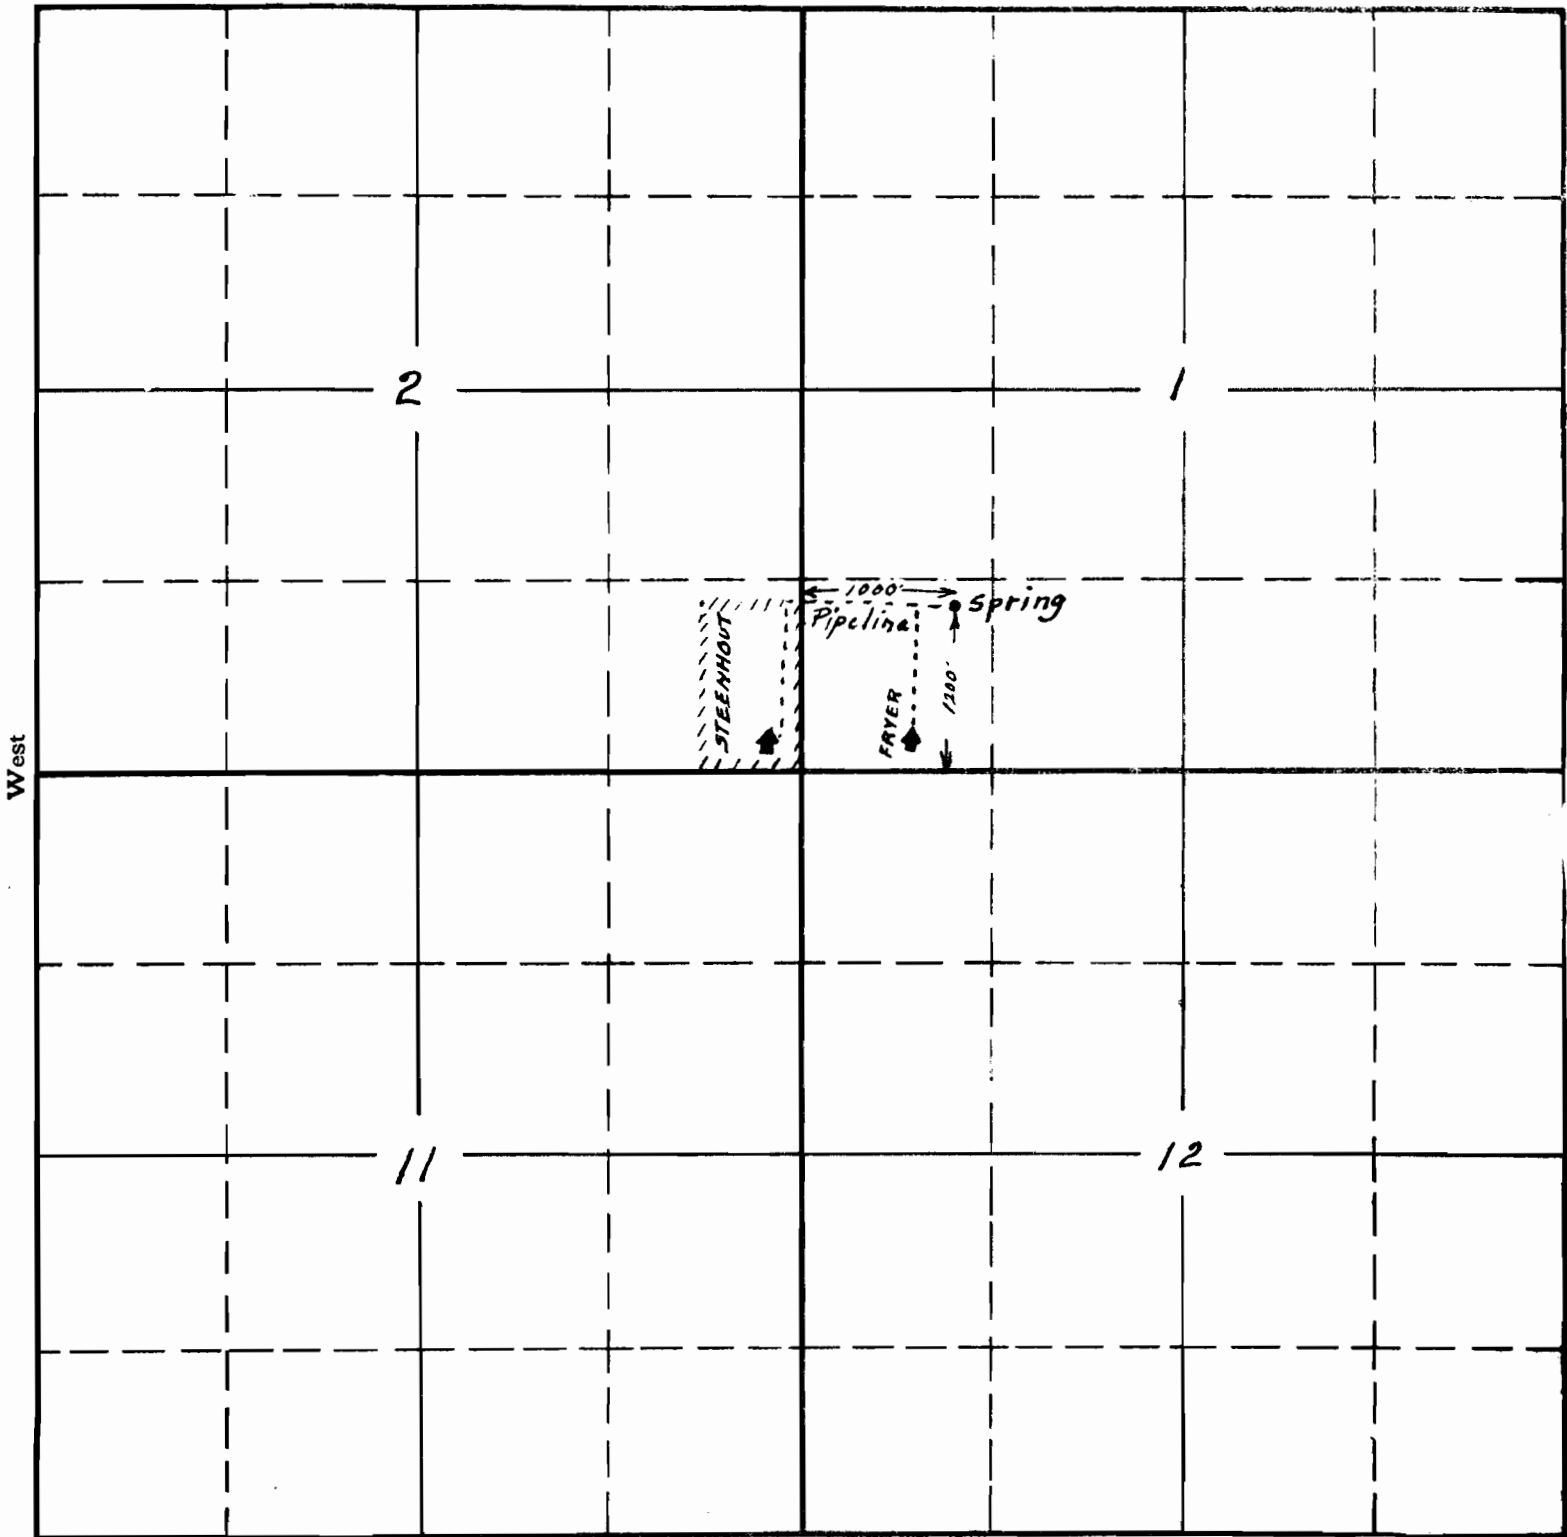

South

2-48-16358-OK
APPLICATION No. 16358
PERMIT No. 12174