


SECTION 5

TOWNSHIP 33^{So}, RANGE 15^W, W. M.

North

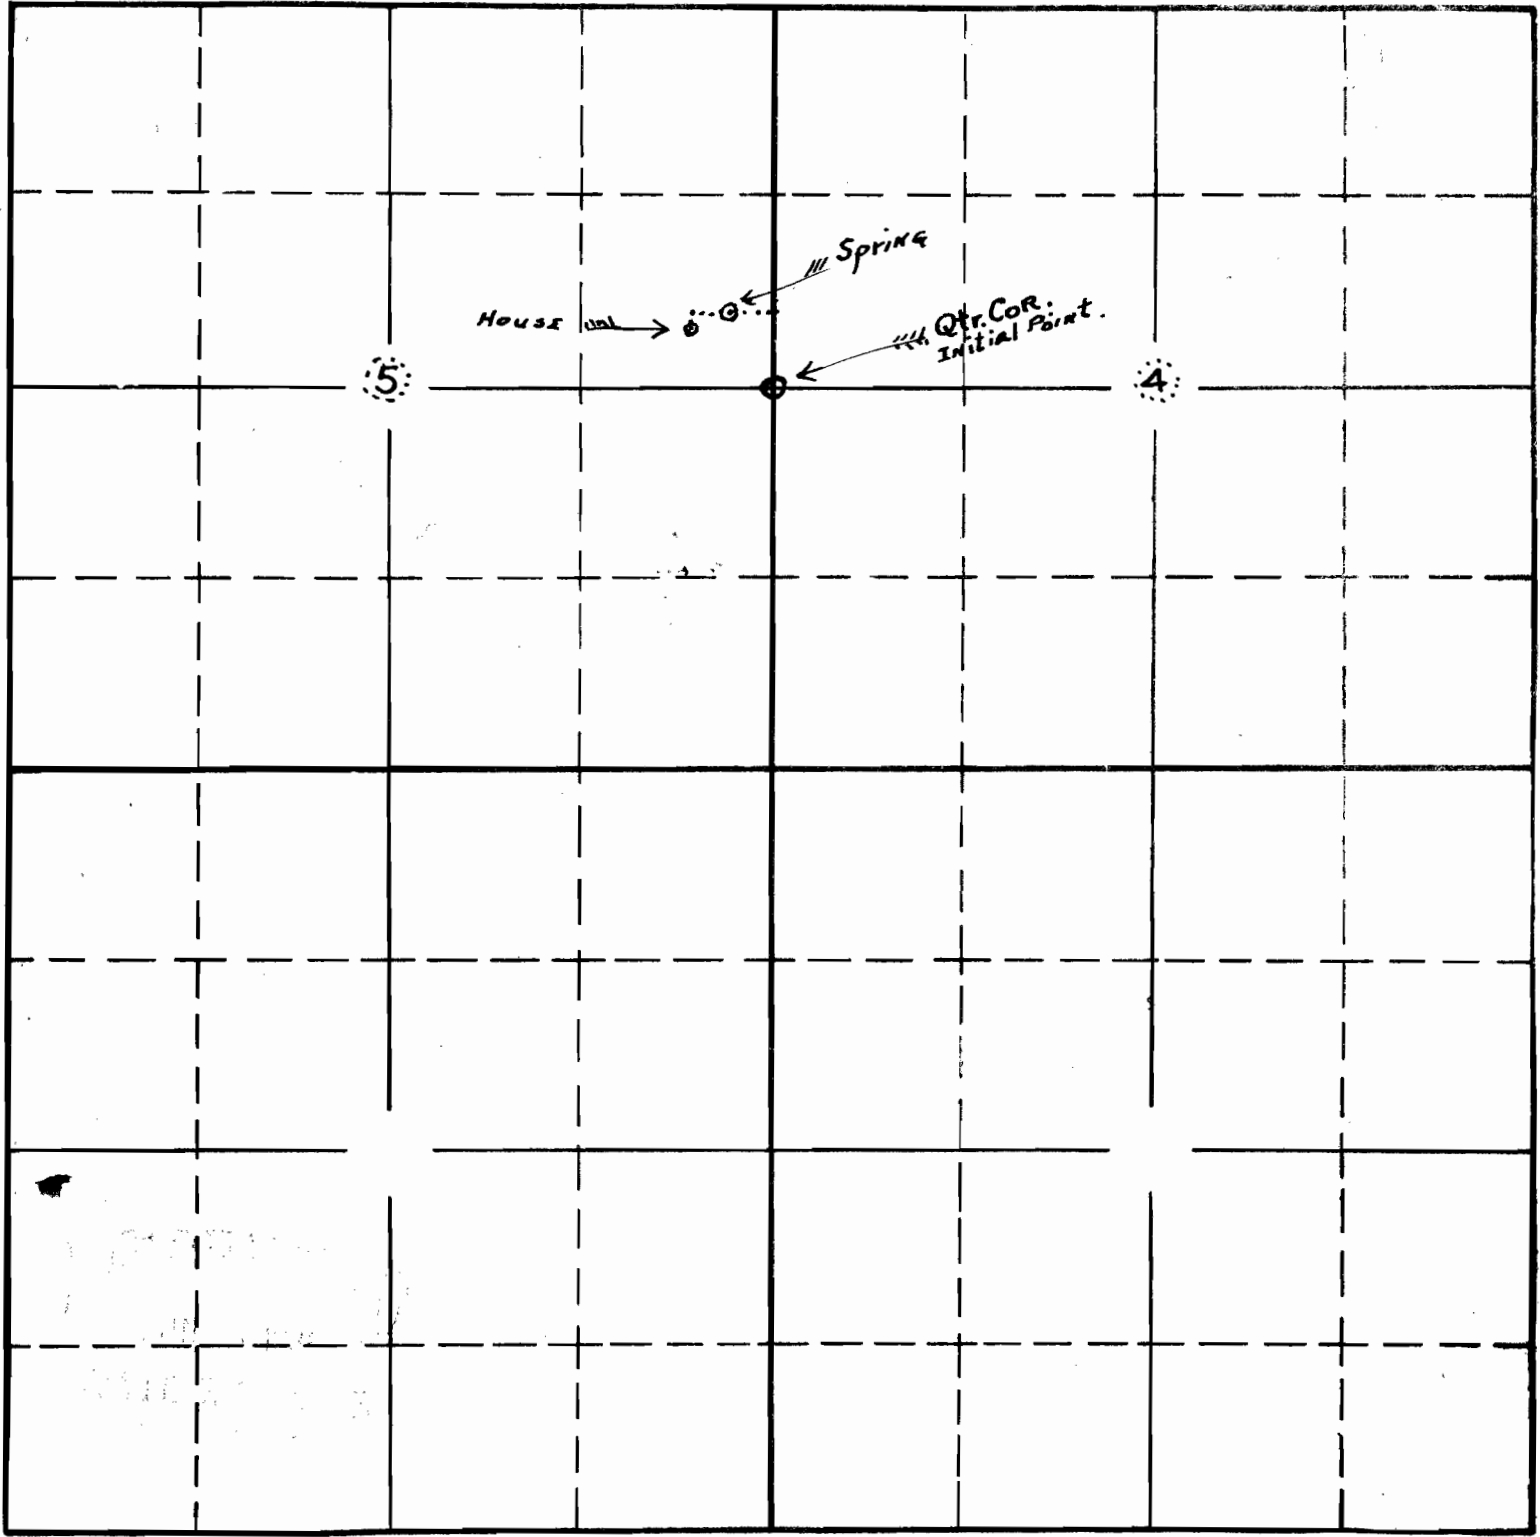

Scale 1320ft = 1inch.

South

Description —
 From initial point — Nor. 545 ft
 thence West — 320 ft — to Spring
 " — 250 ft
 " — 65 ft — to House.

APPLICATION No. 16379

PERMIT No. 12182