


SECTION

TOWNSHIP 37 S, RANGE 6 W, W. M.

North

May 1936

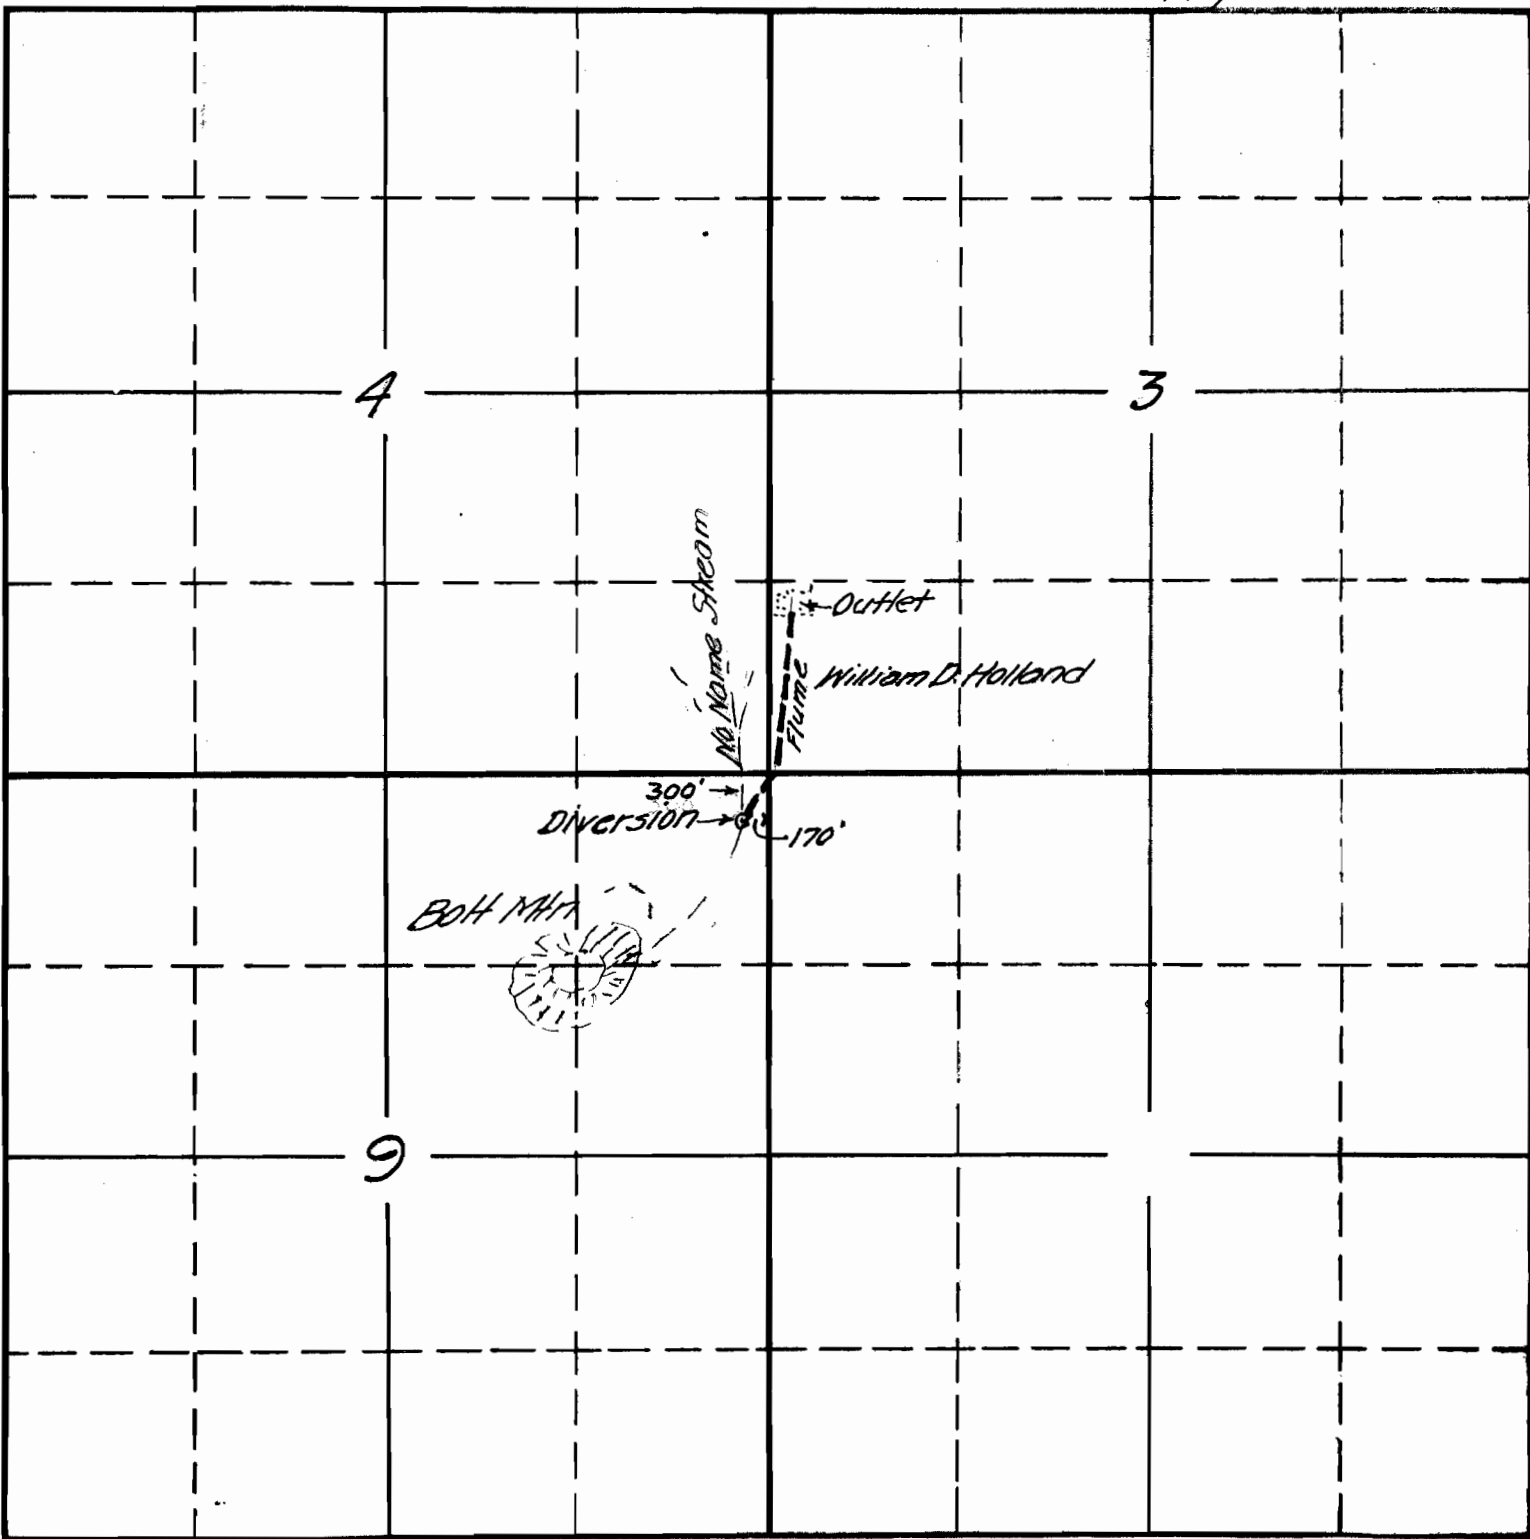

West

East

South

16383

APPLICATION No. 16383

PERMIT No. 12186

