


SECTION

TOWNSHIP 11 S, RANGE 7 W, W. M.

North

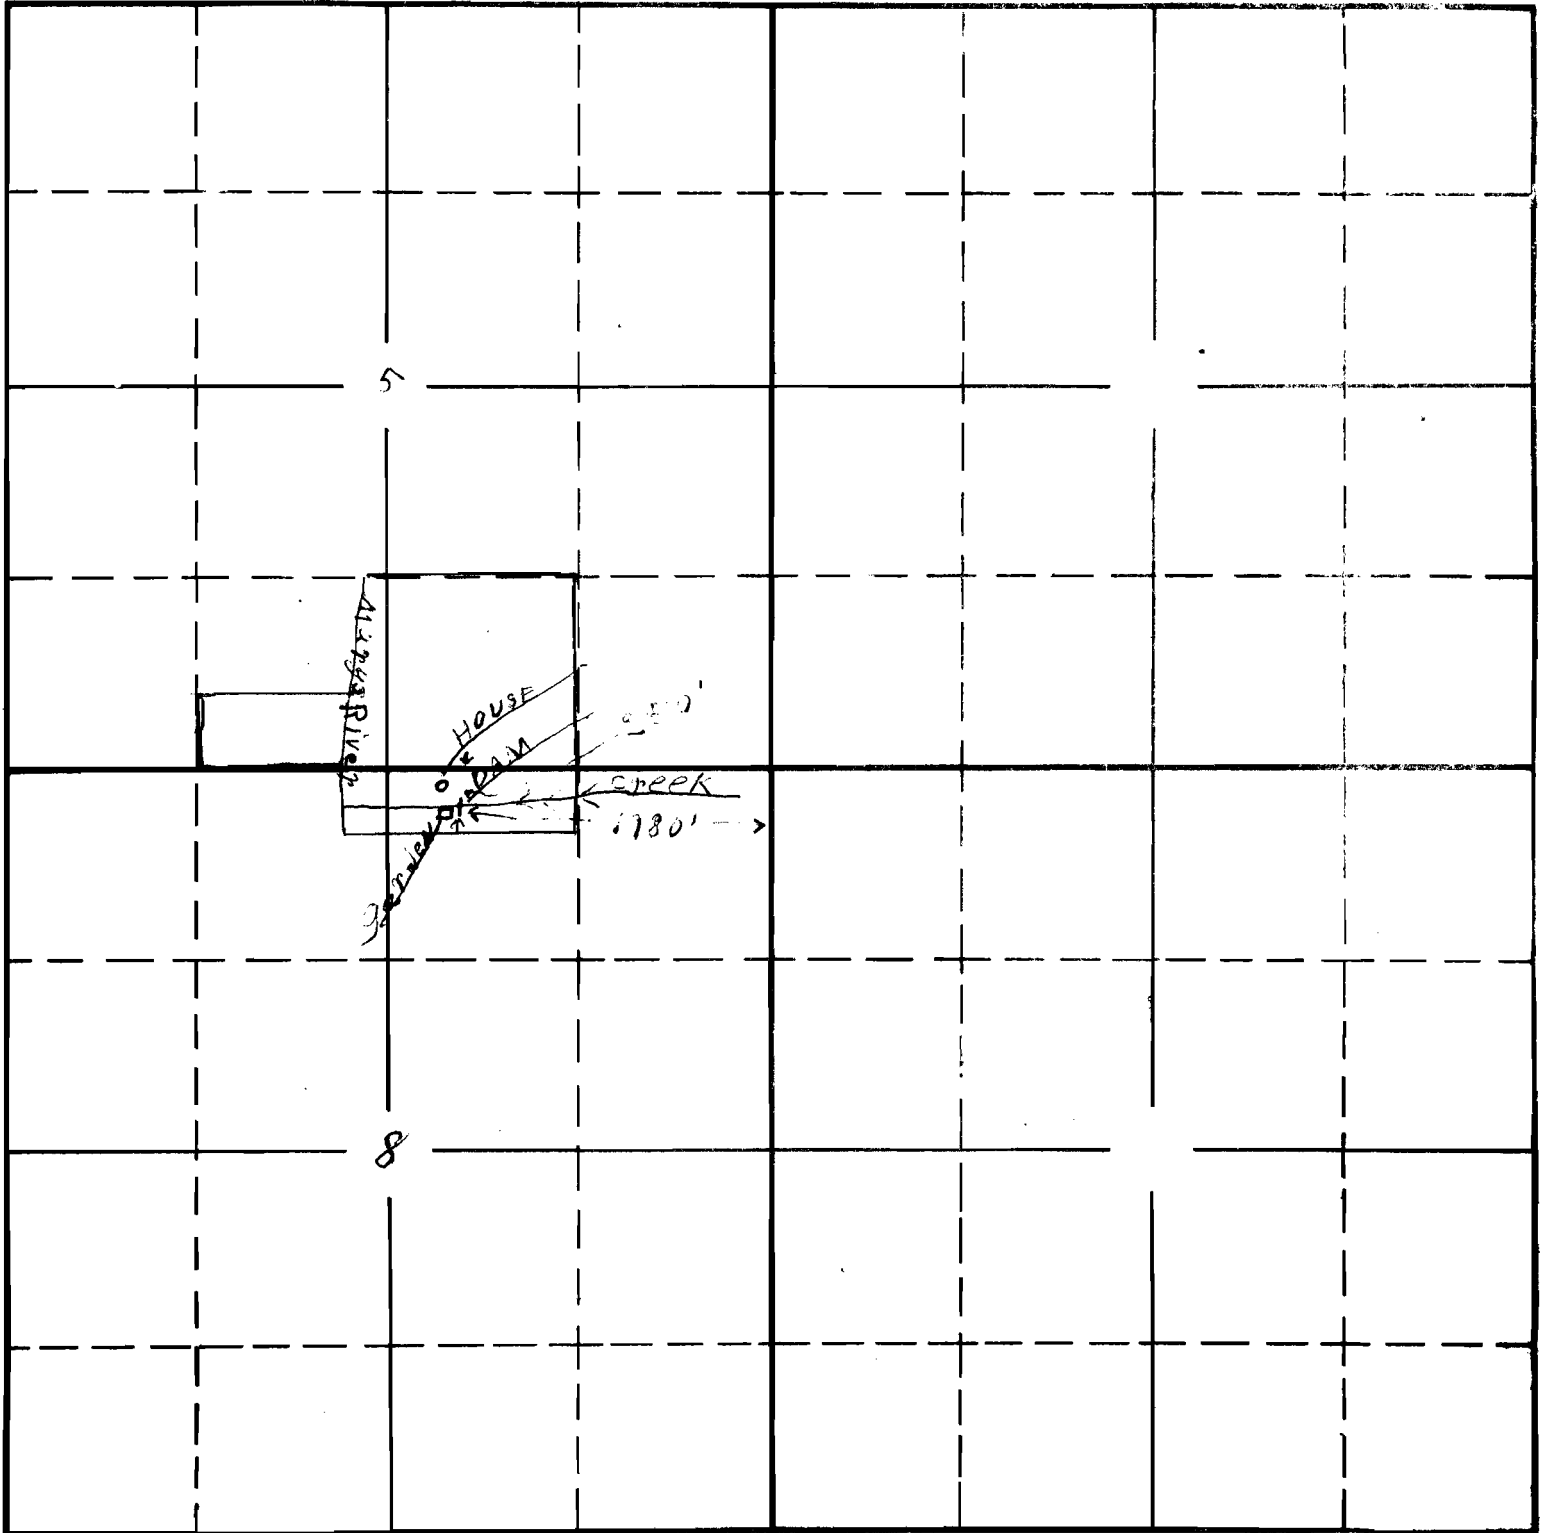

South

RECEIVED

MAY 27 1936

STATE ENGINEER

SALEM, OREGON

2-22-16394-6k

APPLICATION No. 16394

PERMIT No. 12195