


T. 30 S., R.'s 5-6 W., W.M.

Apr. 1936

Scale 8" = 1 Mile

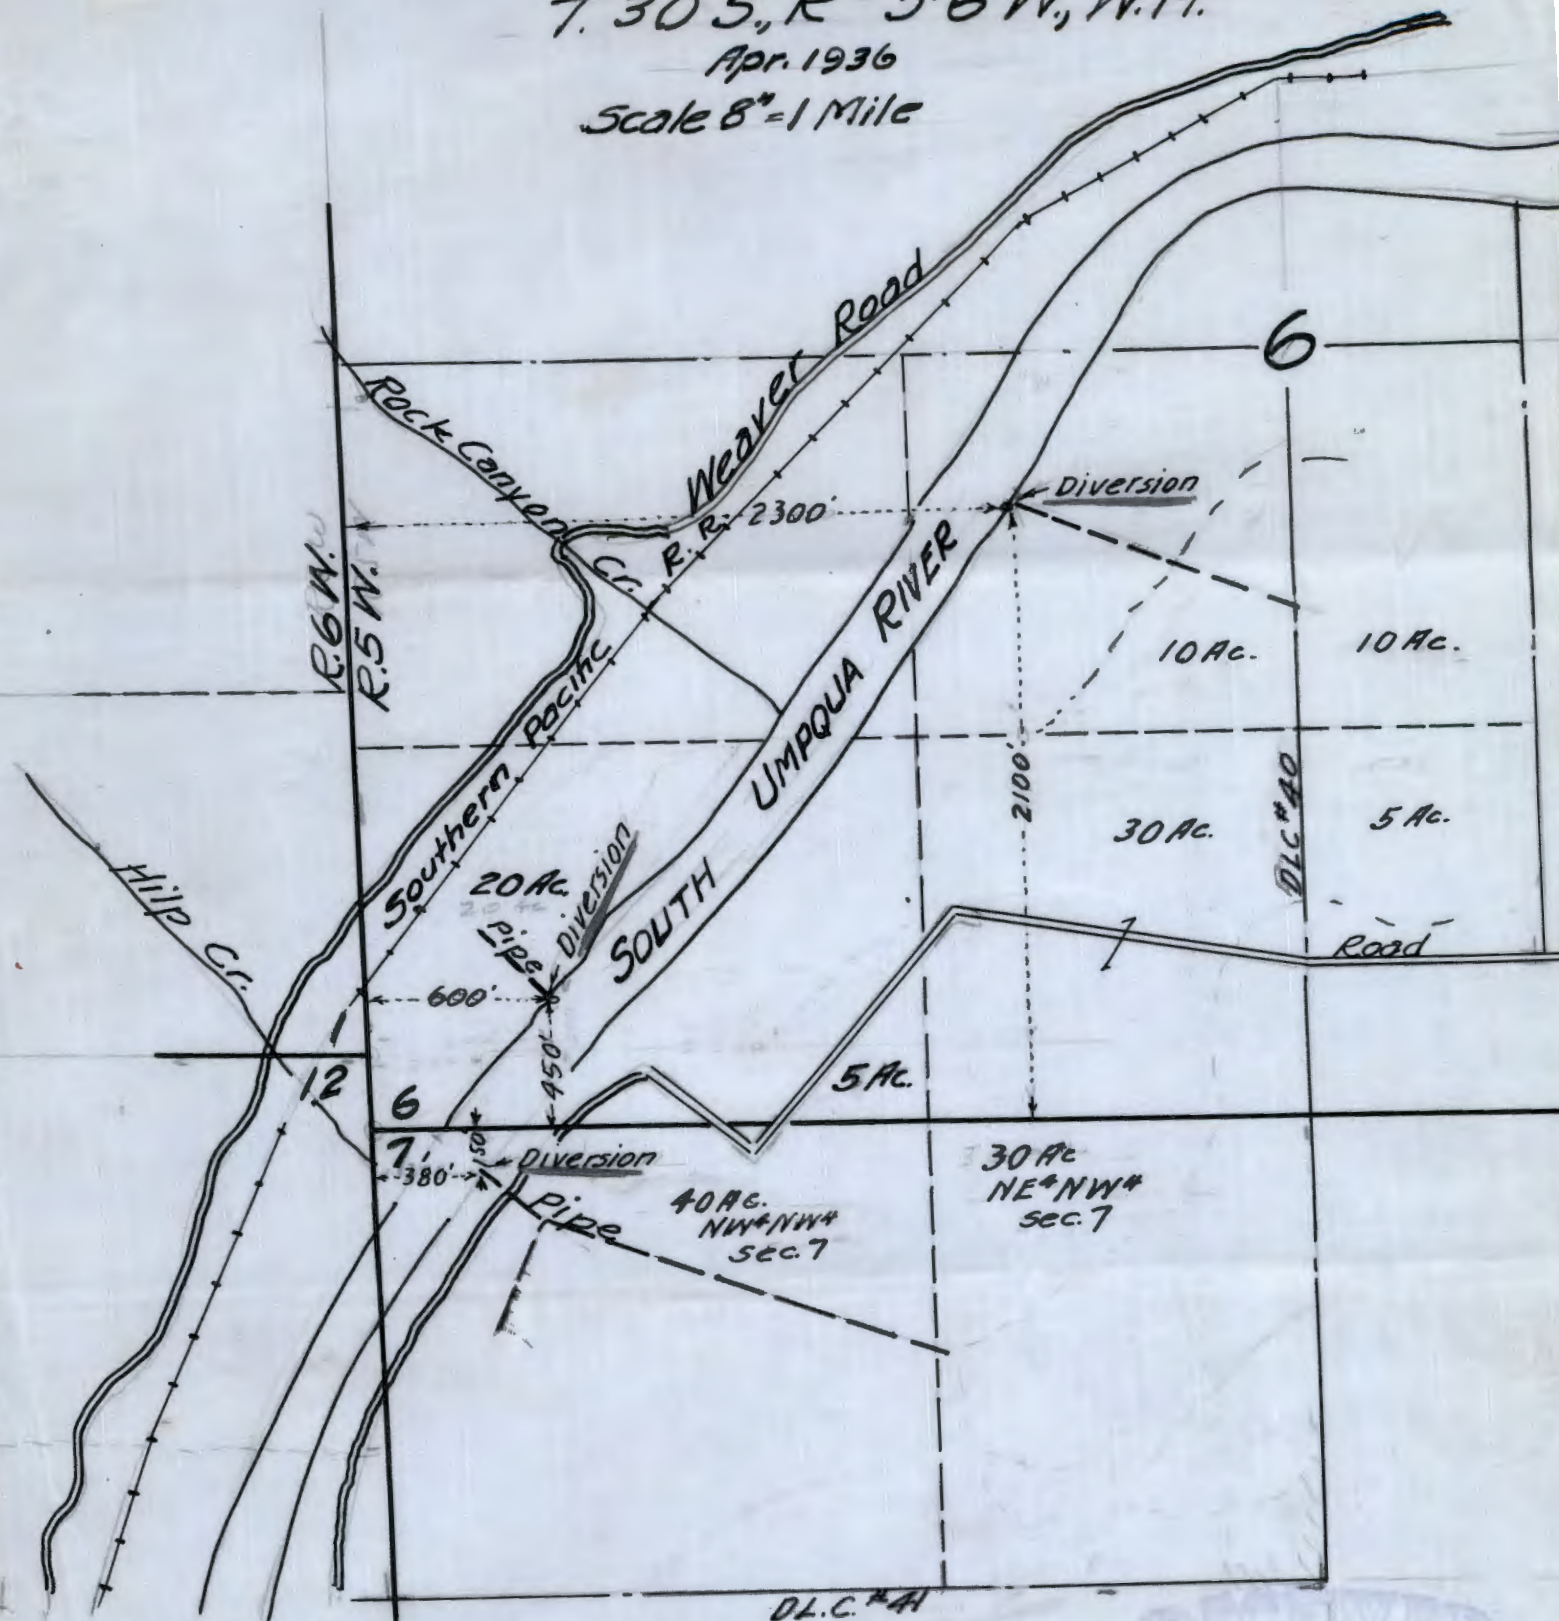

App. No. 16401  
Per. No. 12200

RECEIVED  
JUN 1936  
STATE REGISTER  
SALEM, OREGON