


SECTION

TOWNSHIP 40 S, RANGE 8 W., W. M.

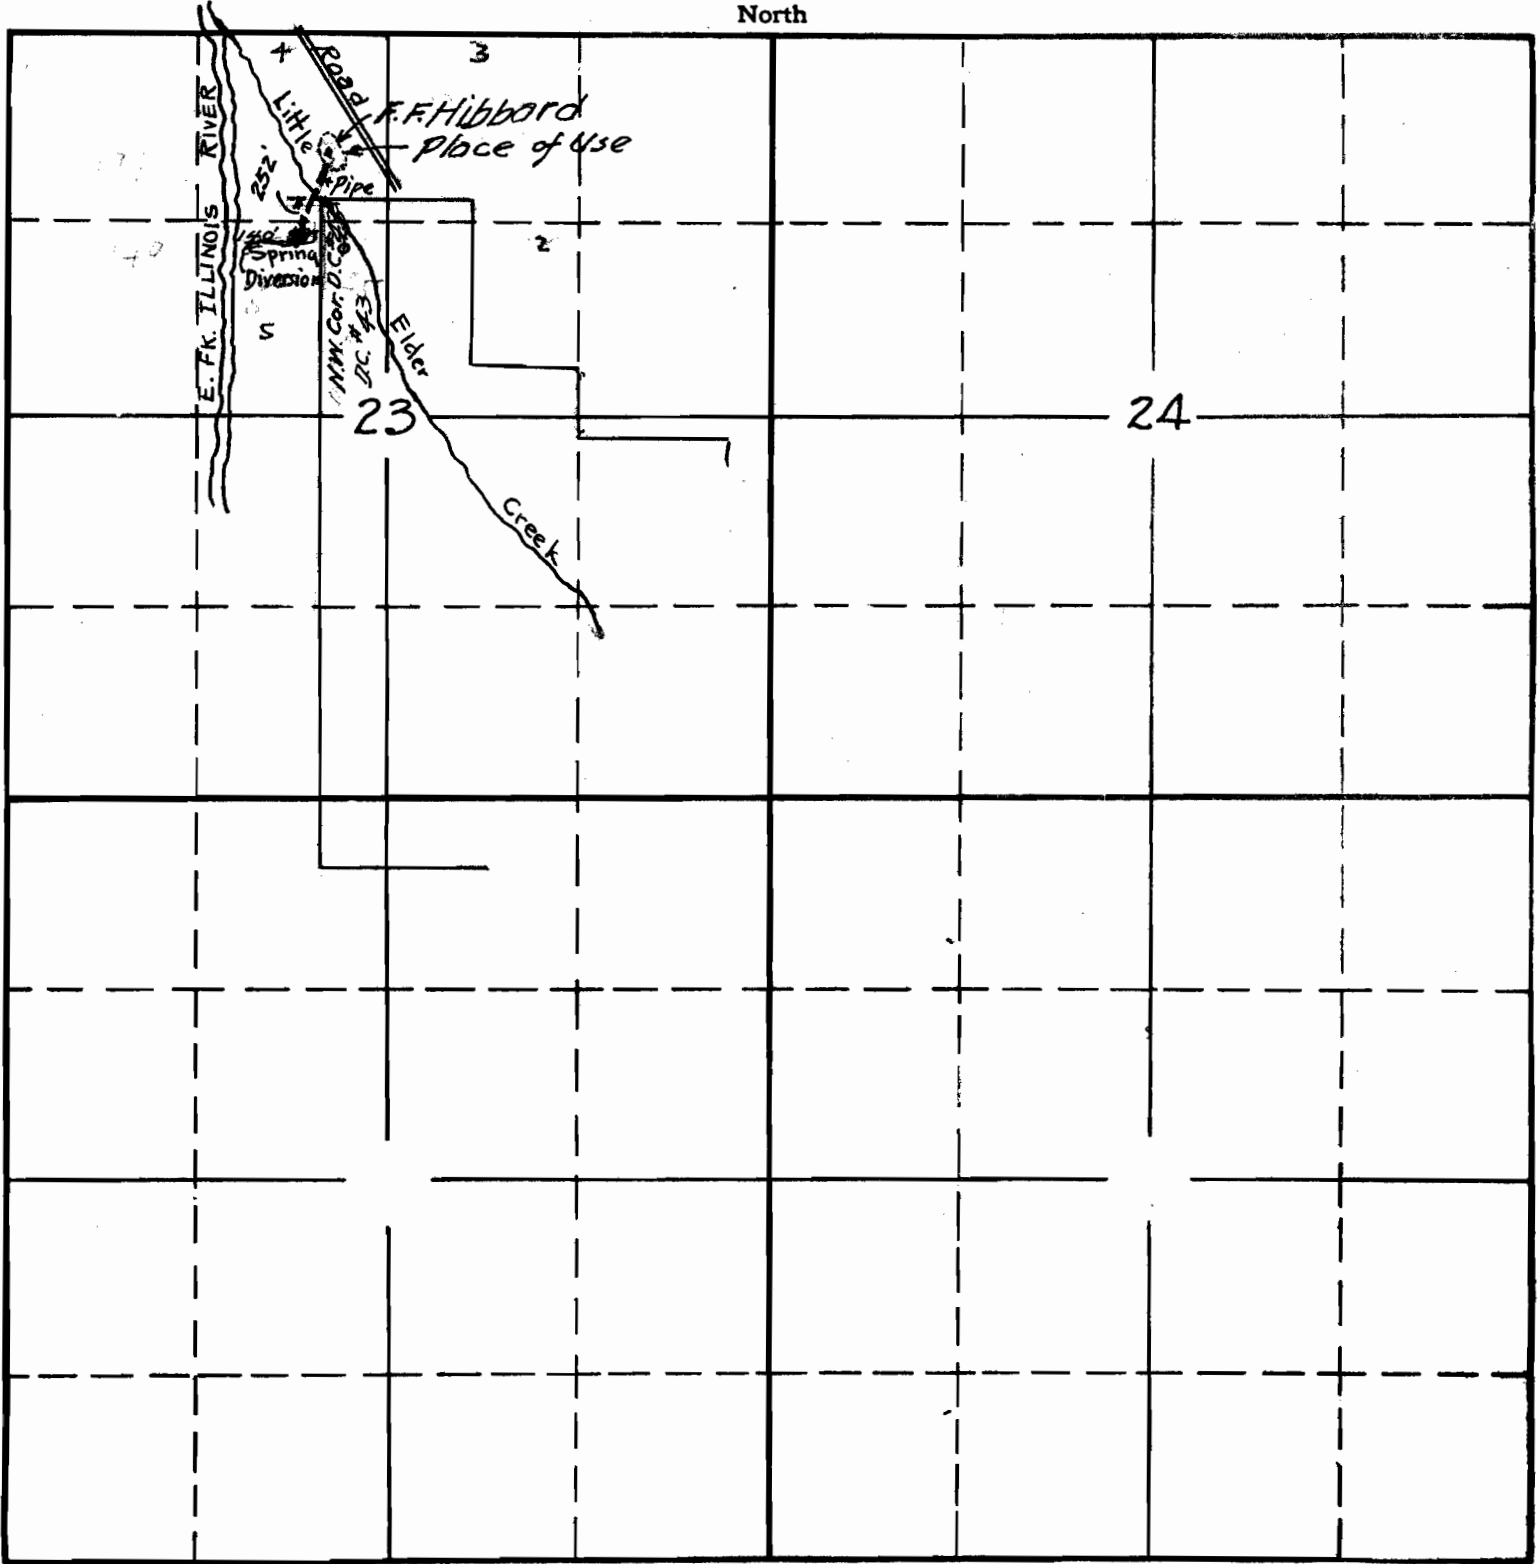

South

June '36

APPLICATION No. 16403

PERMIT No. 12202