


SECTION

1

TOWNSHIP 25 , RANGE 1E , W. M.

North

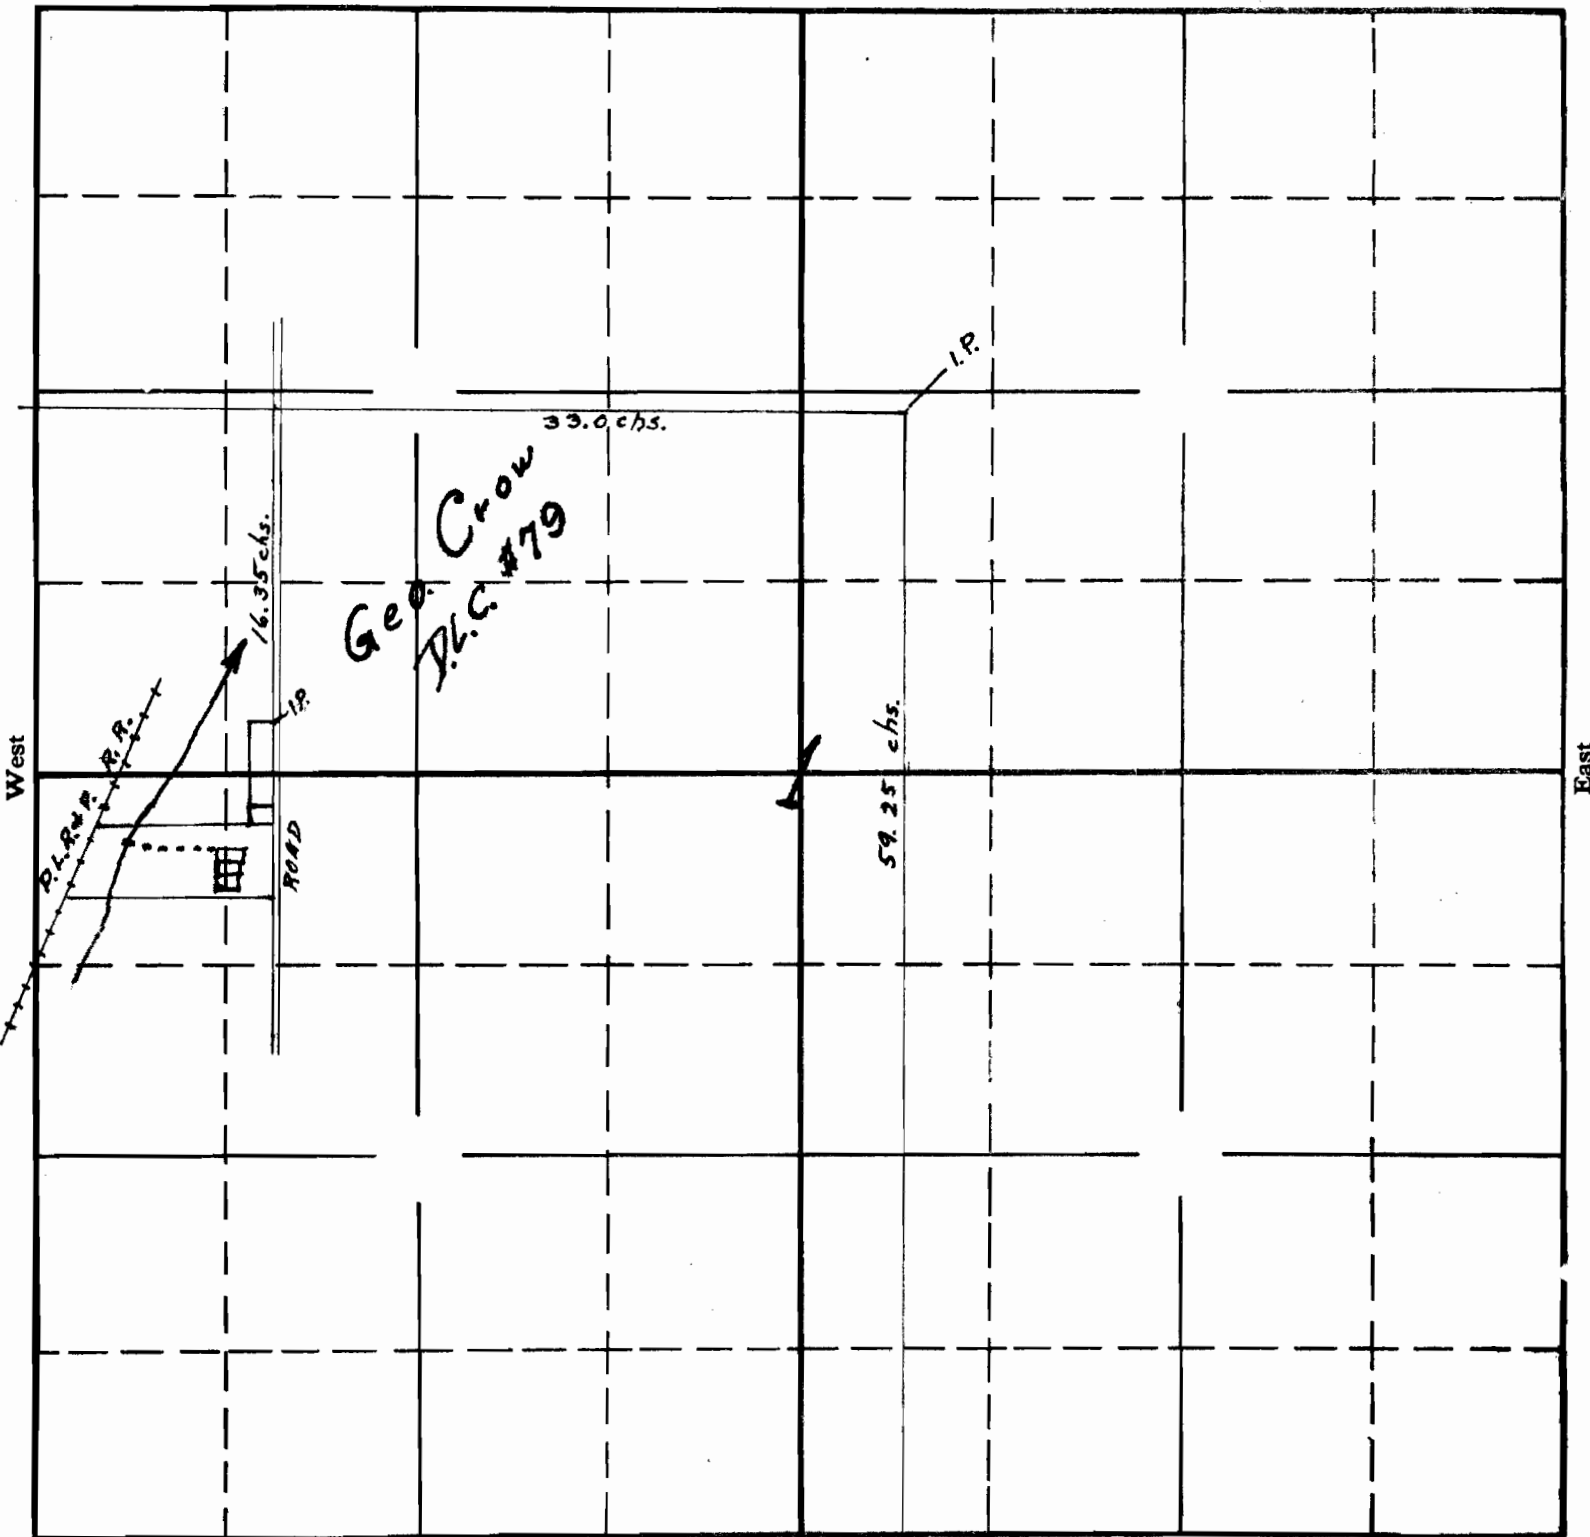

West

East

South

2-76-16376
 APPLICATION No. 16376
 PERMIT No. 12214

Super Highway.

County road

brook.

Oregon City bar here

Tonbank

Oak Grove

River road.

Super











