


SECTION

13 & 18

TOWNSHIP 45, RANGE 1 & 2 E, W. M. respectively

North

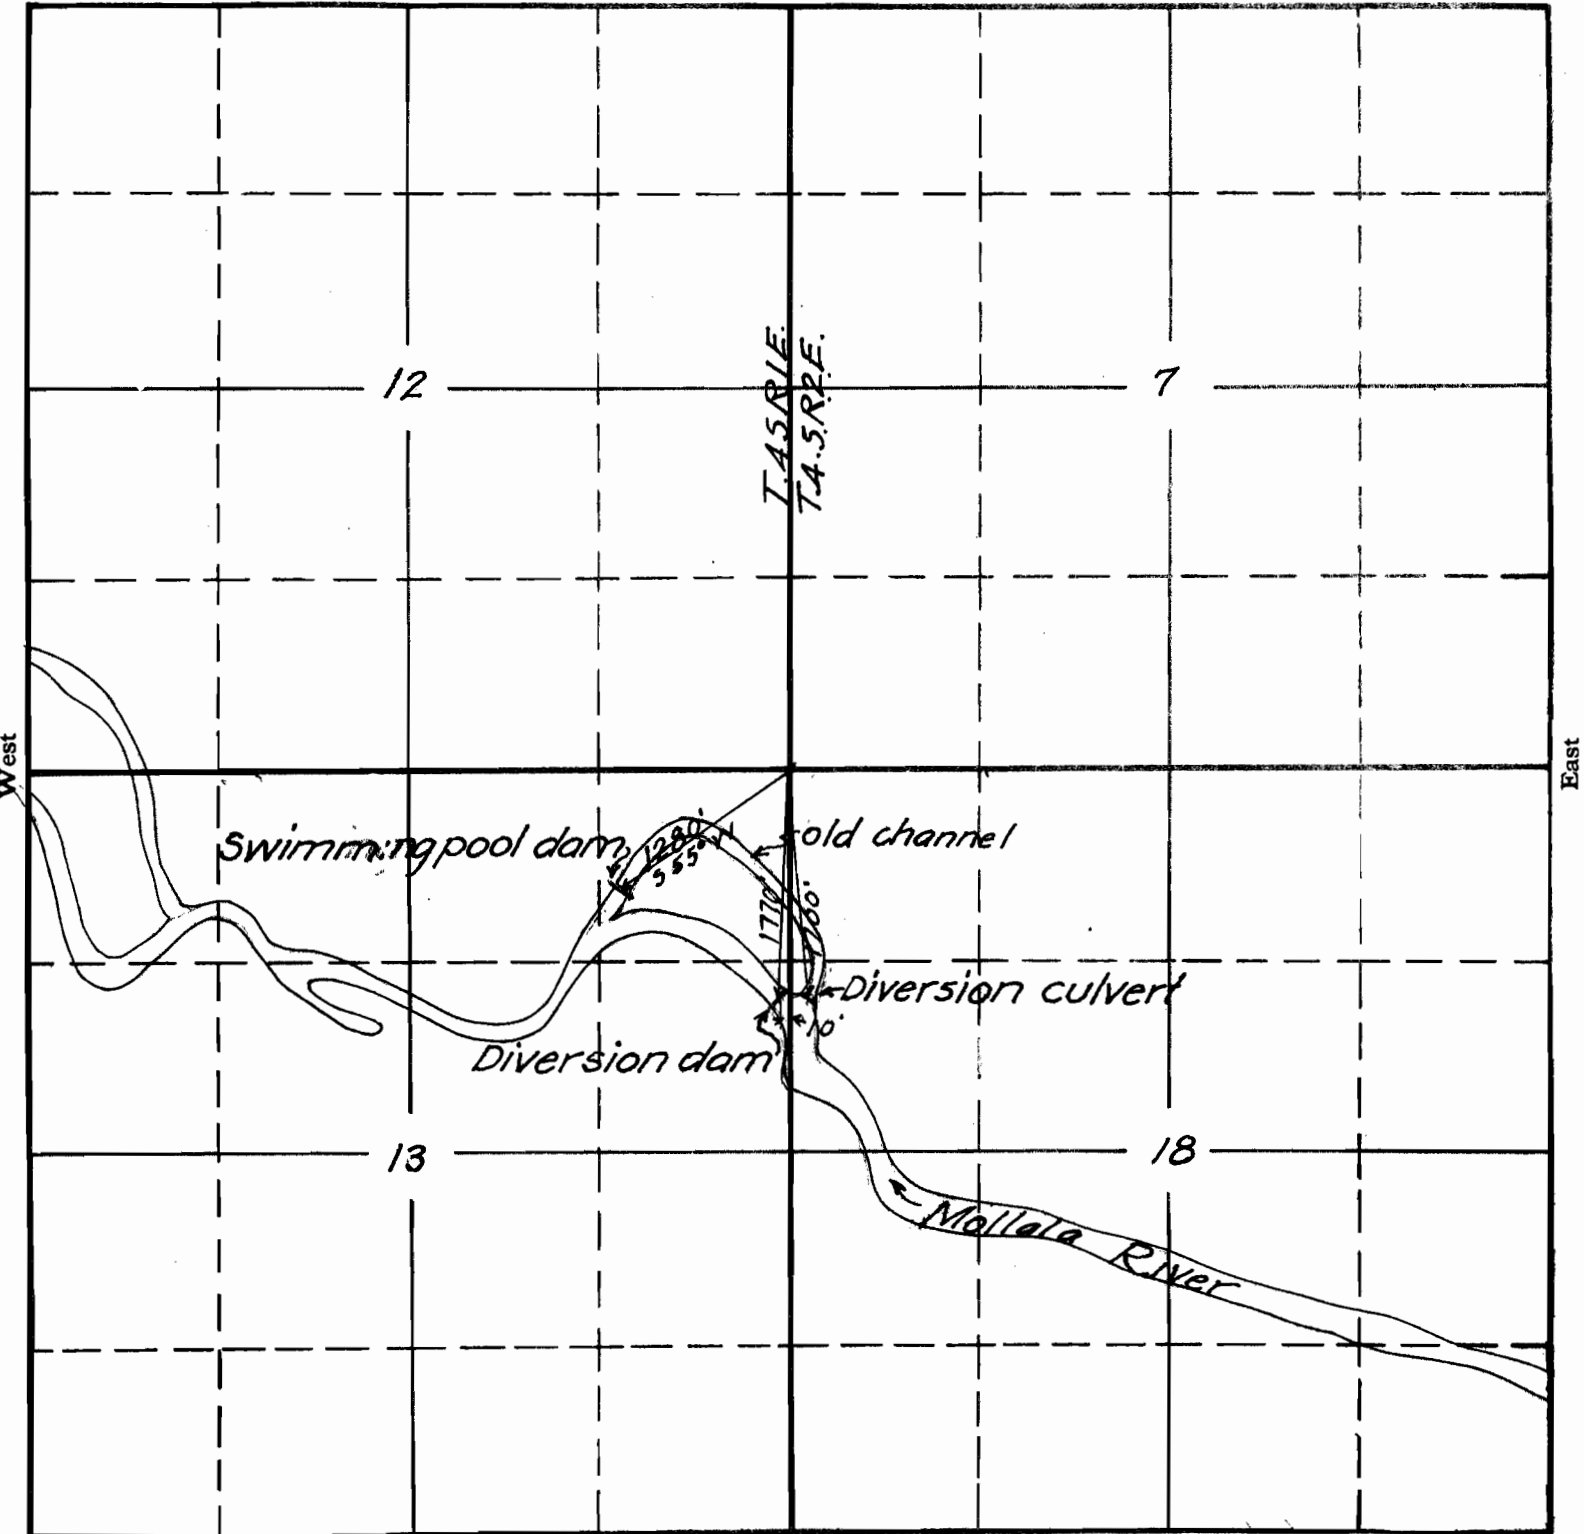

South

OK-2-29-16410  
 APPLICATION No. 16410  
 PERMIT No. 12219