


SECTION

18

TOWNSHIP 385, RANGE 8W, W. M.

North

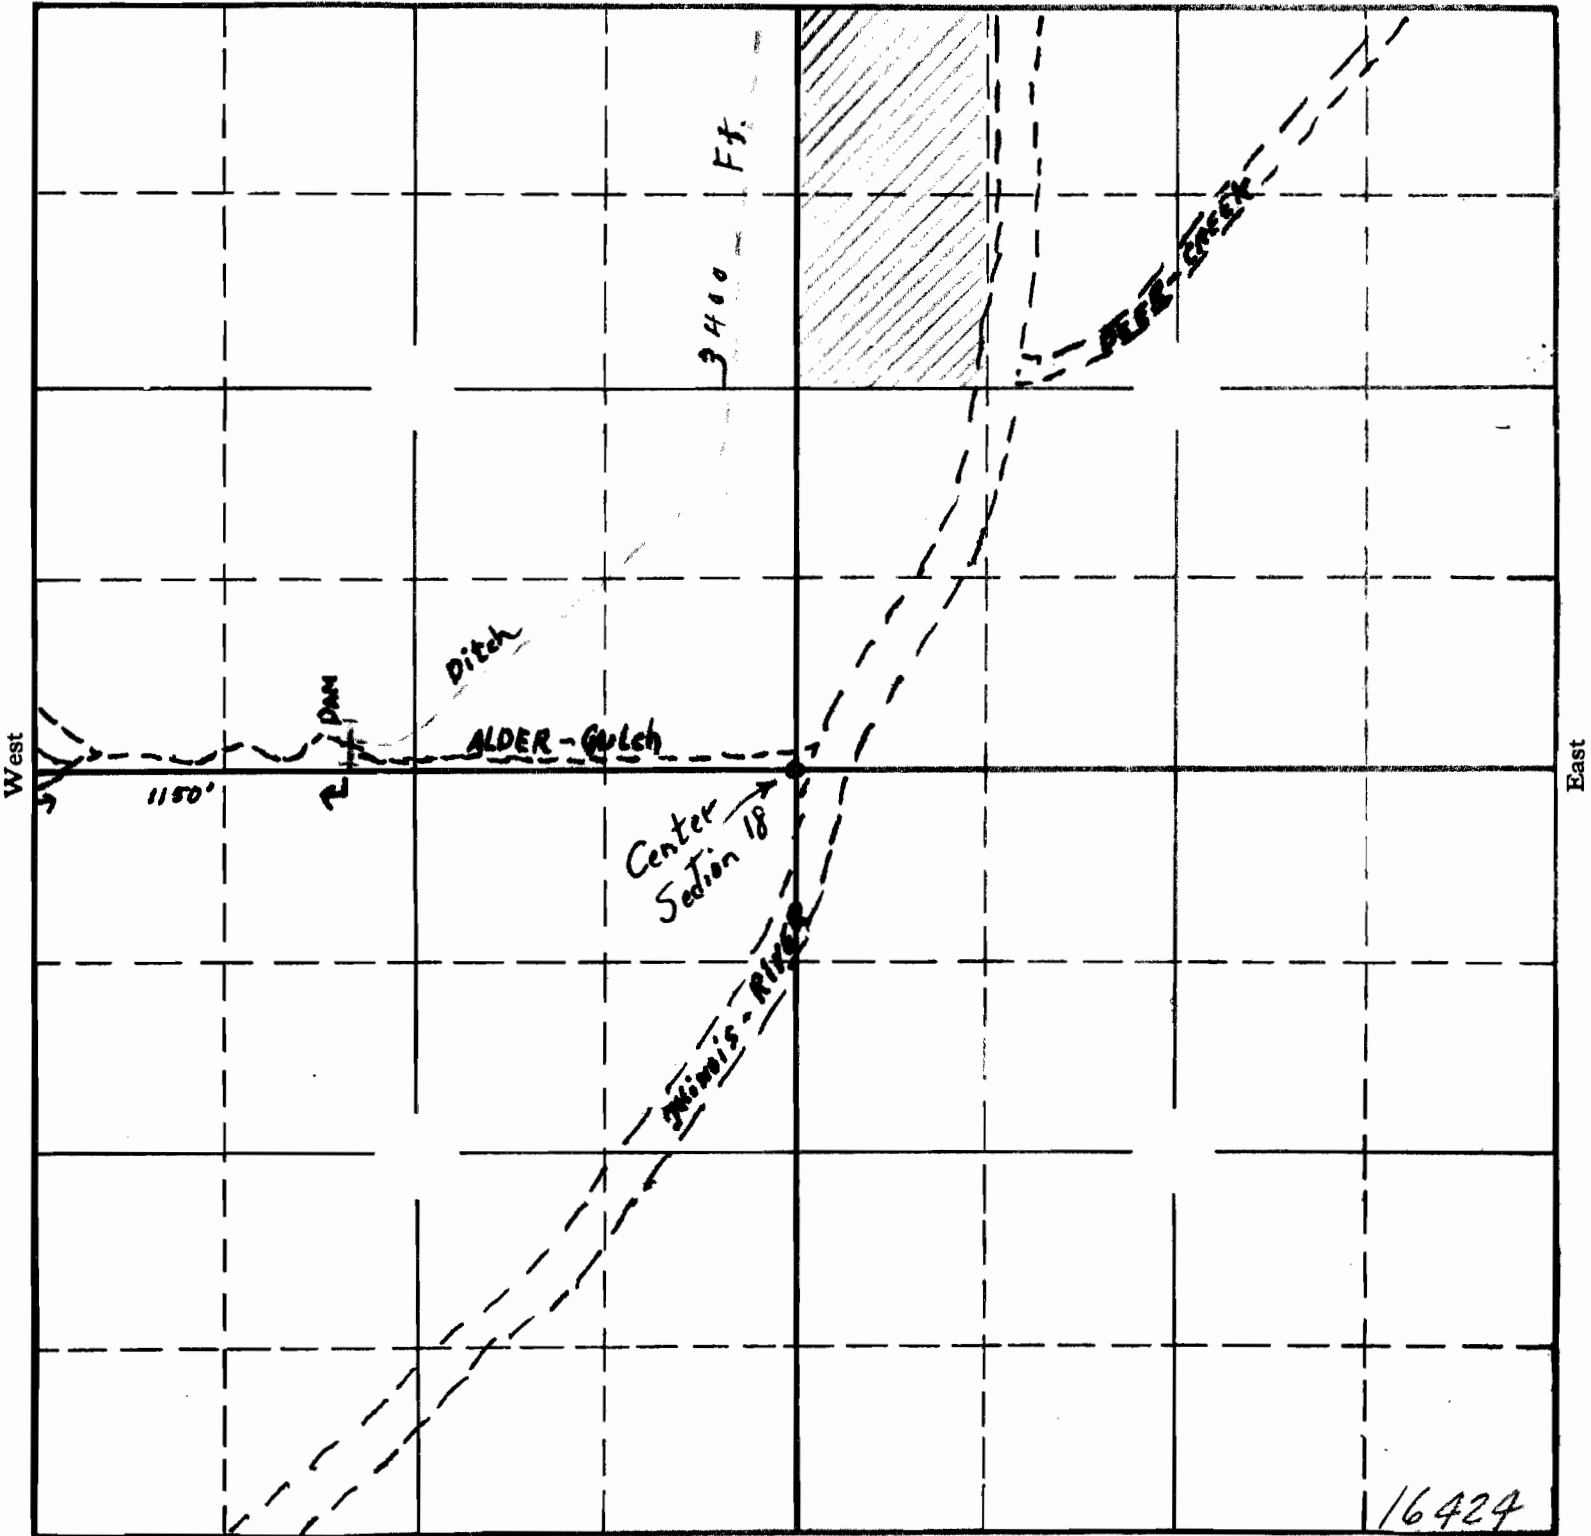

South

16424

APPLICATION No. 16424

PERMIT No. 12226