


SECTION

Permit: S 12235  
Volume: 1A  
Strm: UNN STR  
Trib: ROGUE R  
Priority: 6/27/36

TOWNSHIP 35 S, RANGE 81

North

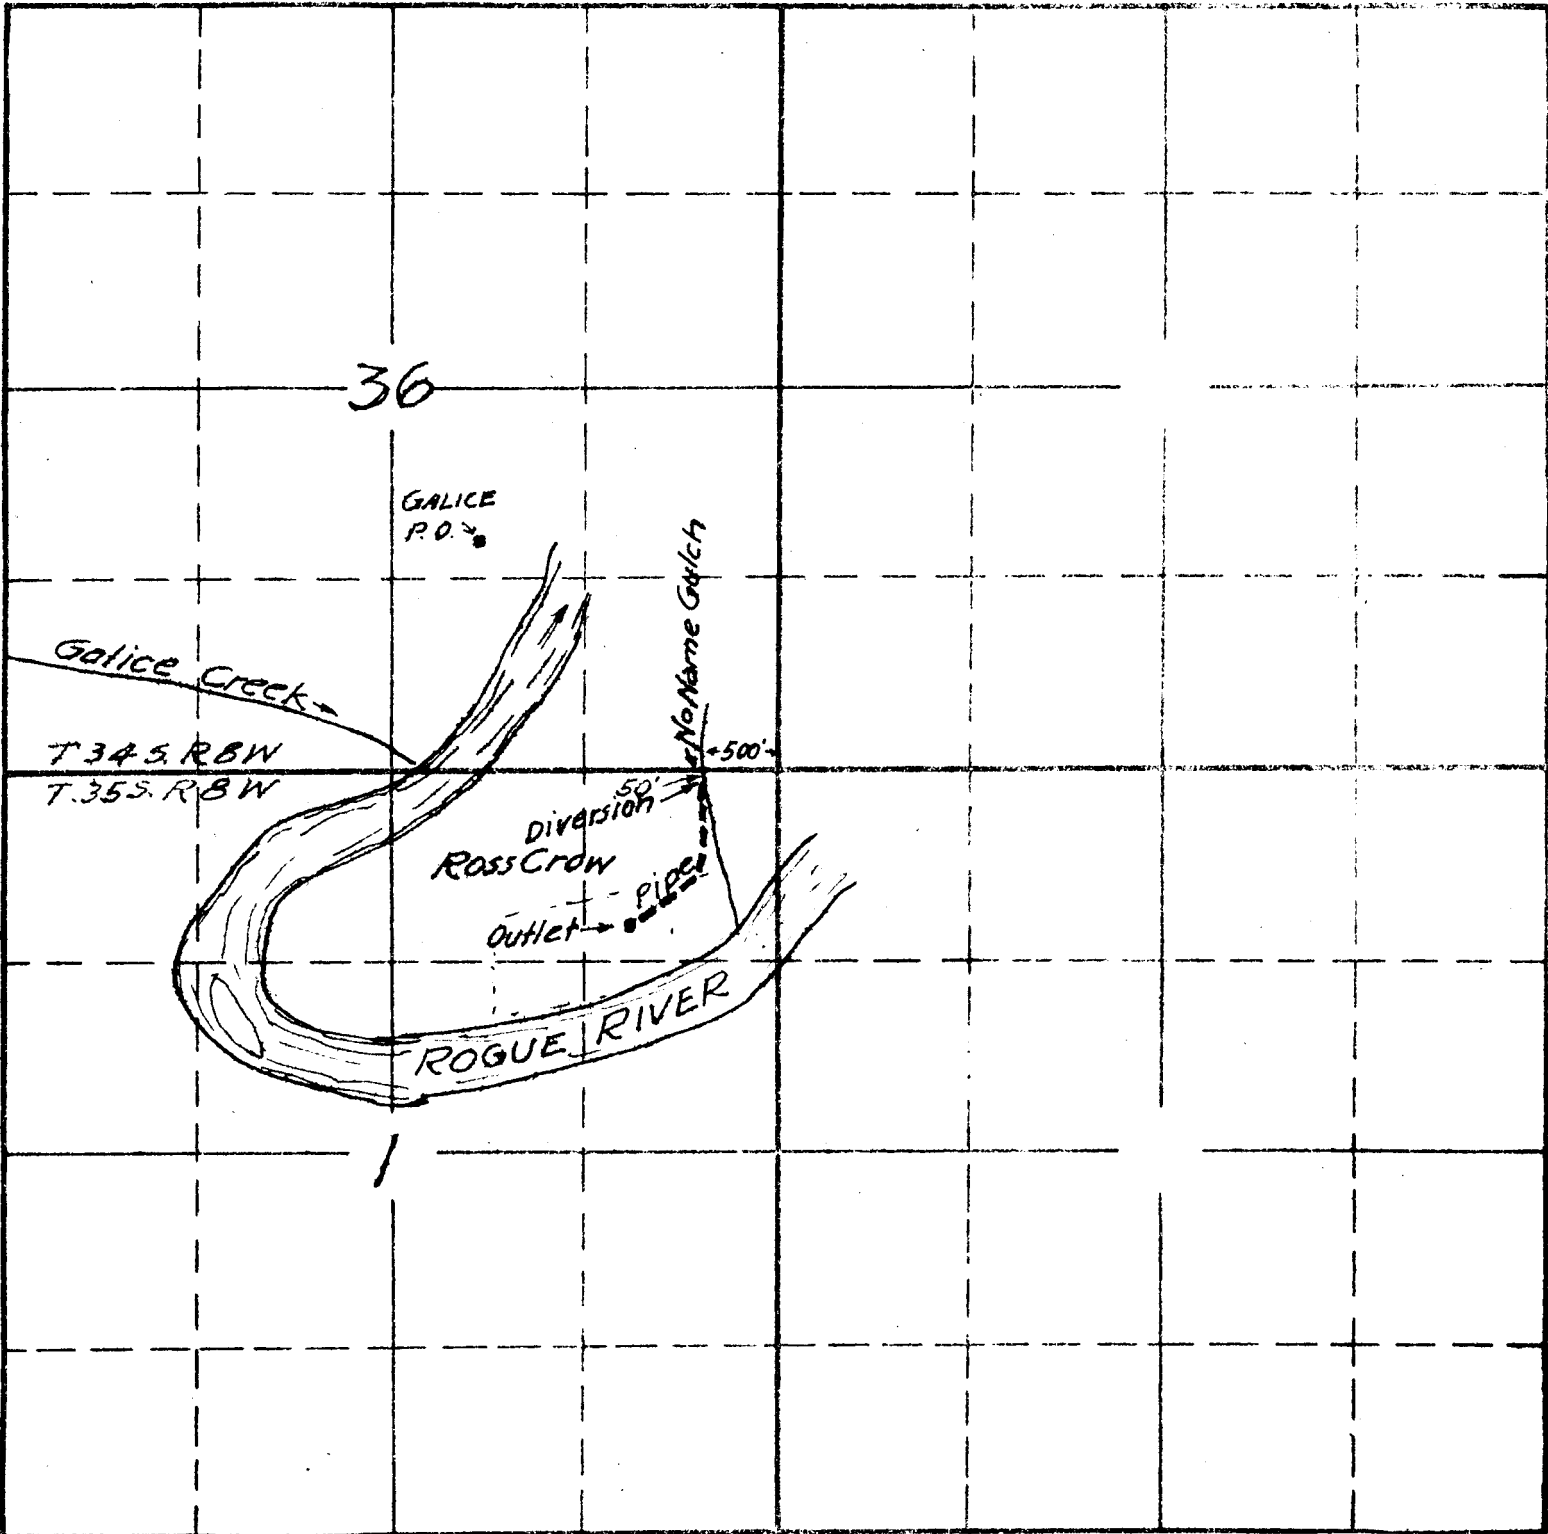

South

APPLICATION No. 16436  
PERMIT No. 12235

June 1936