


SECTION

TOWNSHIP 25, RANGE 42E, W. M.

North

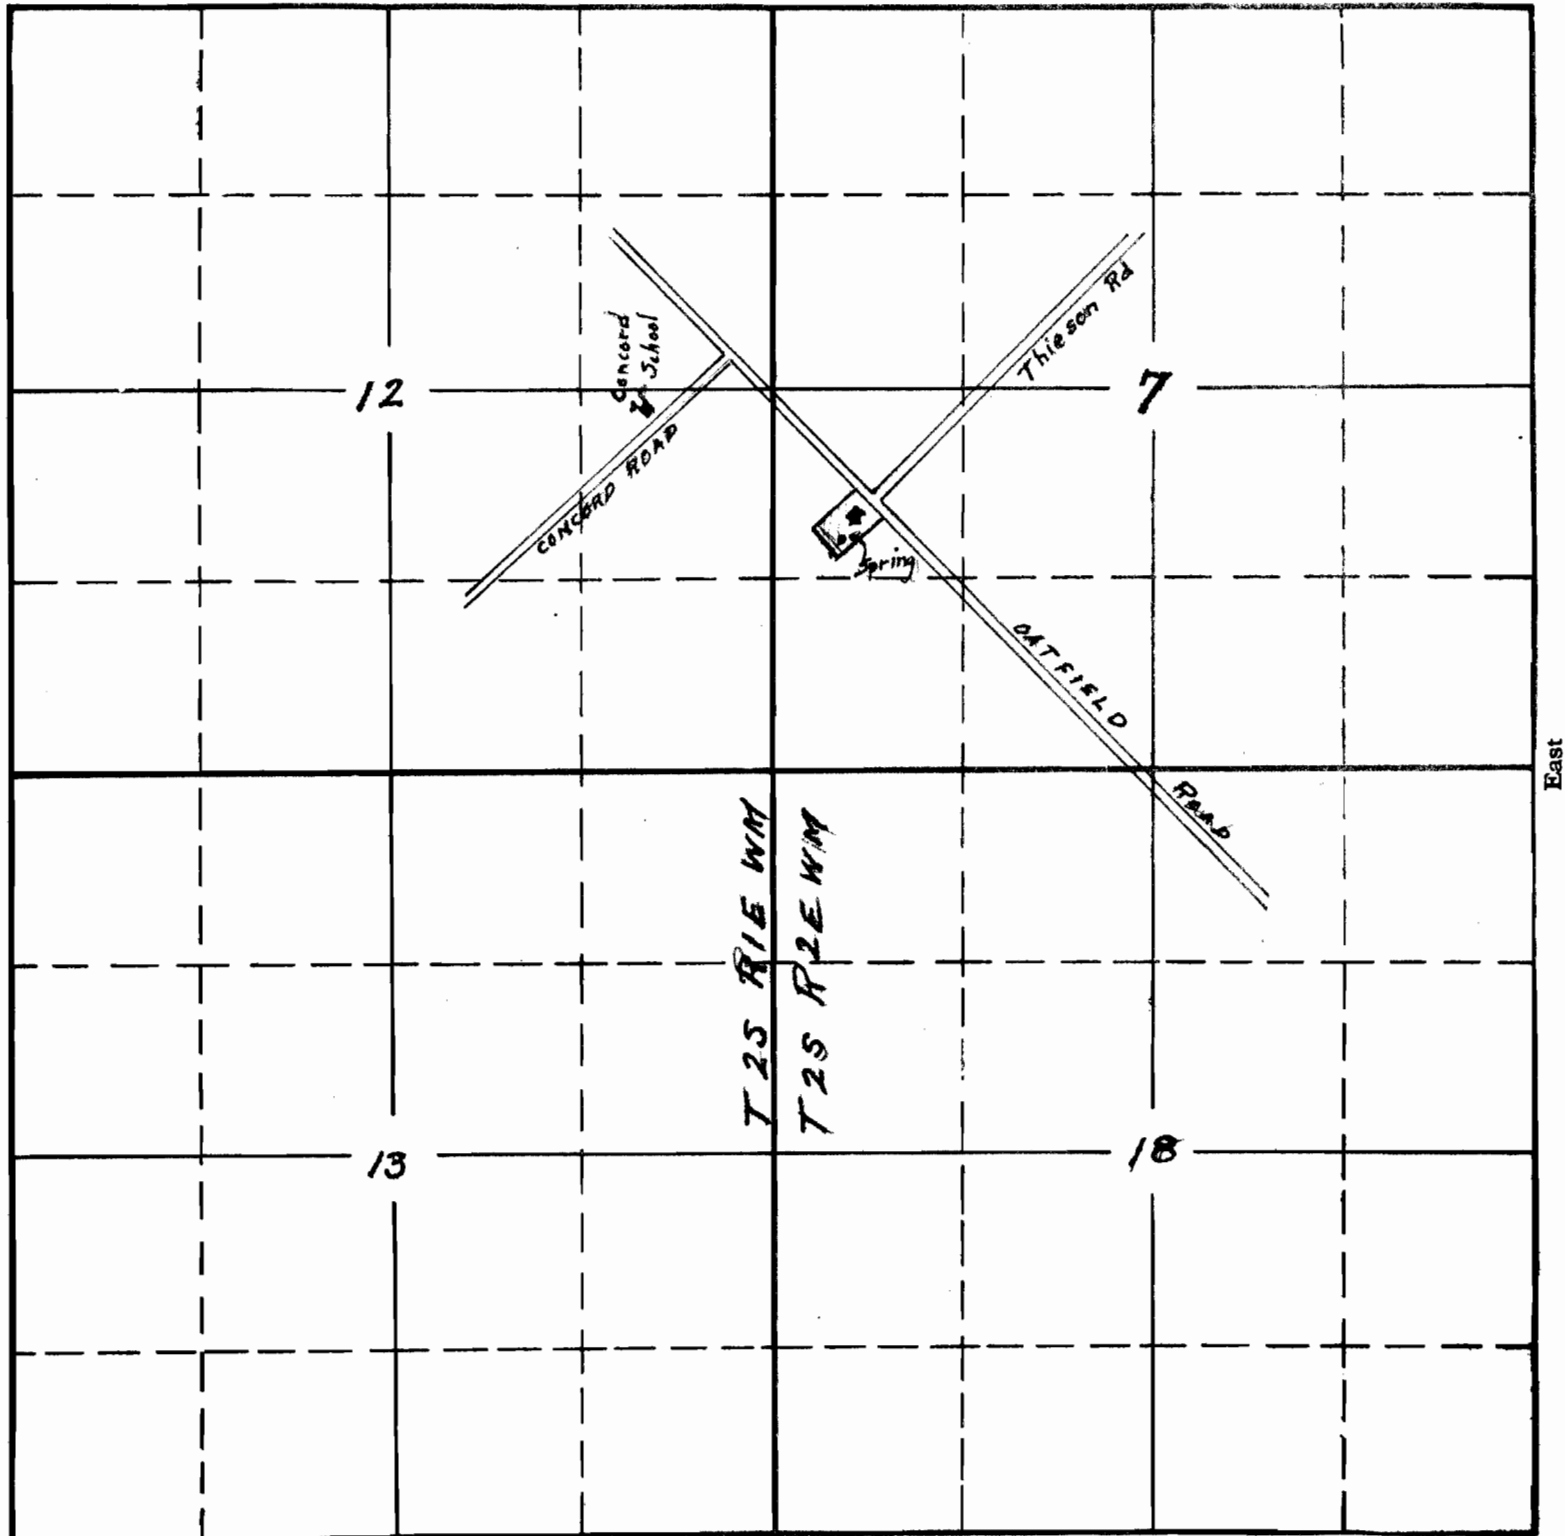

South

2-76B-16440-OK
APPLICATION No. 16440
PERMIT No. 12238