


T. 36 S., R. 5 W., W.M.

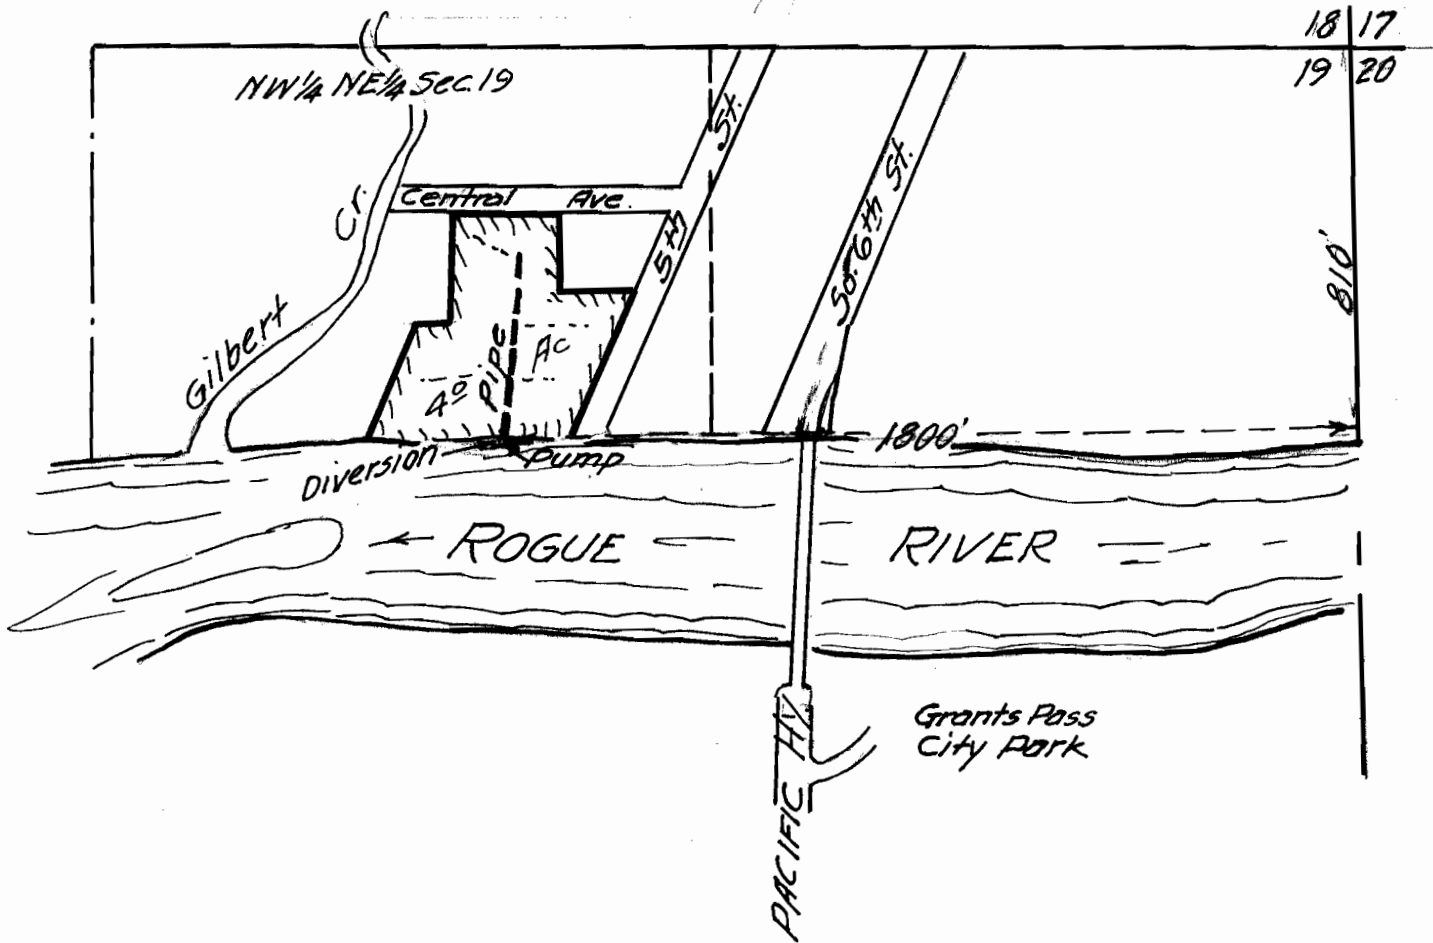

App. No. 16441
Per. No. 12239

Earl C. Horrah
Scale 400' = 1" June 1936
Application No.
Permit No.