


Permit: S 12247
Volume: 6B
Strm: MULE G
Trib: W FK WILLIAMS CR
Priority: 7/26/36

SECTION

TOWNSHIP 38-39 S. RANGE 5 W

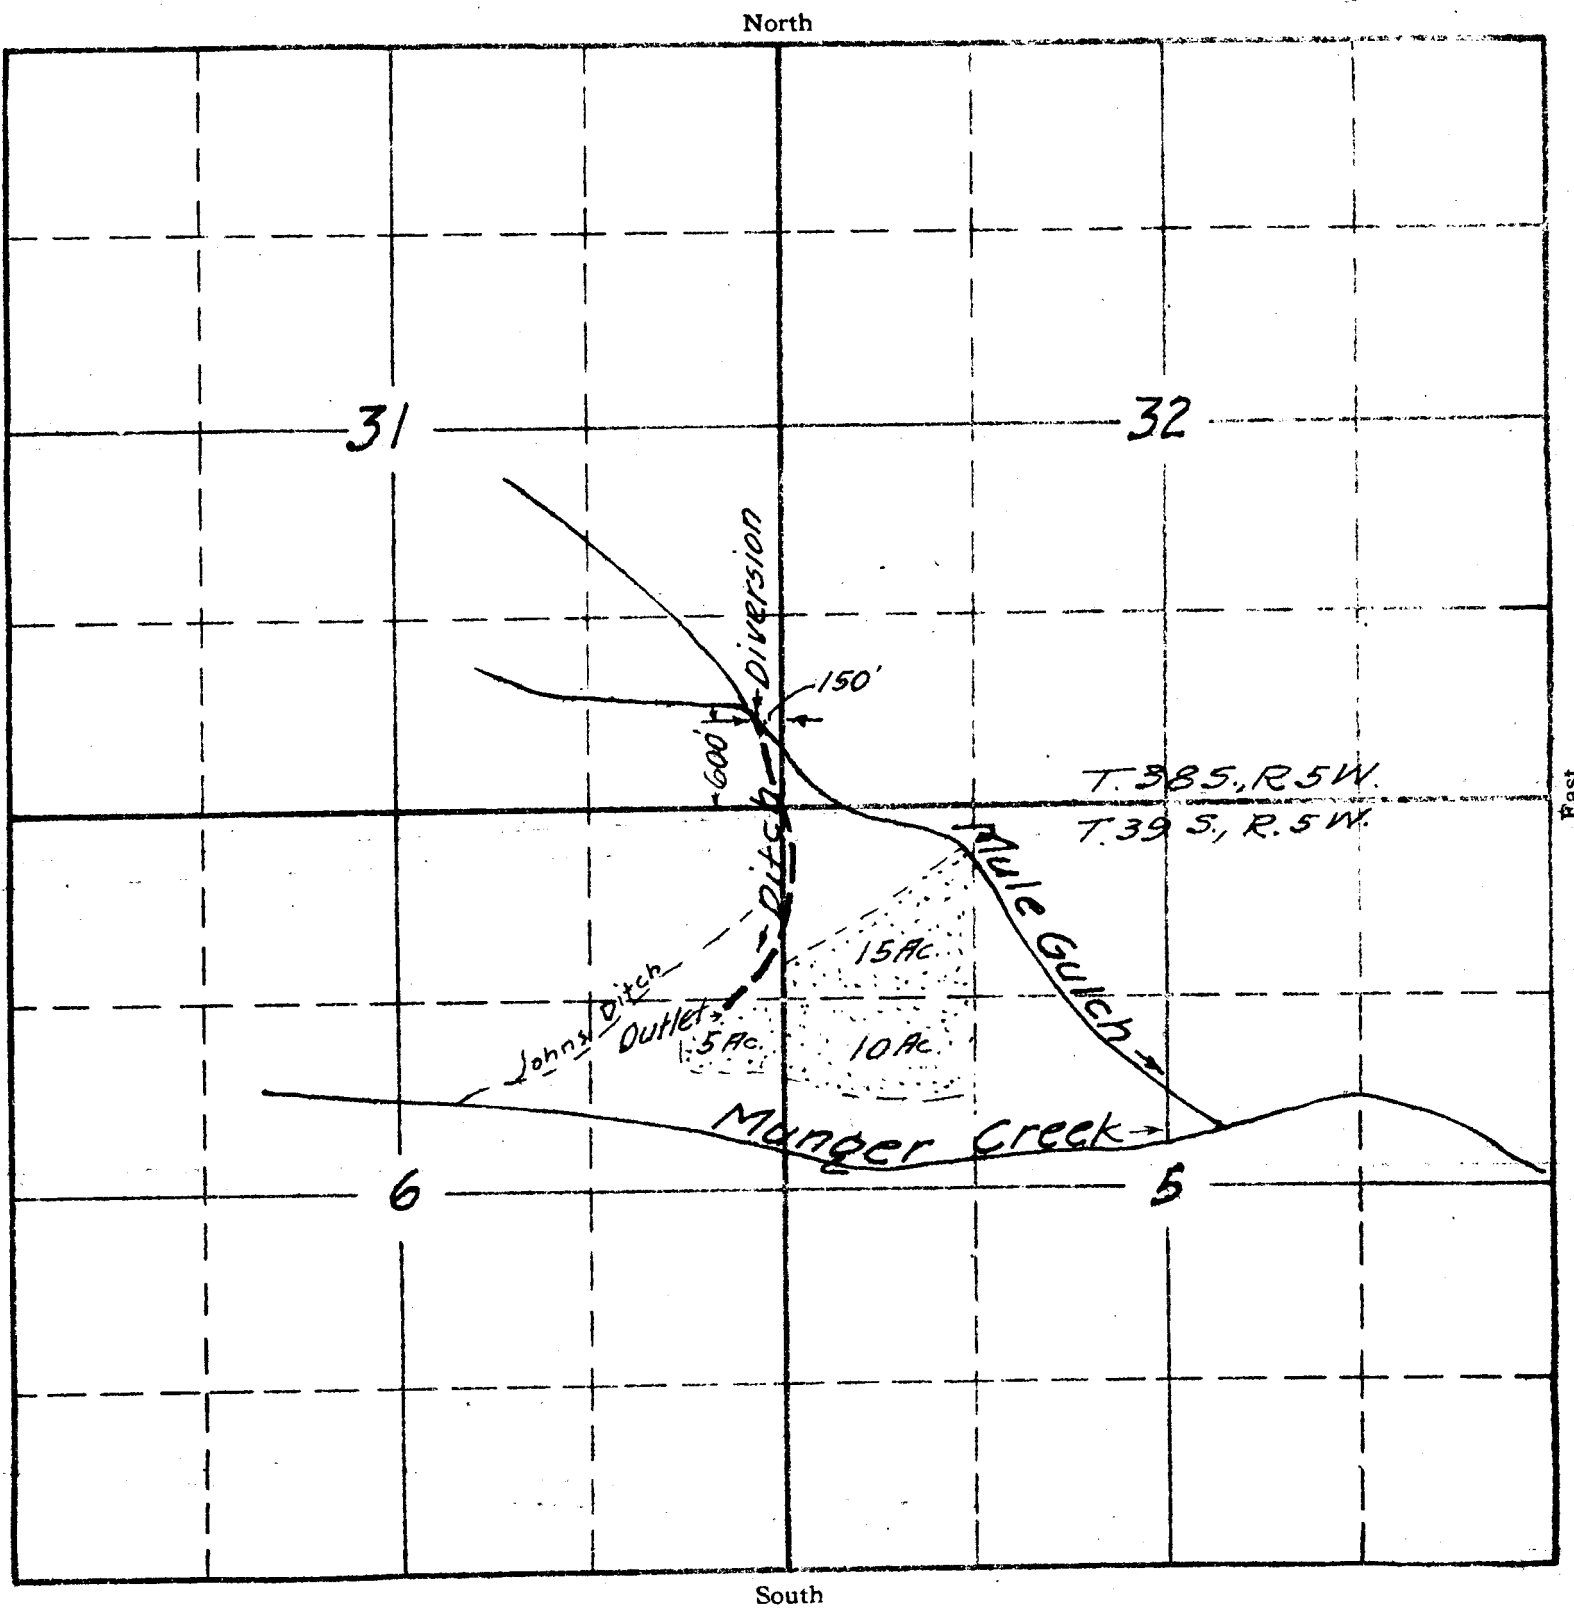

Charley F. Young
July 1936

APPLICATION No. 16449
PERMIT No. 12247

W-99

P12247
V. 6B
MARBLES/MULES
7-6-36


39-5-5

T.39S.R.5 W. W.M.

RECEIVED

SEP 25 1981

WM. DIST. 14
GRANTS PASS, ORE.

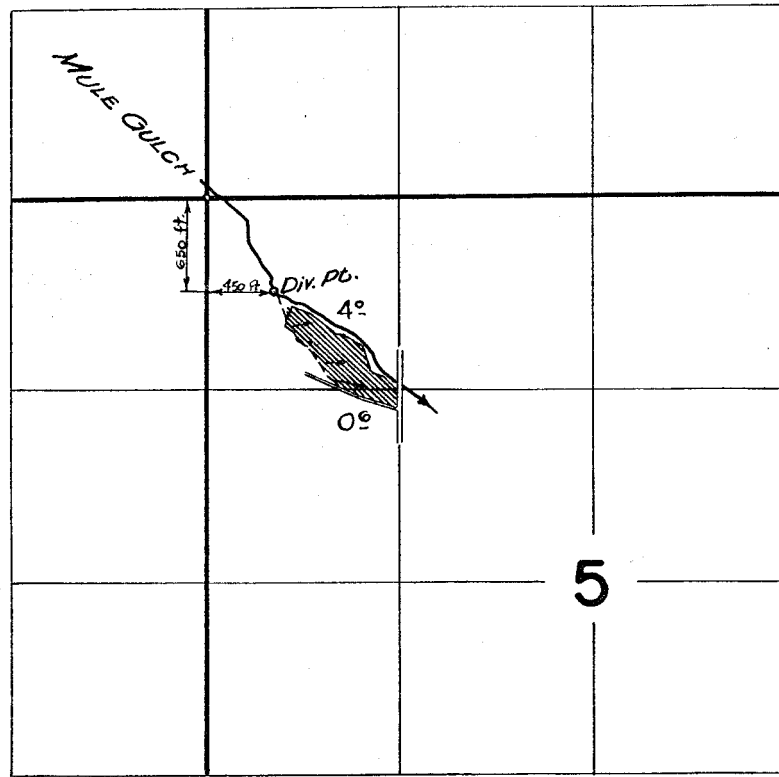

FINAL PROOF SURVEY
UNDER

Transfer No. W-99

Application No. _____ Permit No. _____
IN NAME OF

CHARLES A. WOOD

Surveyed July 19, 1965, by *R. Jackson*