


SECTION

TOWNSHIP 75 , RANGE //W , W. M.

North

West

East

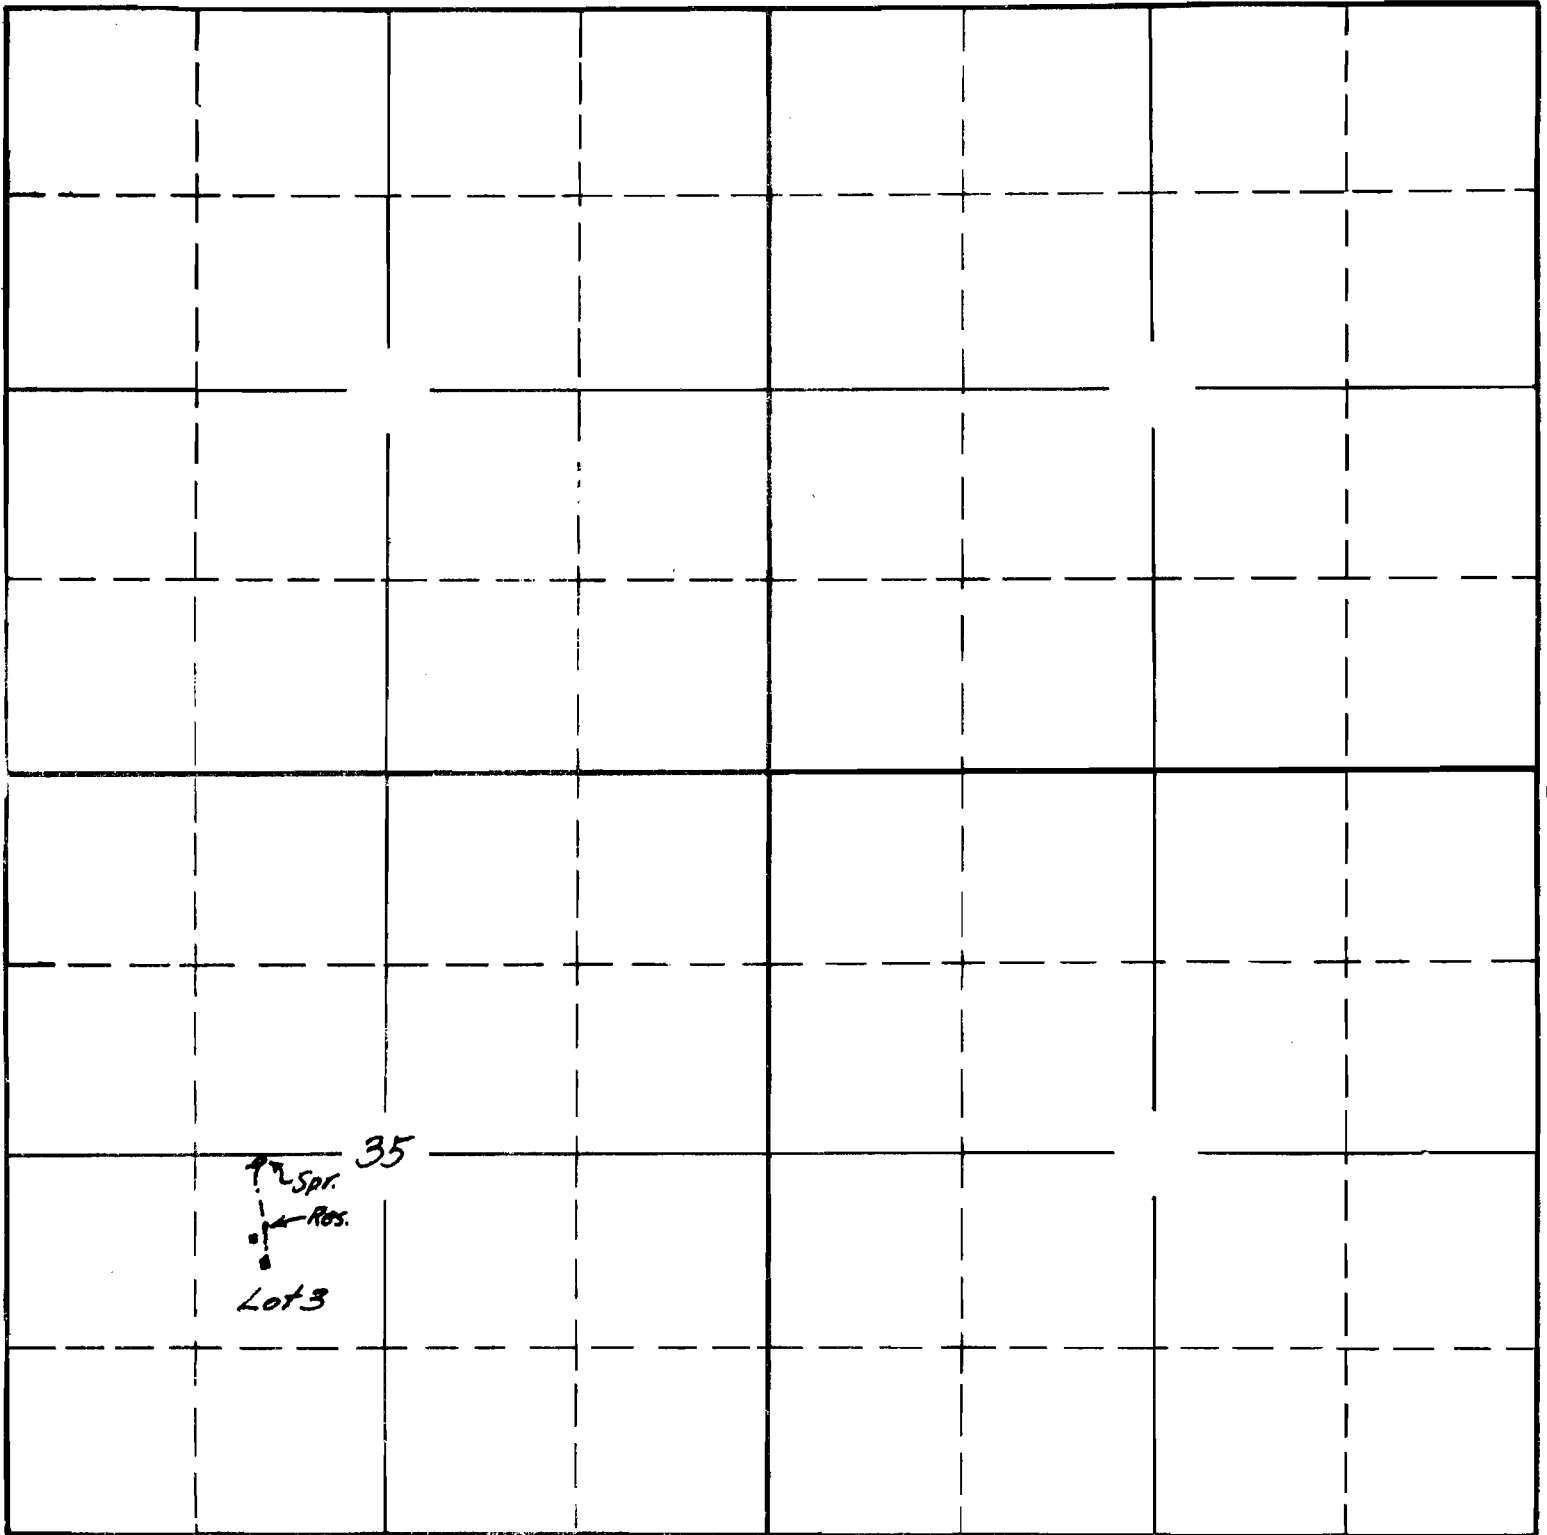

Surveyed June 26, 1940 CAG.

South

APPLICATION No. 16450
PERMIT No. 12248