


SECTION

TOWNSHIP 25, RANGE 2E, W. M.

North

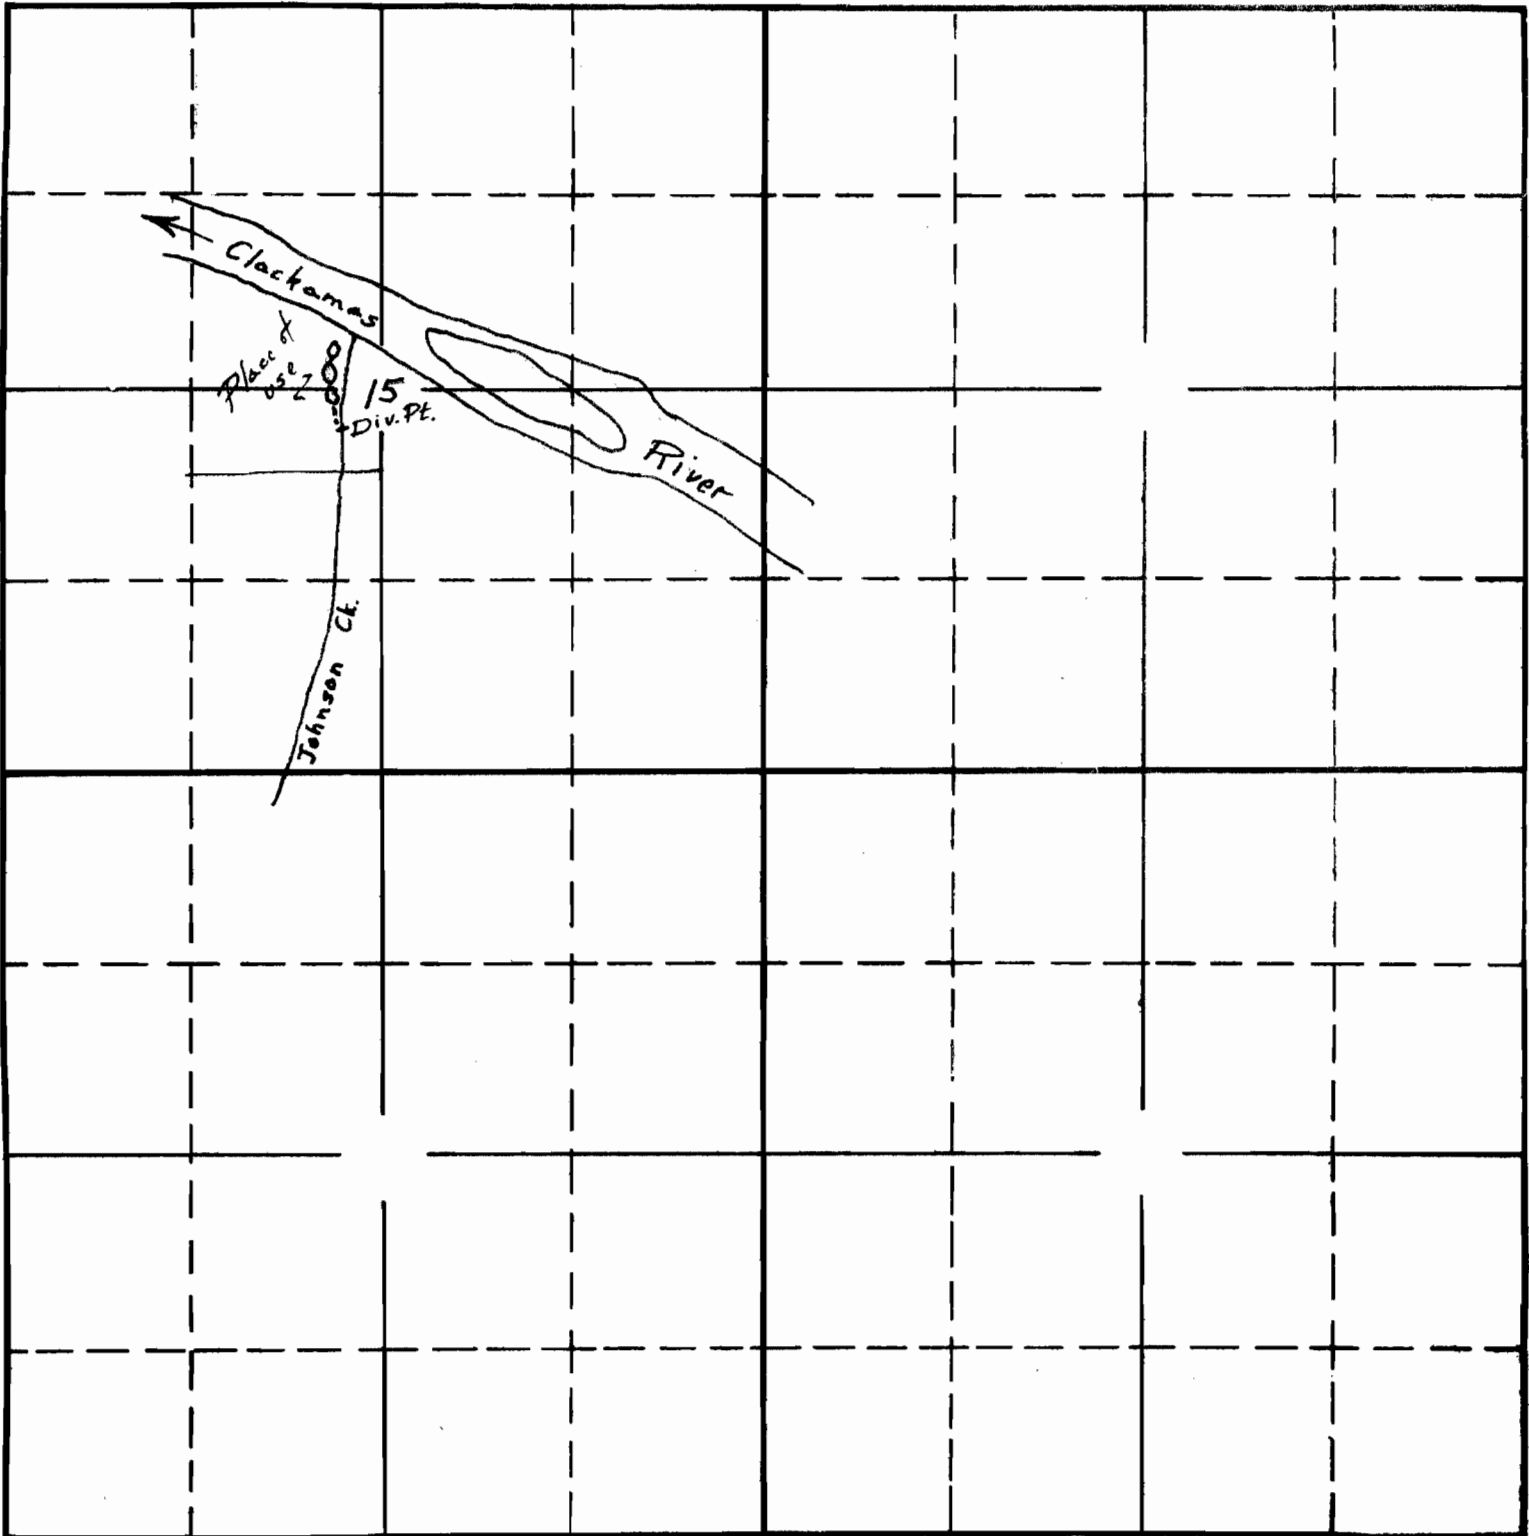


South

2-10-16460-OK
APPLICATION No. 16460
PERMIT No. 12257

SECTION

TOWNSHIP 25, RANGE 2E, W. M.

North

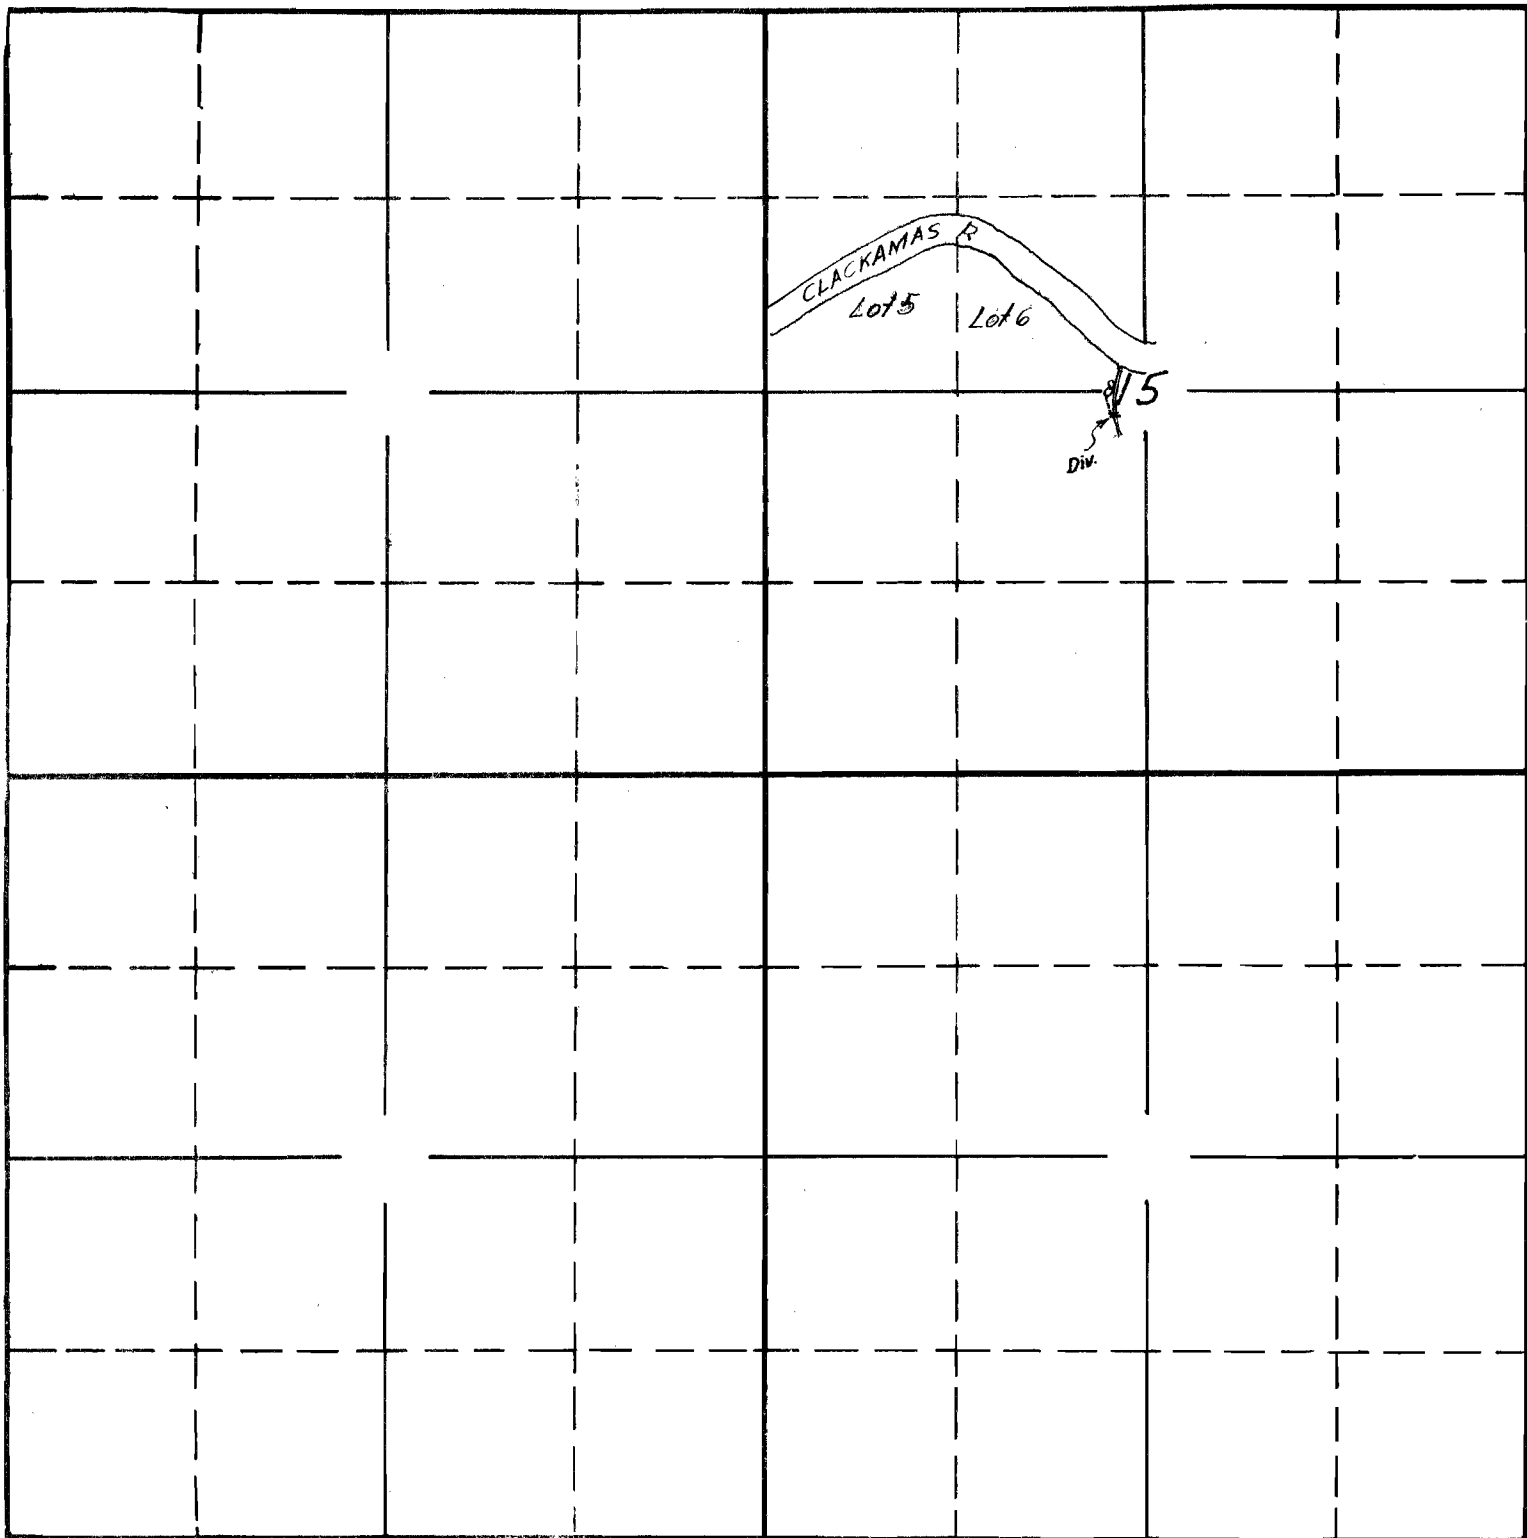

South

APPLICATION No. 16460
PERMIT No. 12257