


SECTION

TOWNSHIP 15, RANGE 2E, W. M.

North

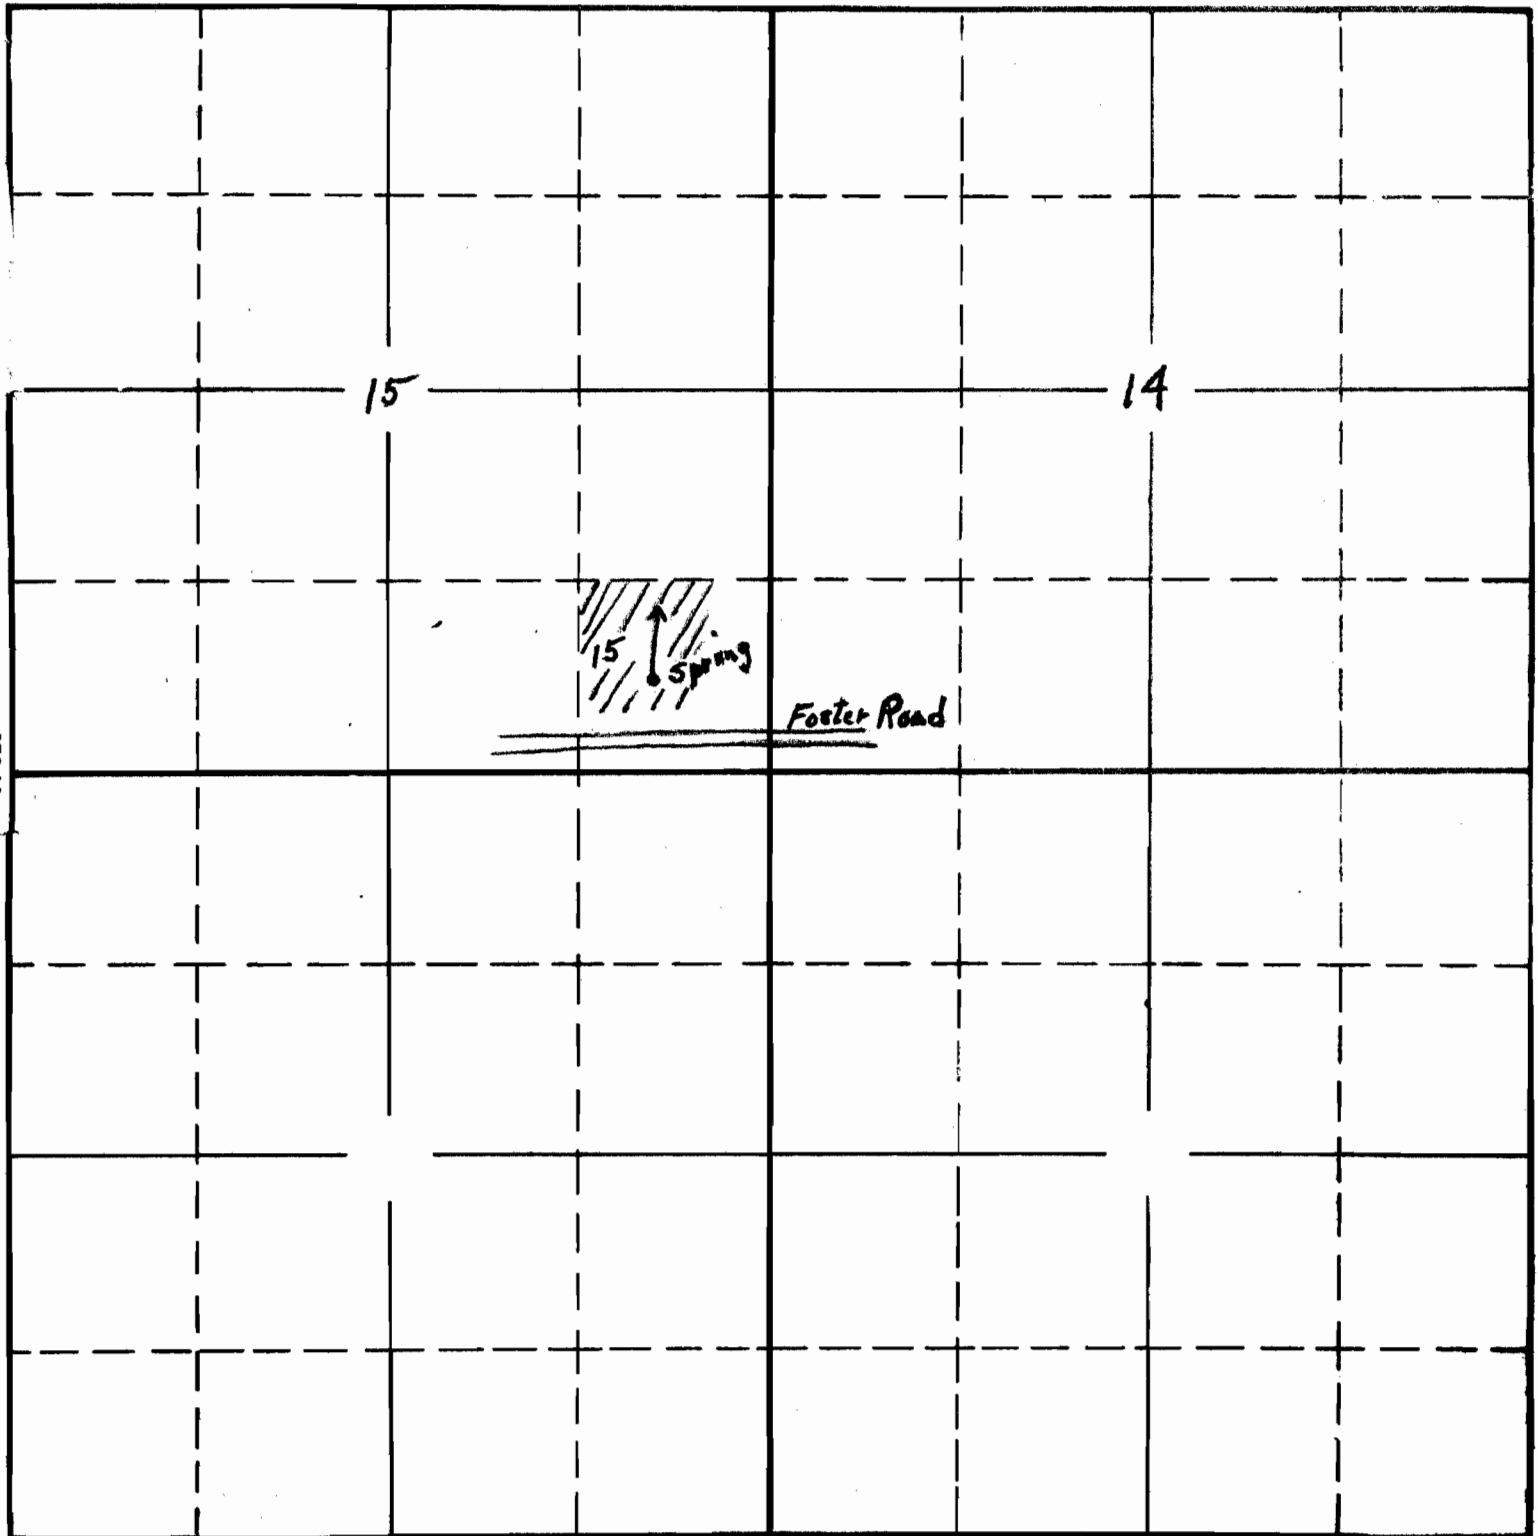

South

U. Zenger -

2-76-B-16520
APPLICATION No. 16520
PERMIT No. 12317

T15R2E

16520

↑
See Cor.

15

Furey May be able to find this Cor

OWR RY.

Foster Road

U. ZENGER

122

← or try this Cor.

SECTION

TOWNSHIP 15, RANGE 2E, W. M.

North

15

14



Foster Road

West

East

South

U. Zenger

2-76-B-16520
APPLICATION No. 16520

PERMIT No. 12317