


TOWNSHIP 22 S, RANGE 10 W, W. M.

North

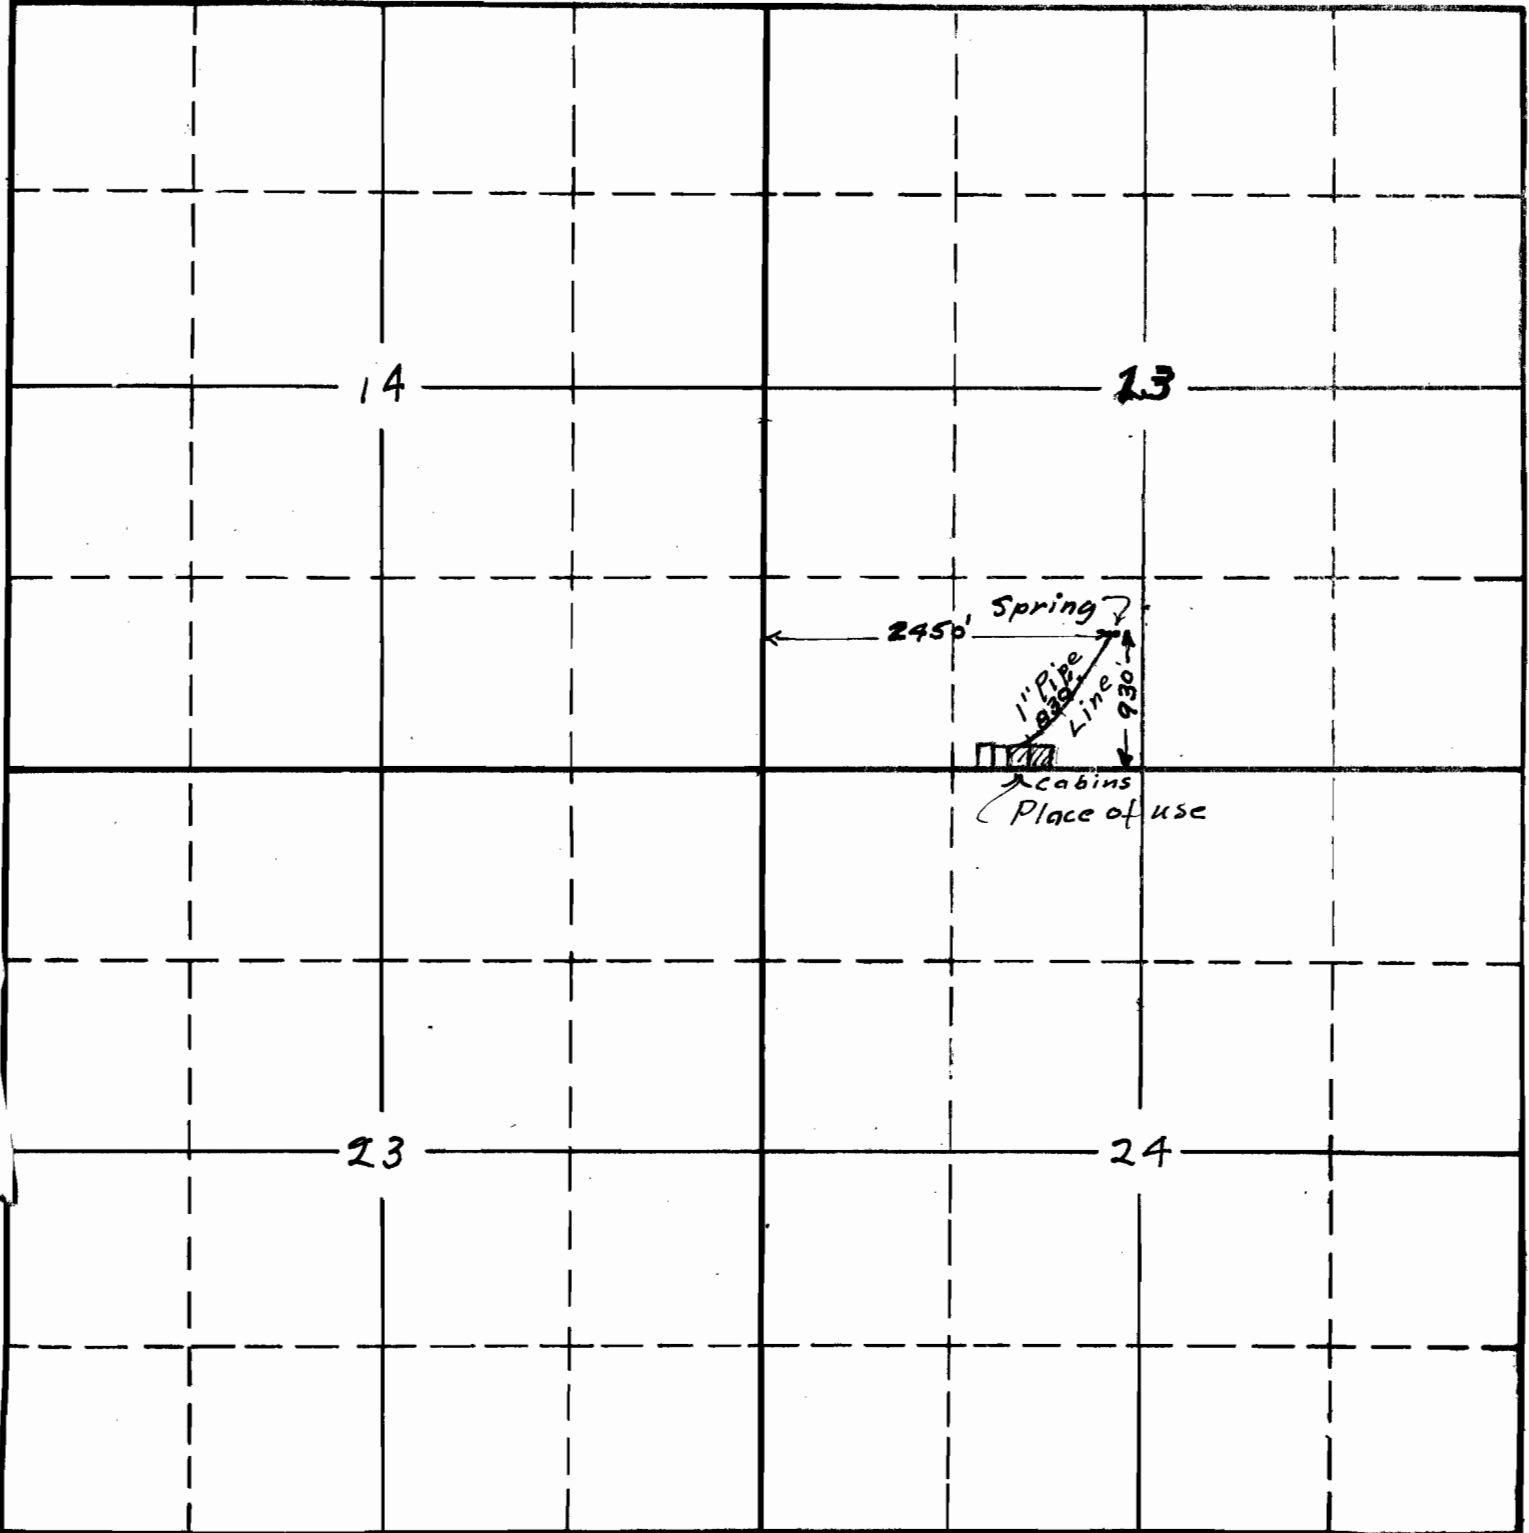

West

East

South

APPLICATION No. 16565

PERMIT No. 12349