


TOWNSHIP 15-S. RANGE 24 E. W. M.

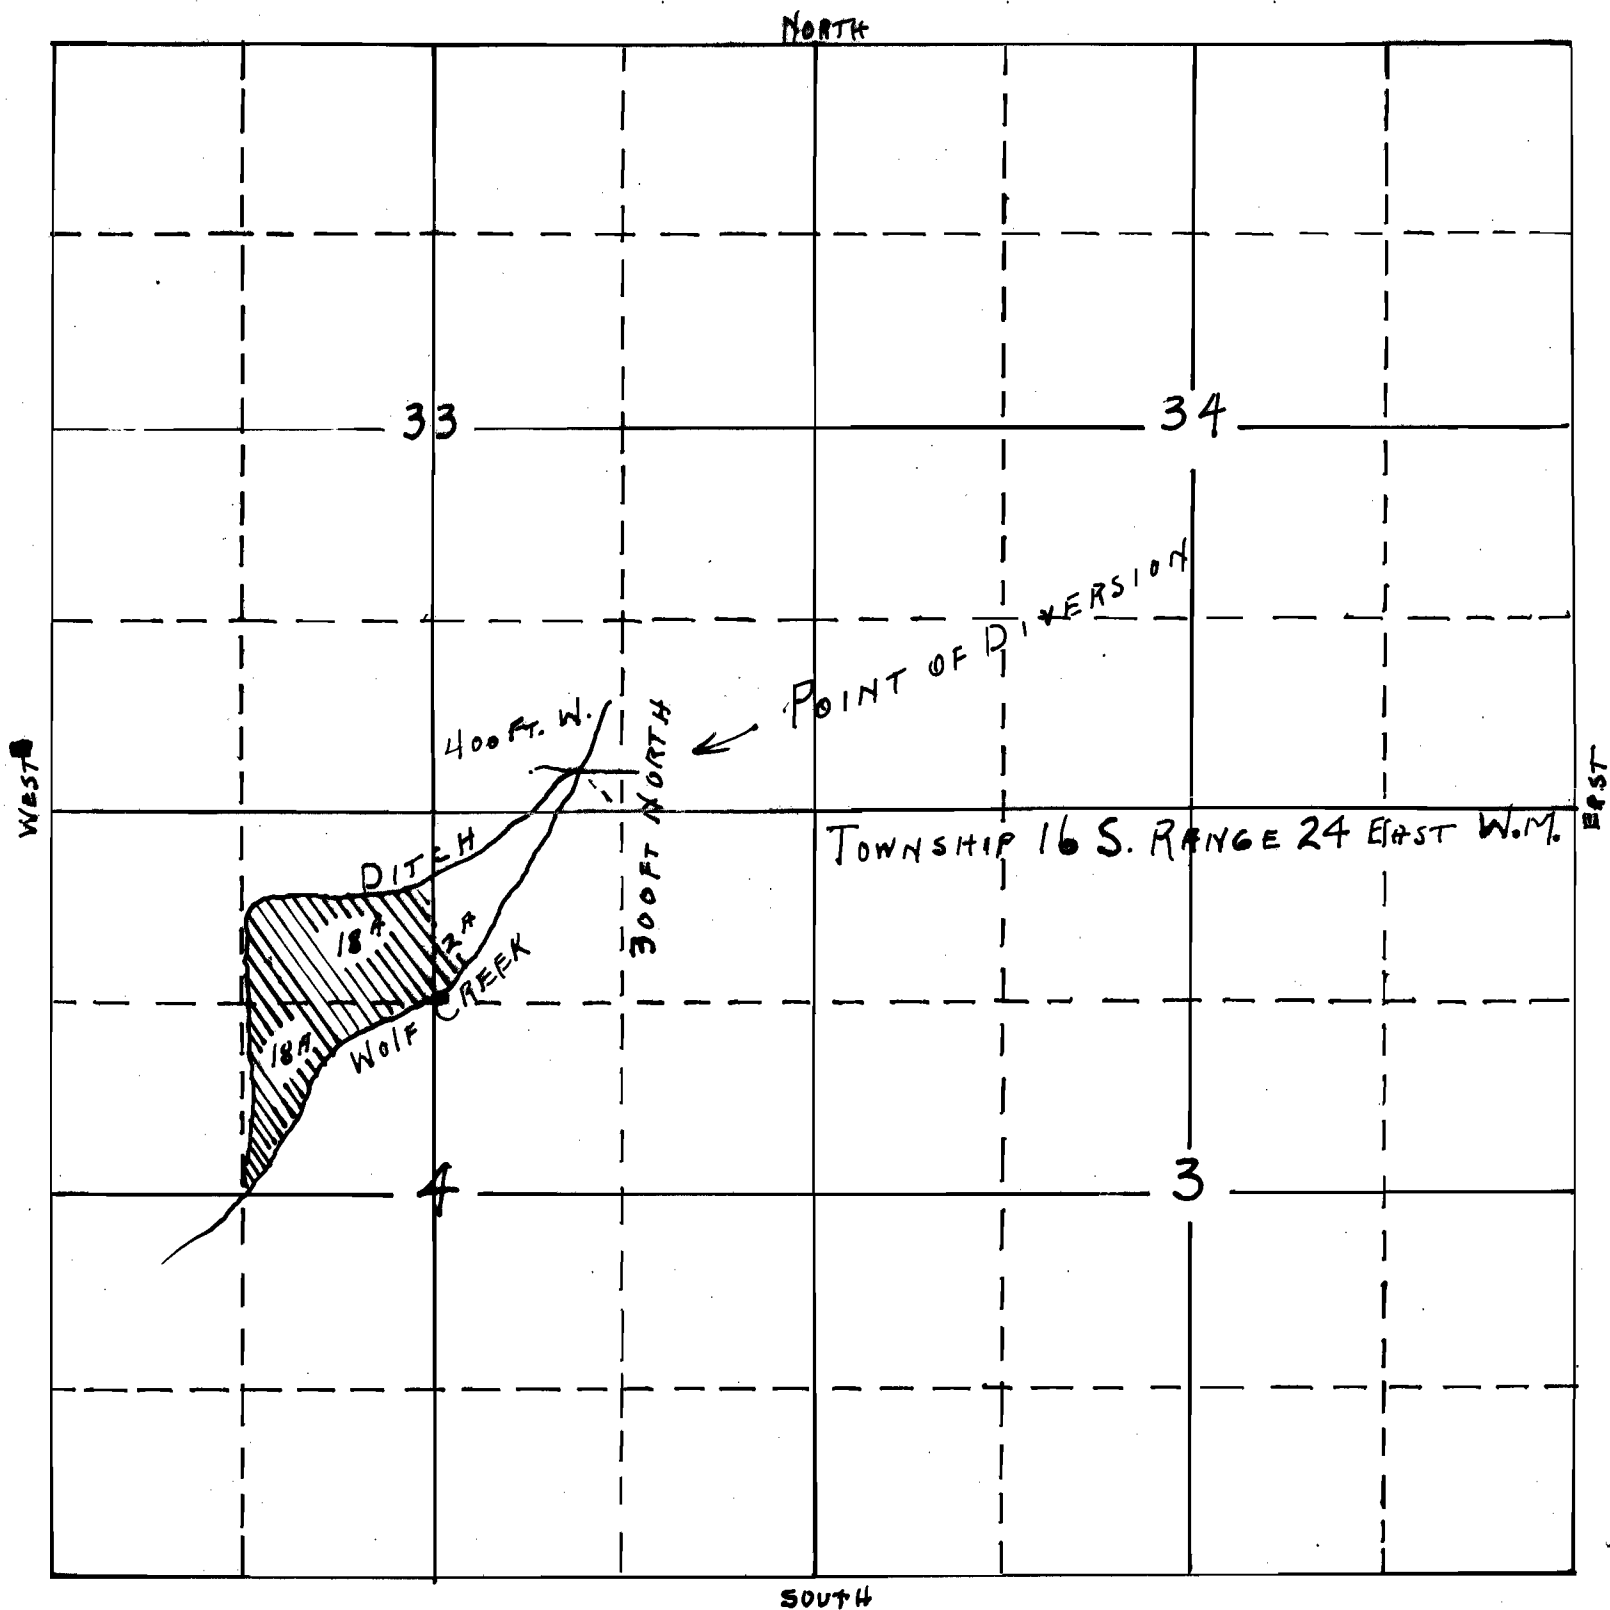

APPLICATION No 16569
PERMIT No 12350

5-6-1656


SECTION

158
TOWNSHIP 16S, RANGE 24E, W. M.

North

West

East

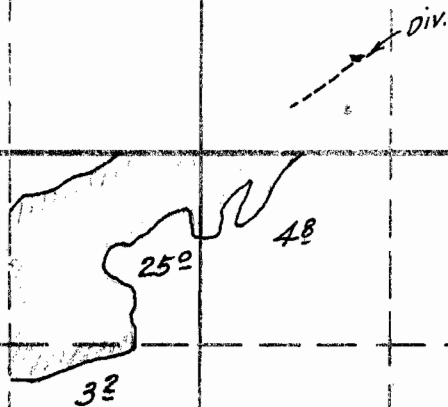

Surveyed Sept 25 1940 C.A.B.

South

APPLICATION No. 16569

PERMIT No. 12350