


SECTION

TOWNSHIP 55, RANGE 2E, W. M.

North

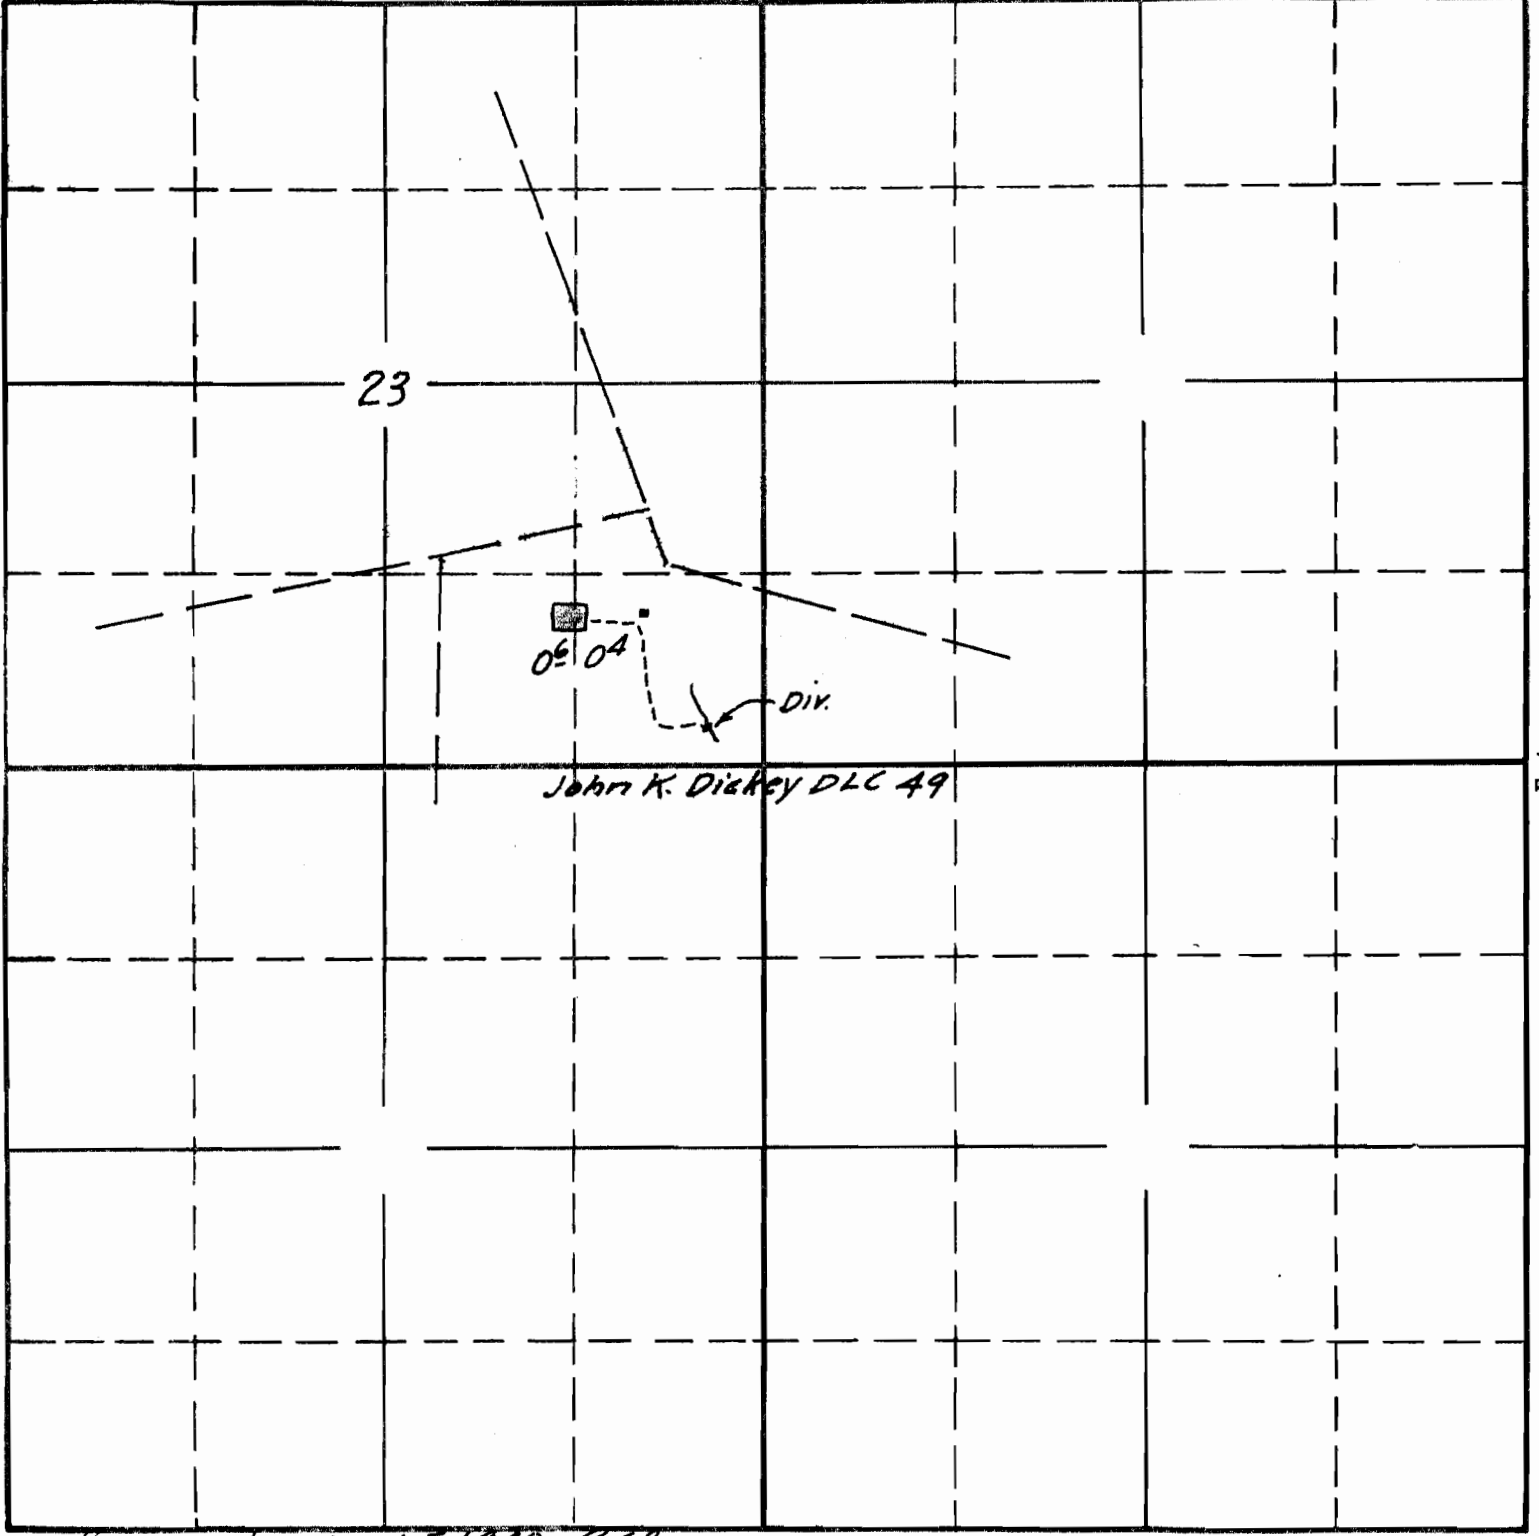

23

06.04

Div.

John K. Dickey DLC 49

Surveyed May 25 1940 EdB

South


APPLICATION No. 16581  
PERMIT No. 12955

SECTION

23

TOWNSHIP 55, RANGE 2E, W. M.

North

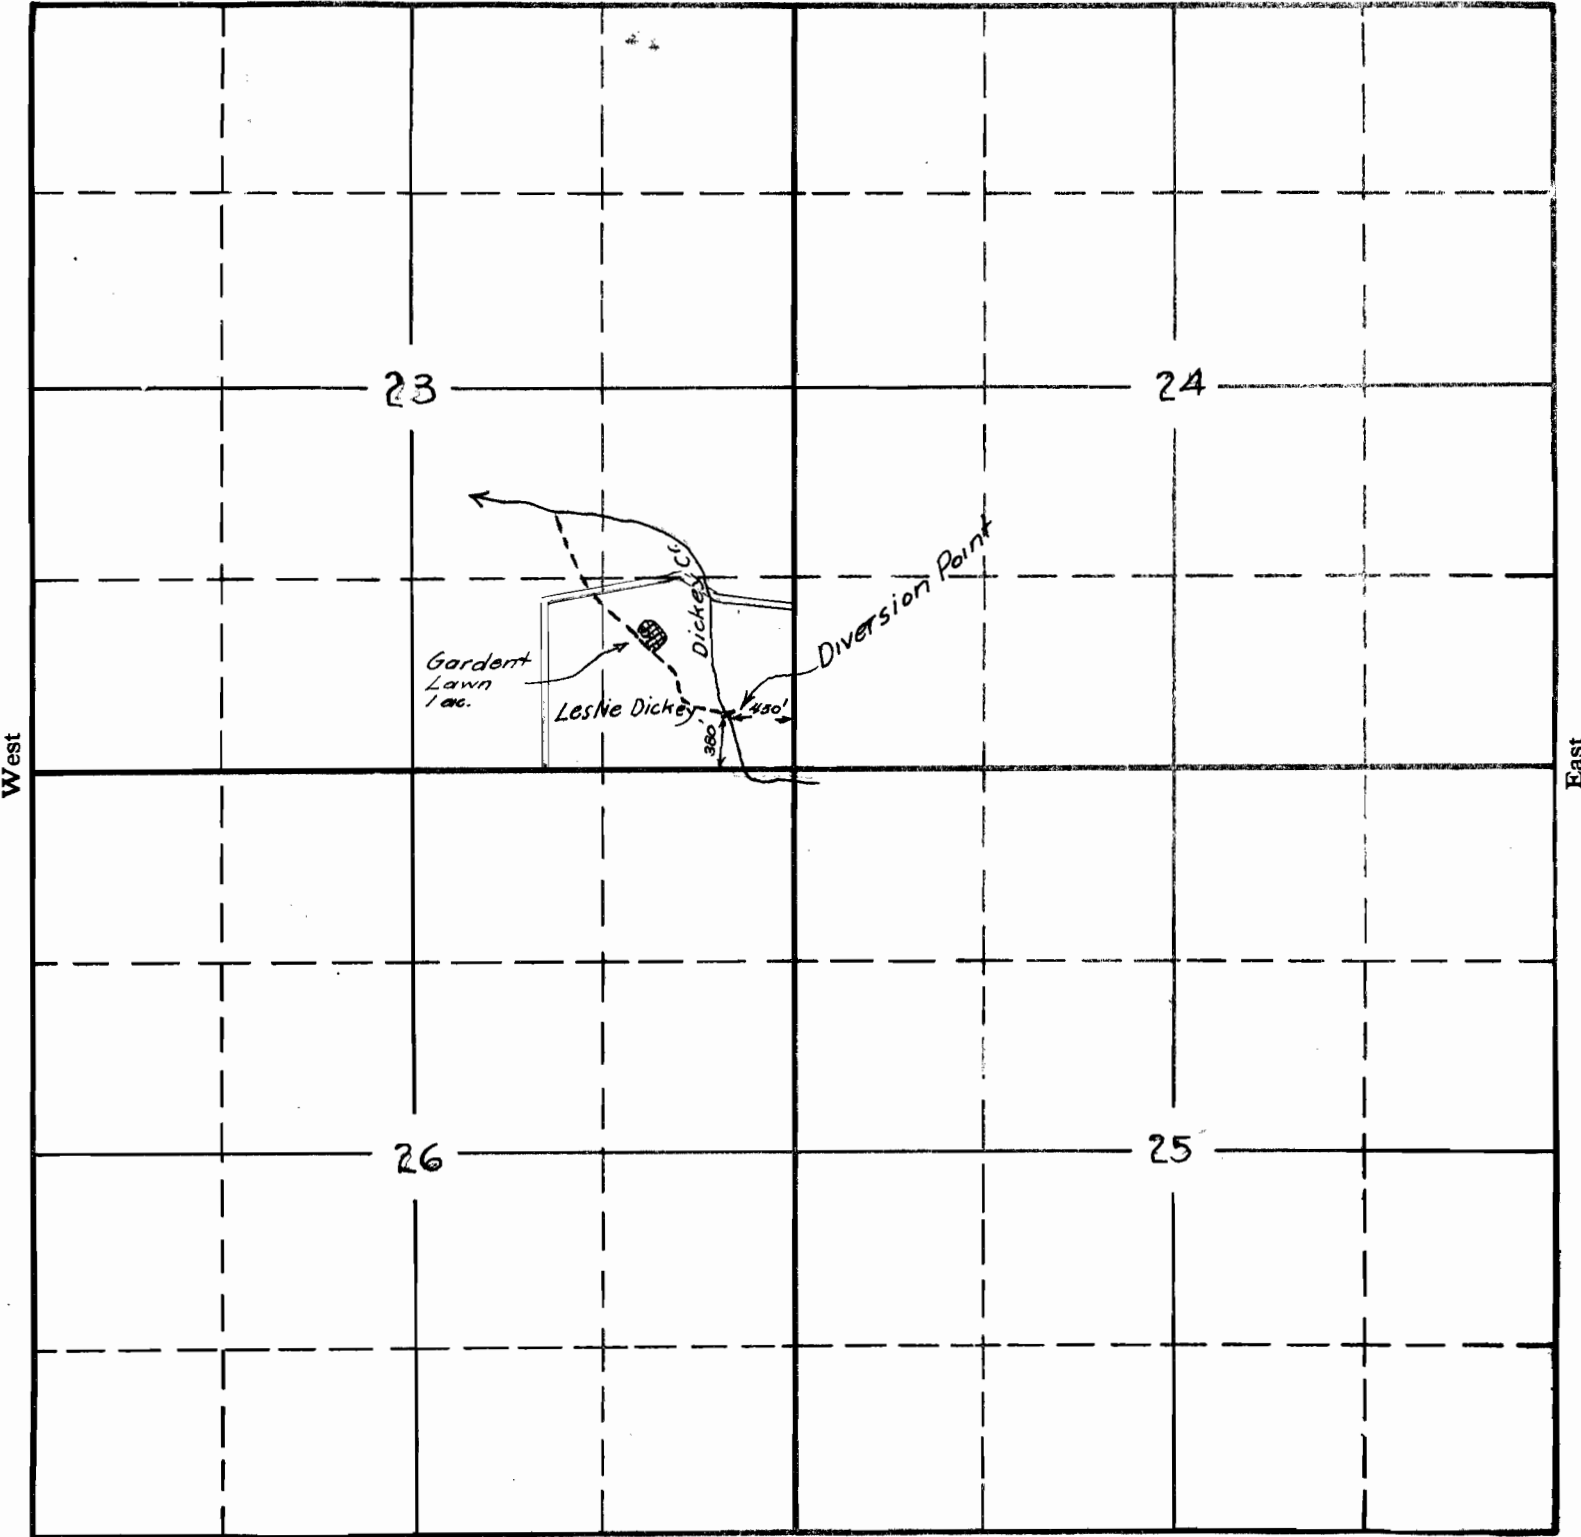

South

2-32A-DR-16581  
APPLICATION No. 16581

PERMIT No. 12355