


14

TOWNSHIP 39 S, RANGE 1 E, W. M.

North

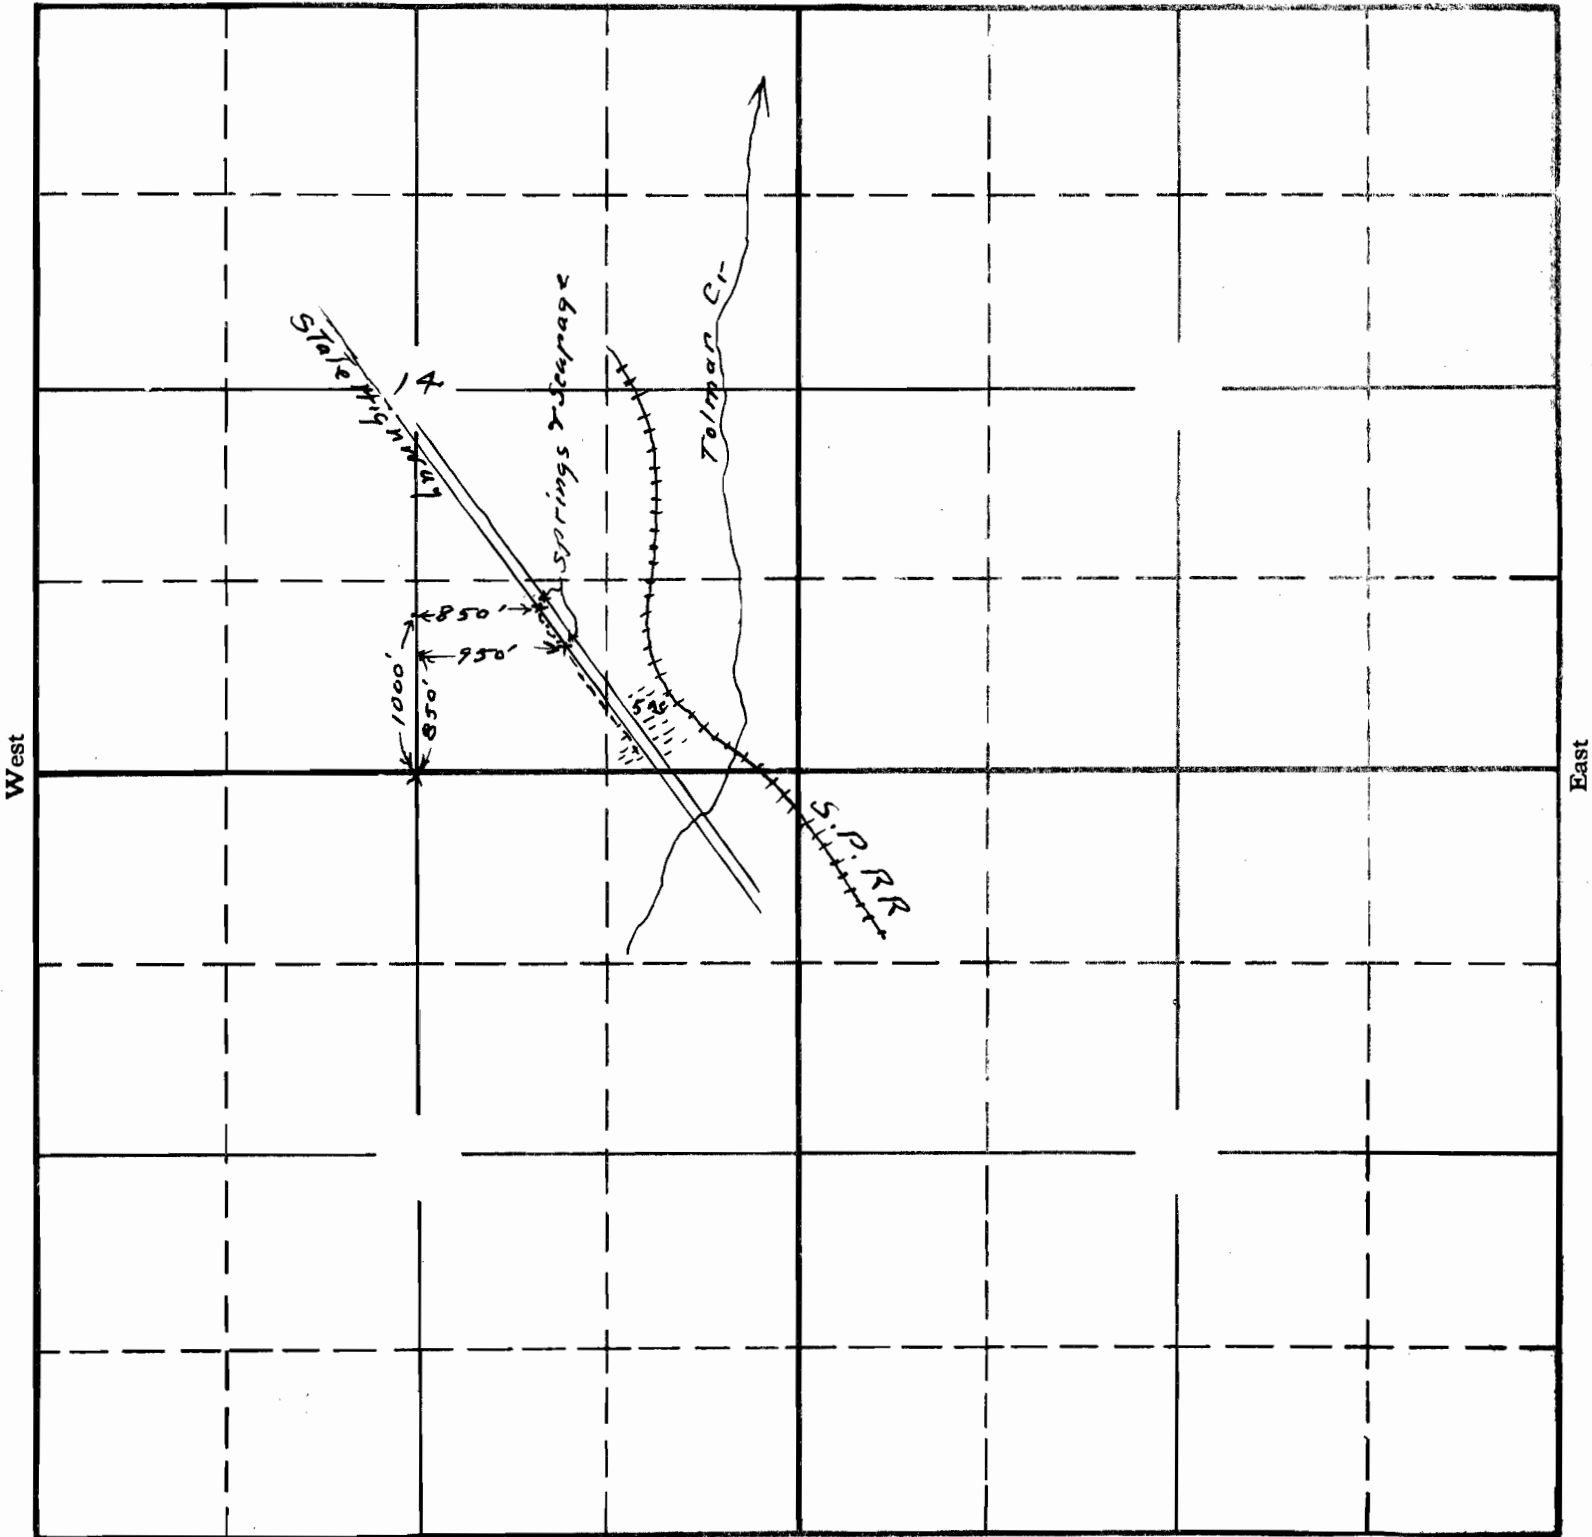

Sketch to accompany application of Homer Moore to appropriate the waters of 2 spgs and seepage for irrigation purposes.

APPLICATION No. 16582
 PERMIT No. 12356