


TOWNSHIP 2 SOUTH

RANGE 44 EAST W.M.

Sec. 2

Sec. 1

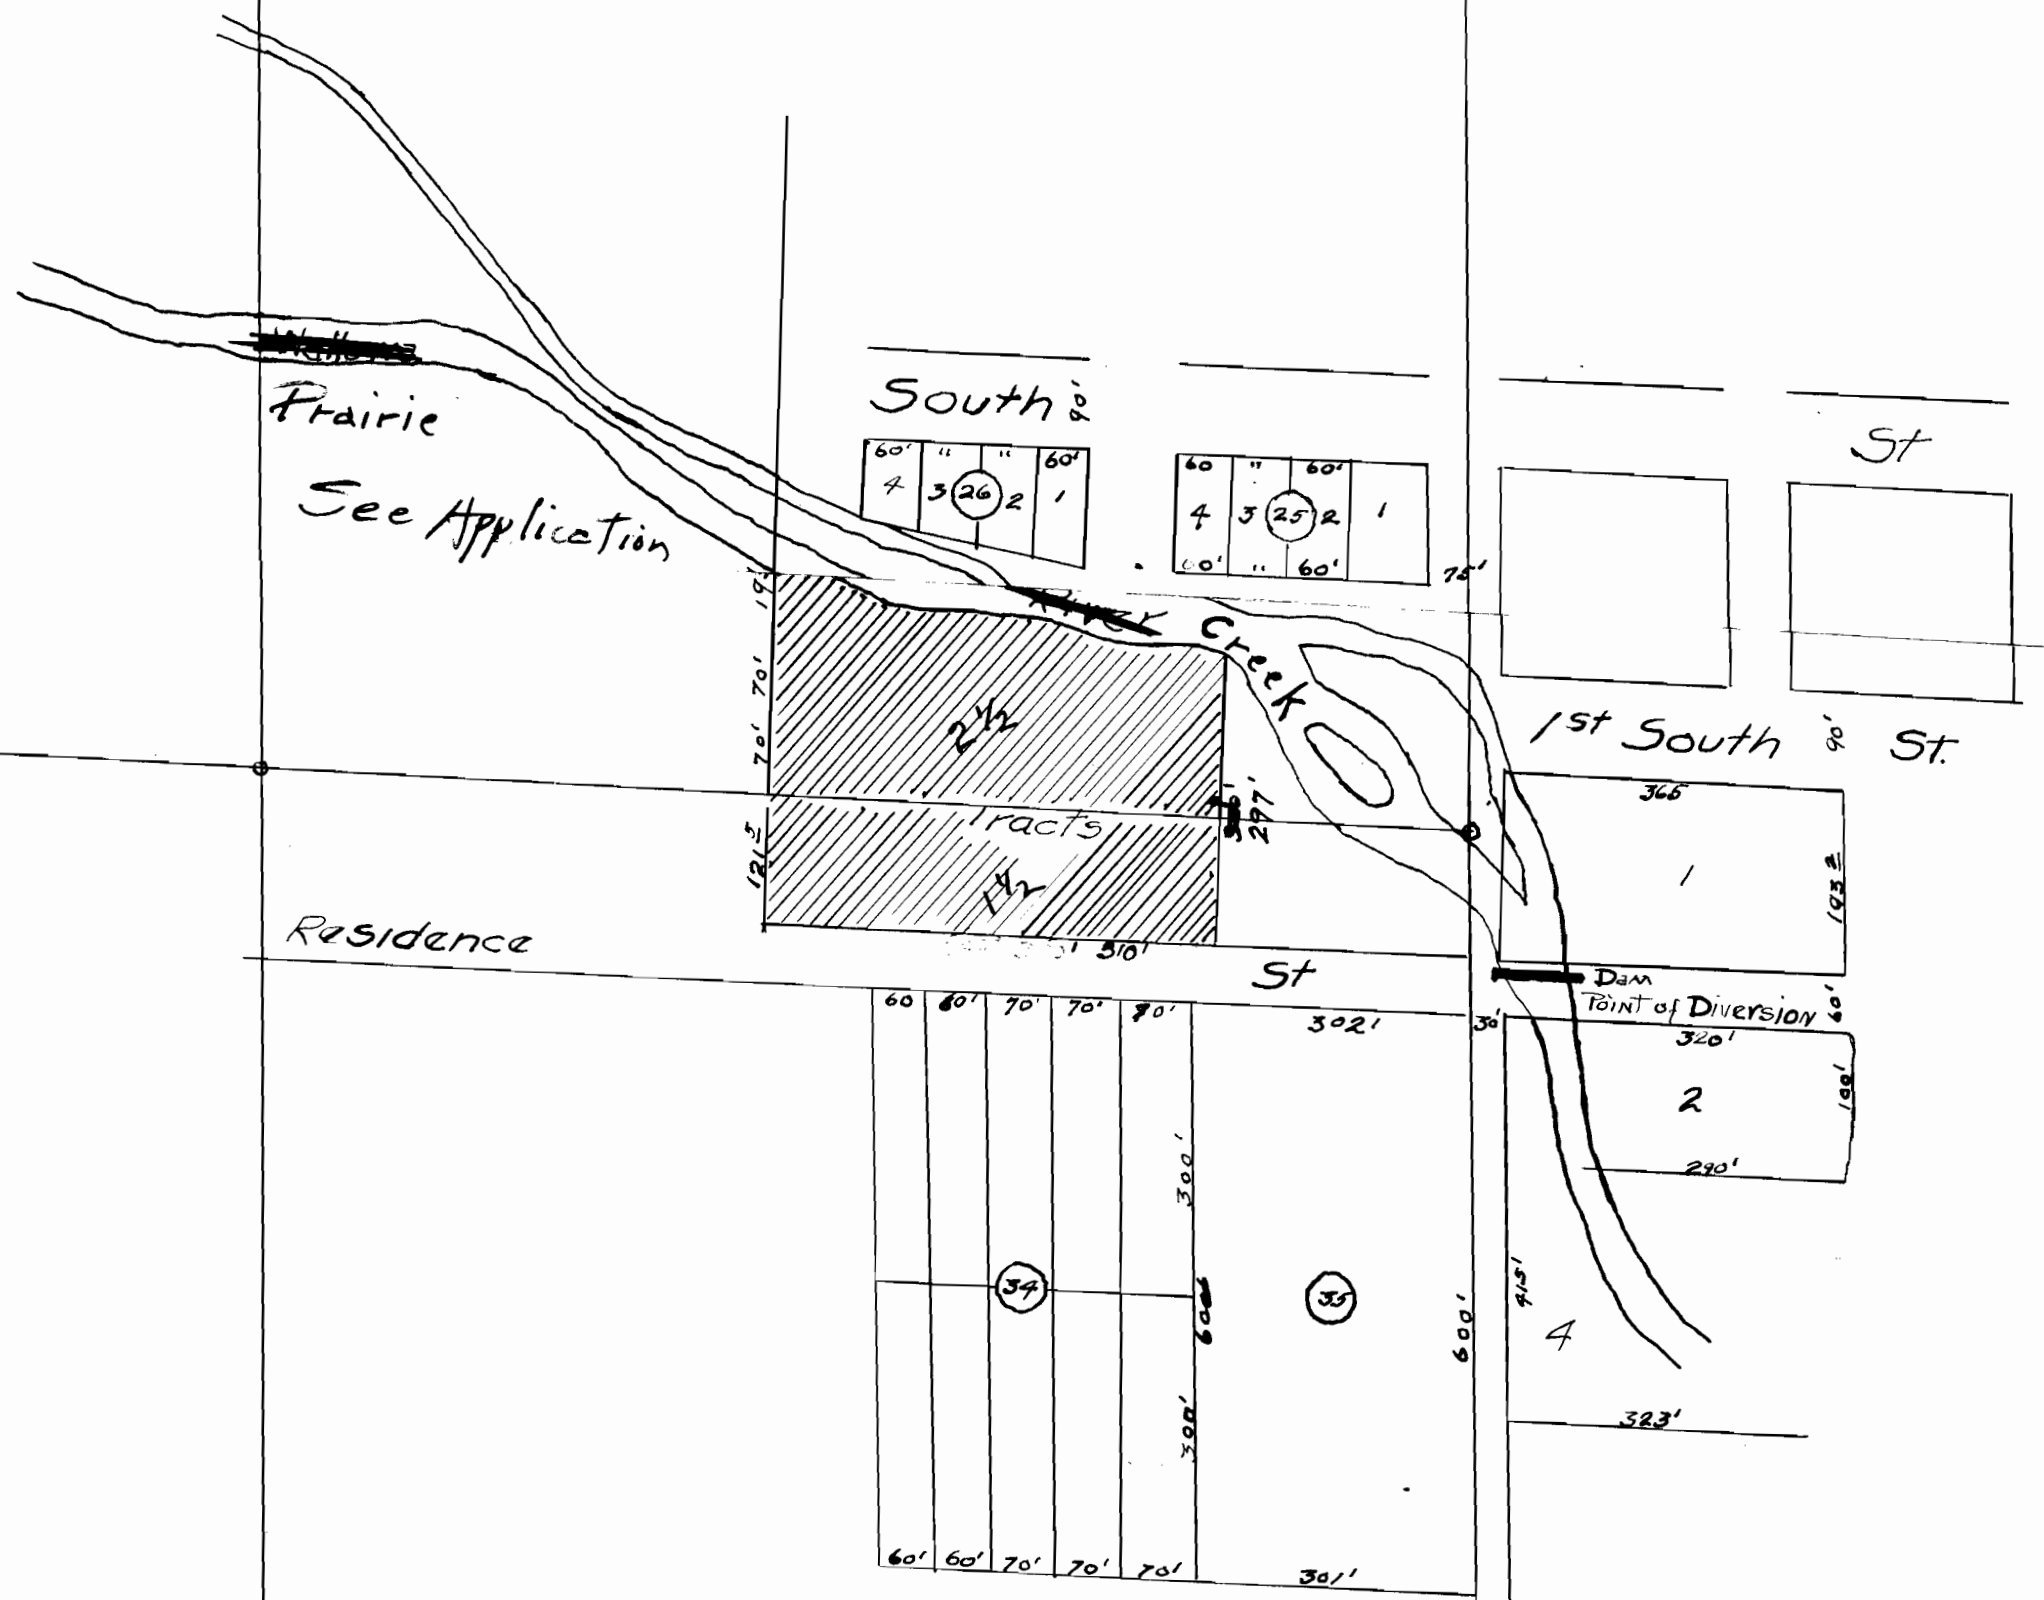

Application No. 16562  
Permit No. 12369

Scale 200' = 1"

E 1/4 Corner

8-30-16562-1