

SECTION

\_\_\_\_\_


\_\_\_\_\_

\_\_\_\_\_

\_\_\_\_\_

TOWNSHIP 405, RANGE 4E, W. M.

North

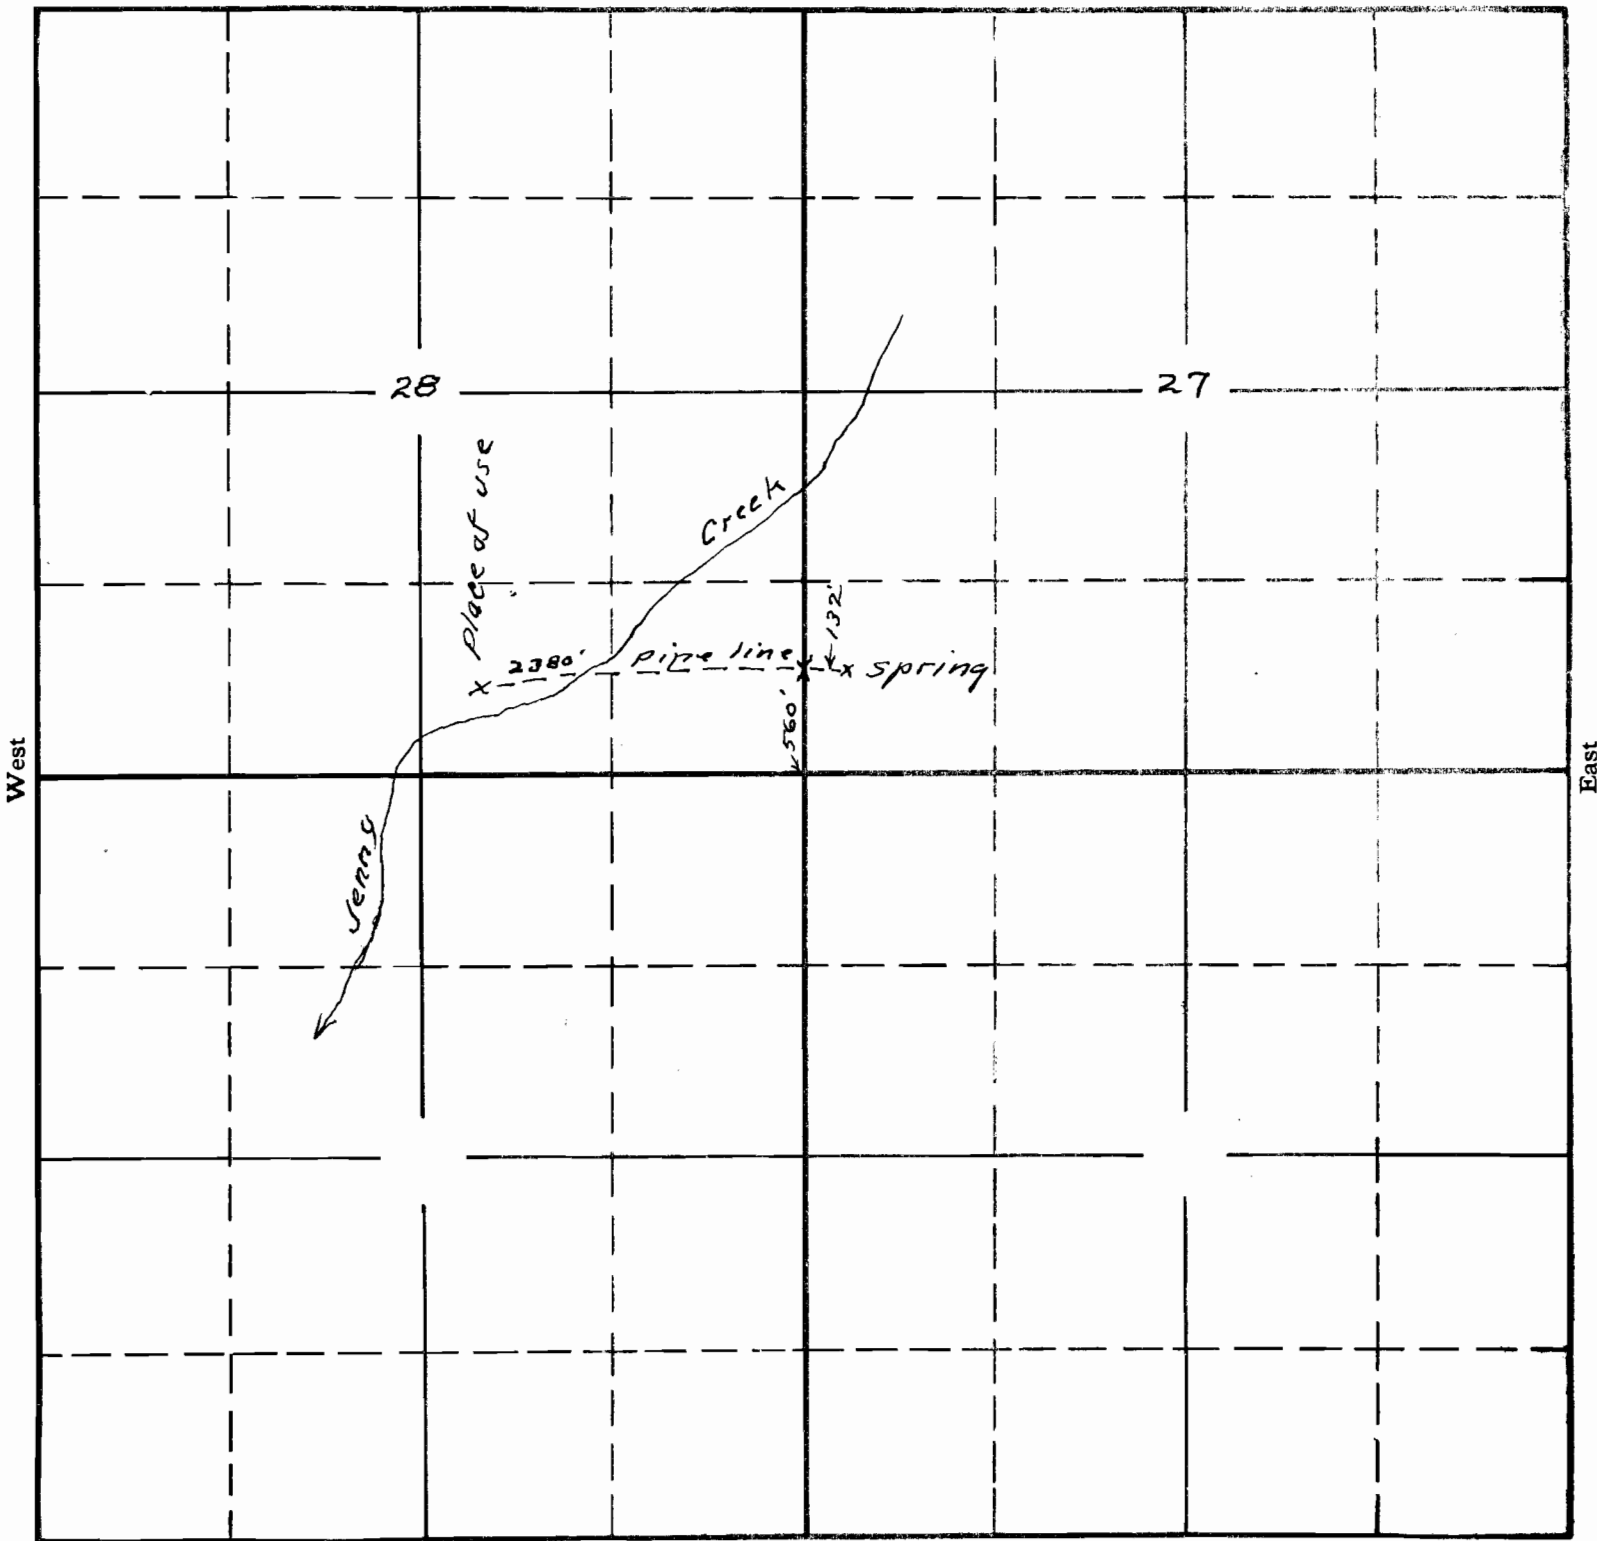

Sketch showing spring and South place of use  
 To accompany application of Louis Miller

APPLICATION No. 16594

PERMIT No. 12380