


Sketch of SW $\frac{1}{4}$  of SW $\frac{1}{4}$  of Section 28  
Twp. 32 S. R. 15 W. N.M.

In Carry County

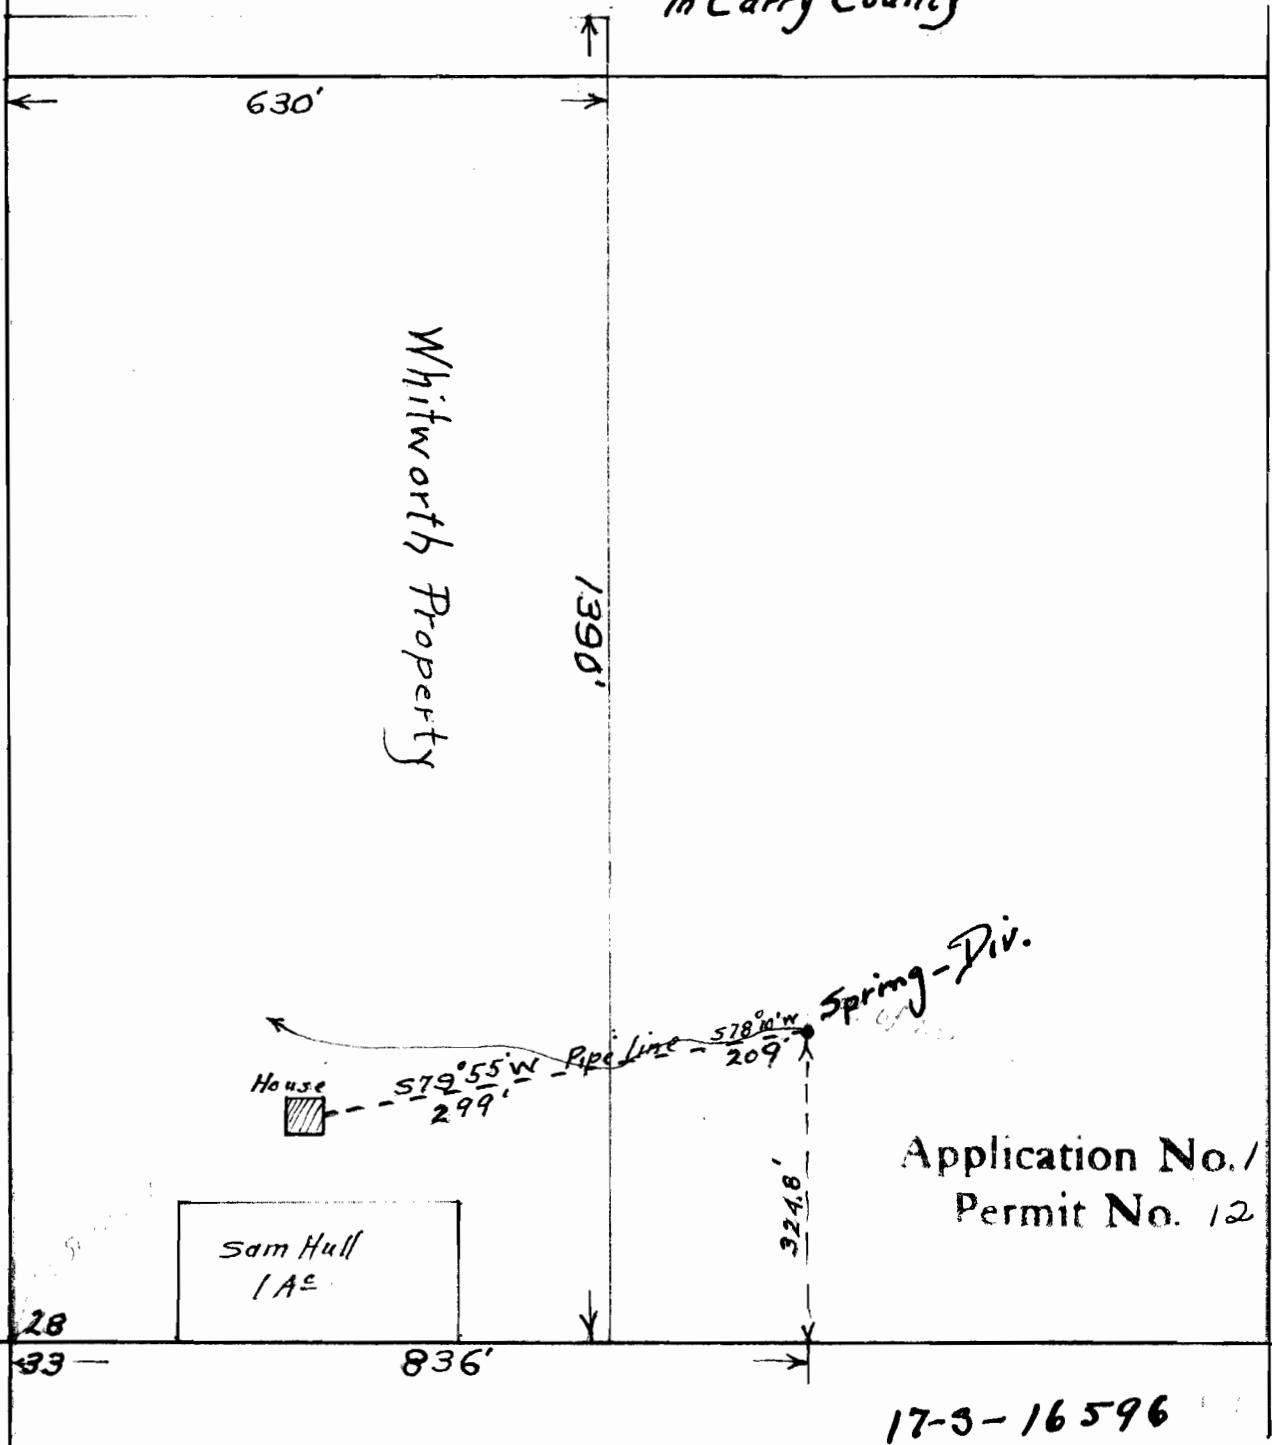

Application No. 16596  
Permit No. 12381

17-3-16596