


SECTION

TOWNSHIP 385, RANGE 1 W, W. M.

North

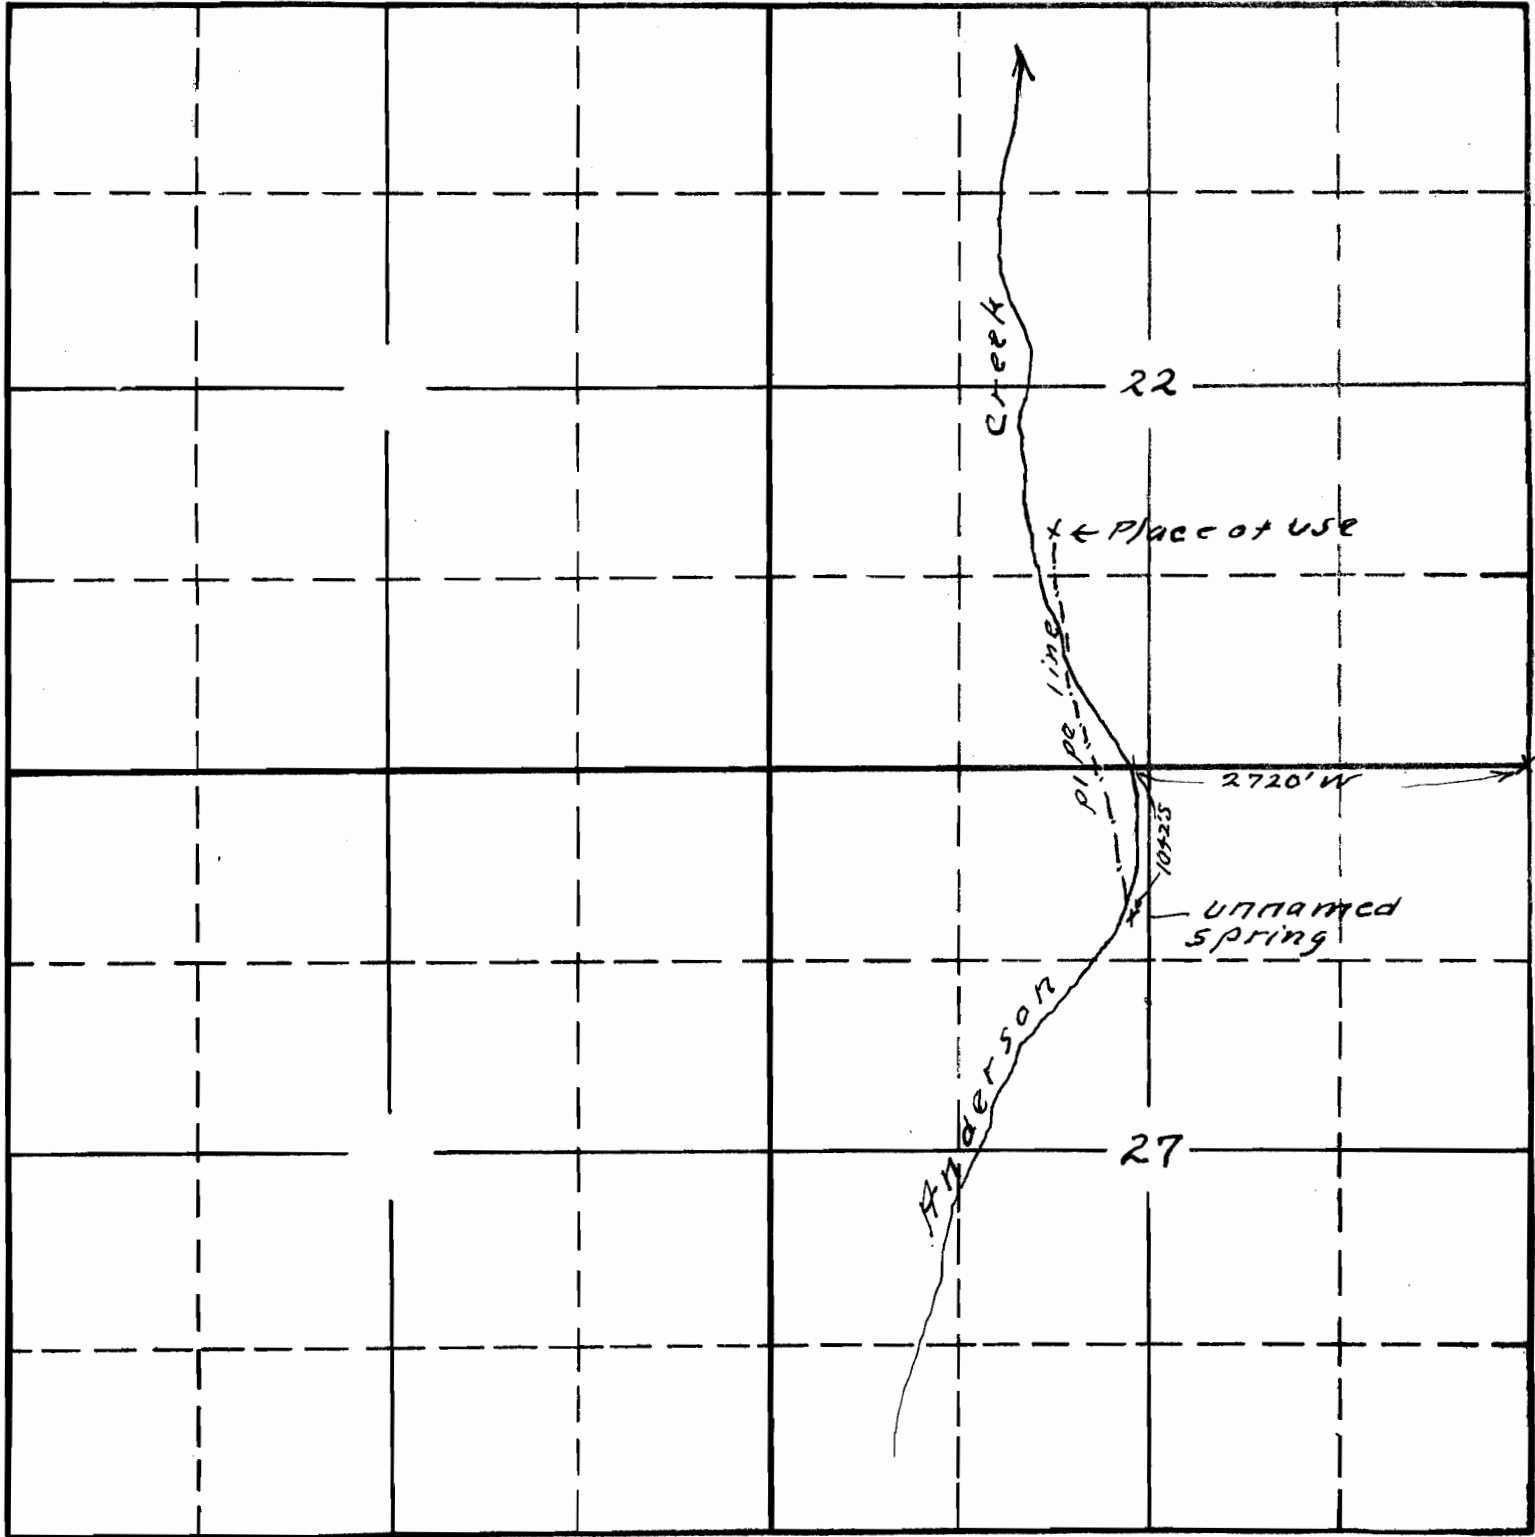

South

Sketch showing location of spring and place of use. To accompany application of A. Belle Anderson for permit to use for domestic, stock and garden purposes.

APPLICATION No. 16605
 PERMIT No. 12388