


33

TOWNSHIP 33S, RANGE 2W, W. M.

North

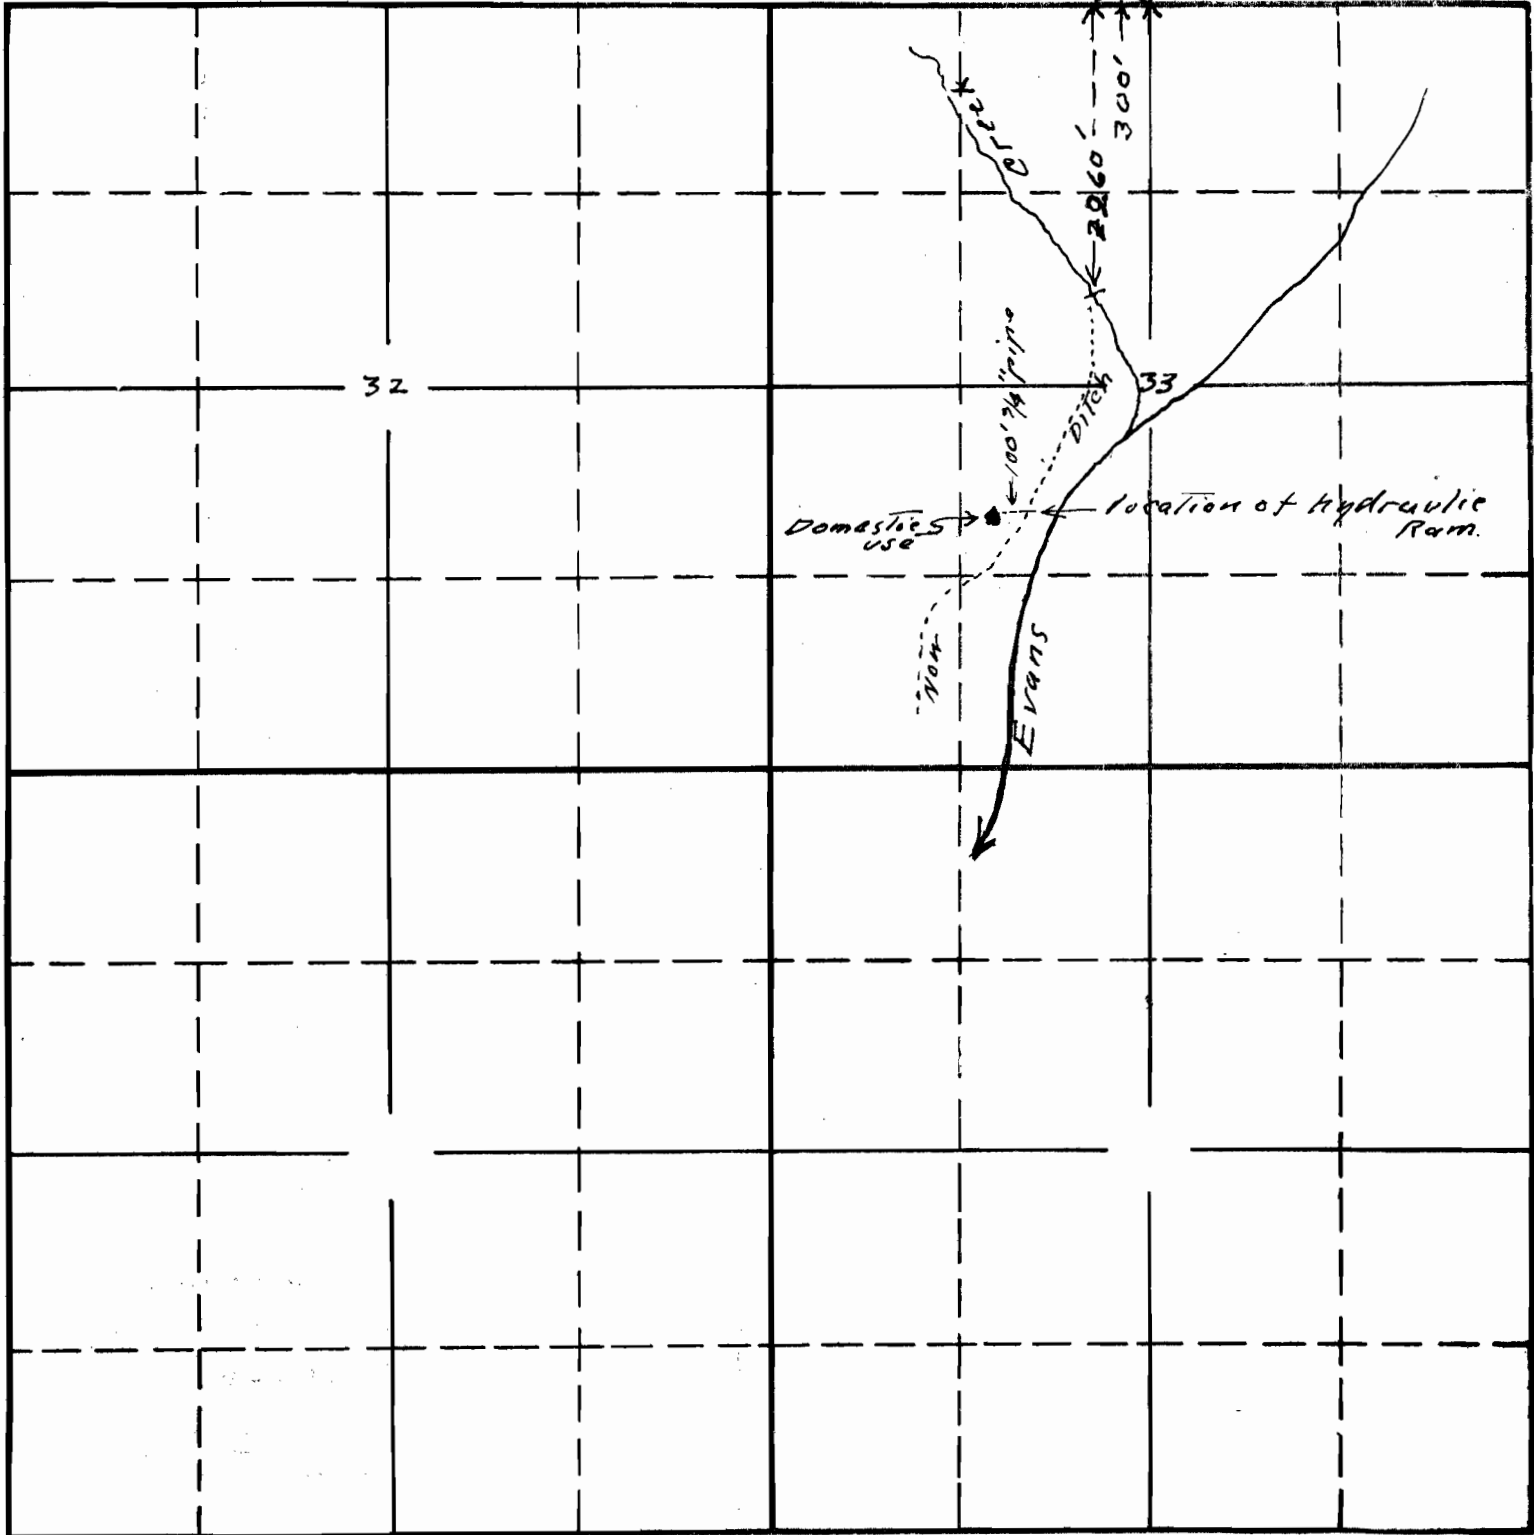

West

East

South

Sketch showing location of diversion and place of use for application of Mrs Helena Vigar for domestic and garden.

15-37-16621
APPLICATION No. 16621
PERMIT No. 12402