


SECTION

TOWNSHIP _____, RANGE _____, W. M.

North

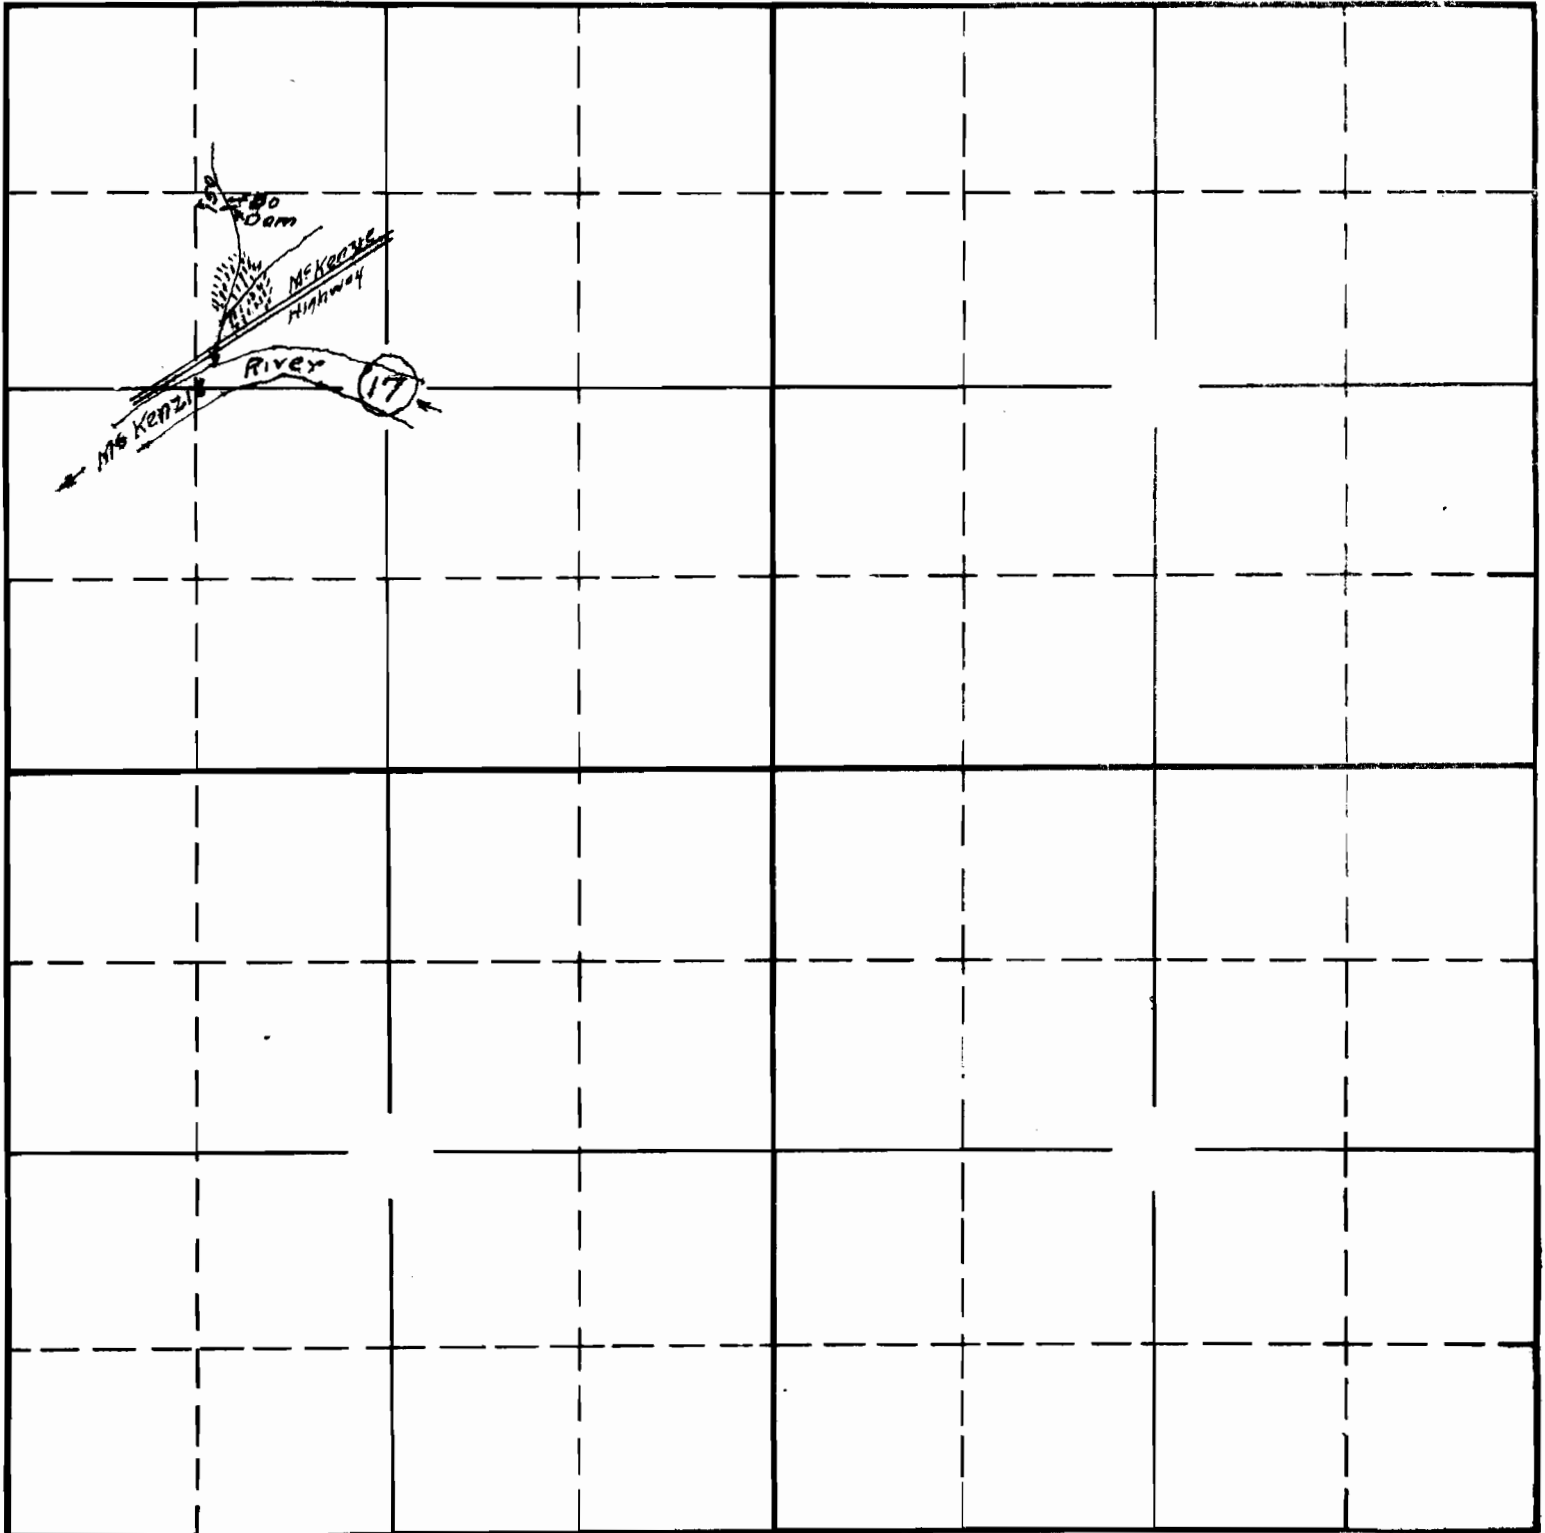

West

East

South

2-28-16623-11
APPLICATION No. 16623
PERMIT No. 12404