


SECTION

TOWNSHIP 165, RANGE 8W, W. M.

North

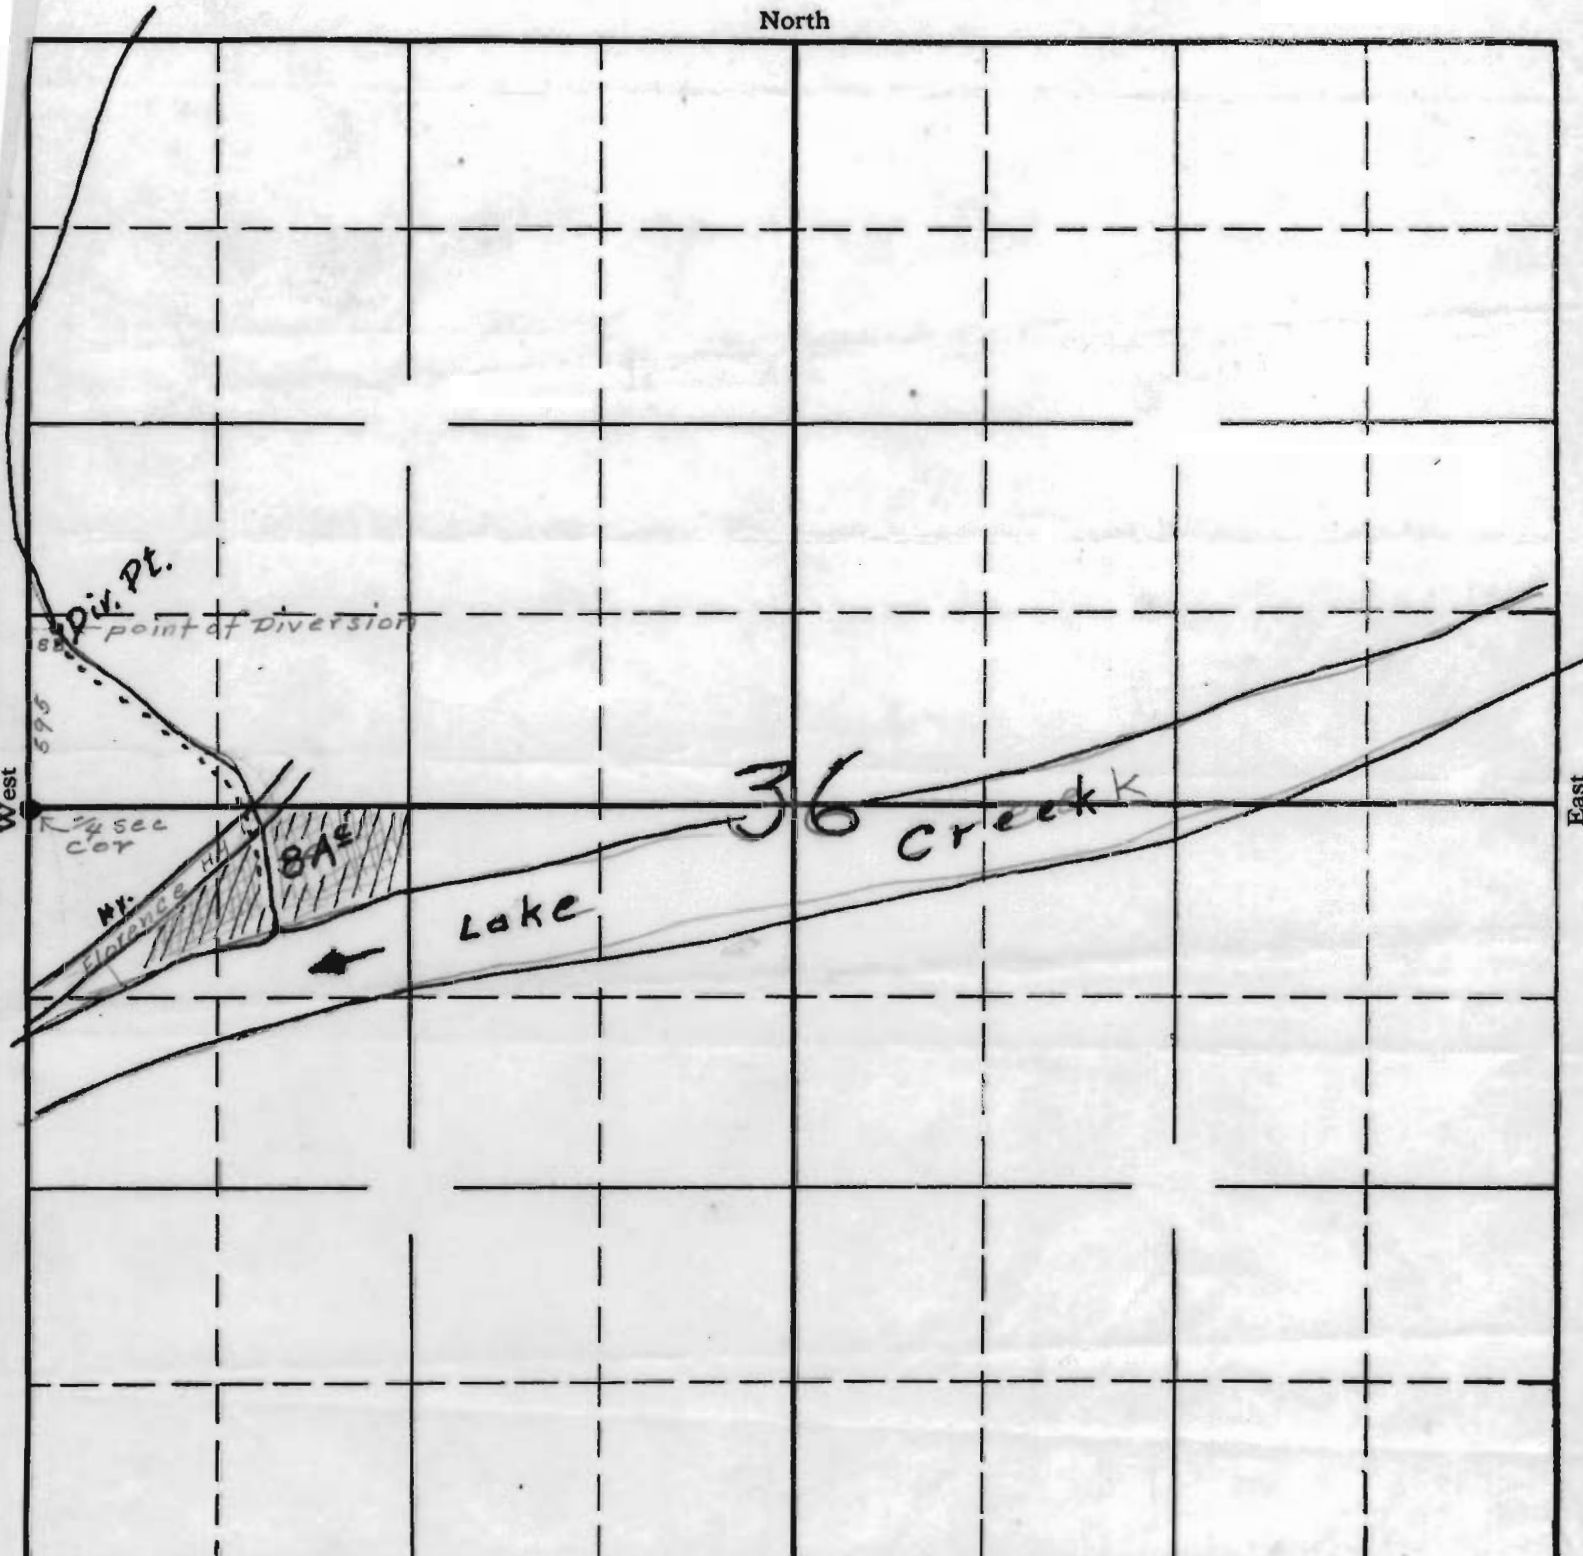

South

08/18-25-16640
 APPLICATION No. 16640
 PERMIT No. 12415

RECEIVED
 OCT 20 1936

STATE ENGINEER
 SALEM, OREGON