


SECTION

Permit: S 12418
Volume: 7
Strm: THE CANYON
Trib: APPLEGATE R
Priority: 10/26/36

TOWNSHIP 36 S, RANGE 61

North

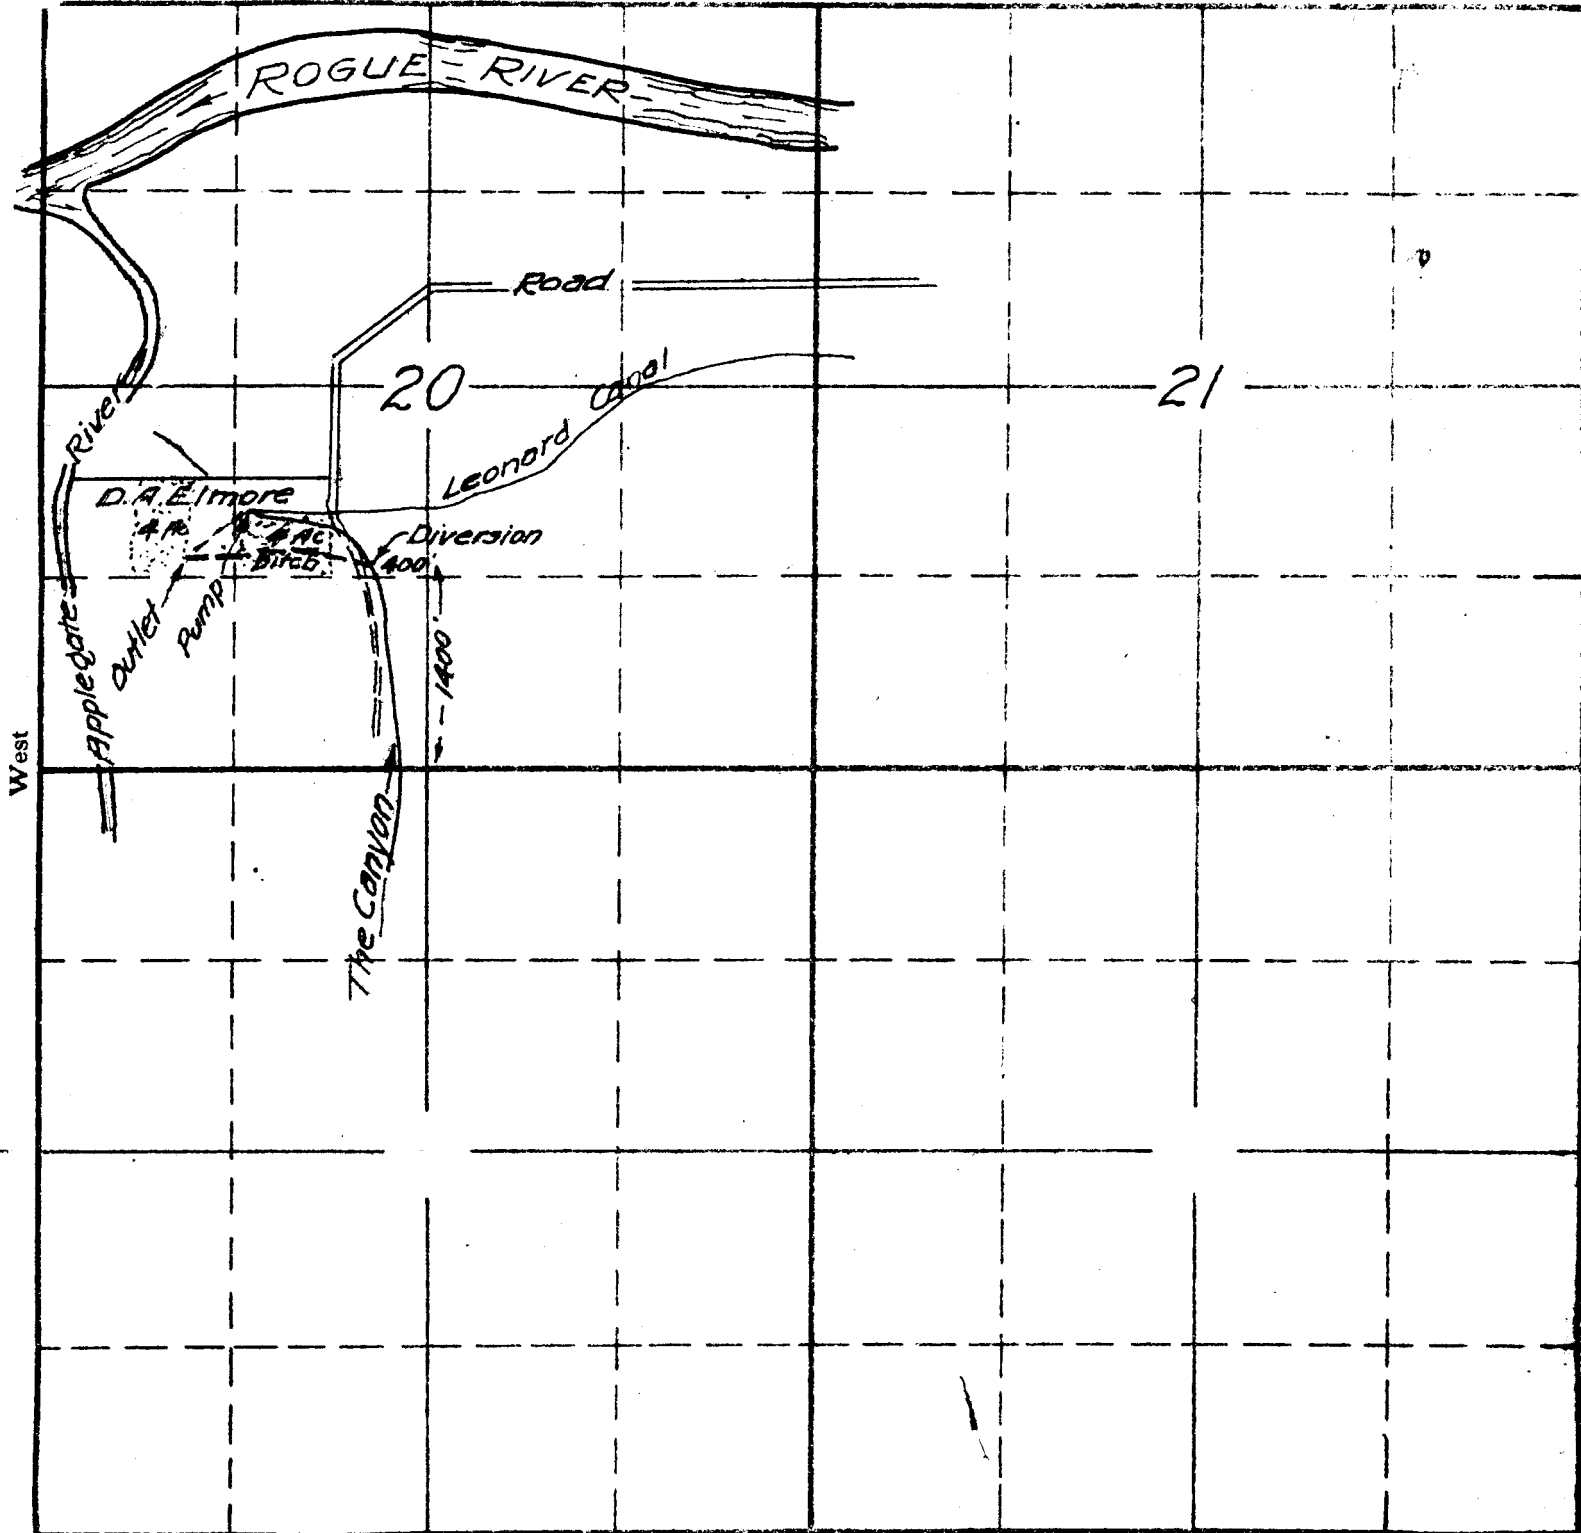

South

15-16-16645-1
APPLICATION No. 16645
PERMIT No. 12418