


T 2 S., R. 3 W.

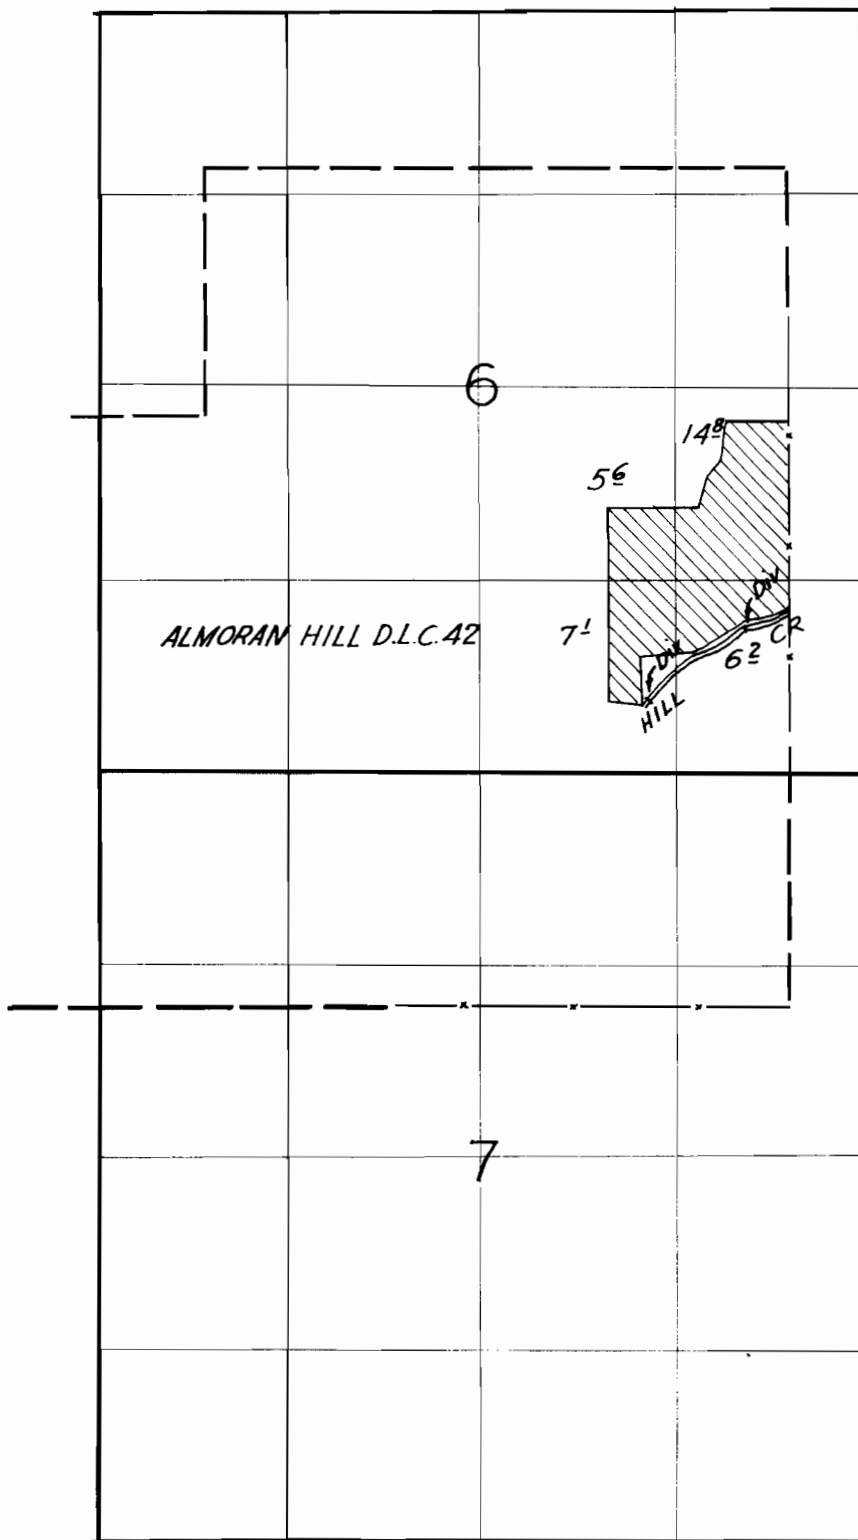

Surveyed Aug. 15 1941  
Charles A. Cummins


App. 16676  
Per. 12443

SECTION

\_\_\_\_\_  
\_\_\_\_\_  
\_\_\_\_\_  
\_\_\_\_\_

TOWNSHIP 25, RANGE 3W, W. M.

North

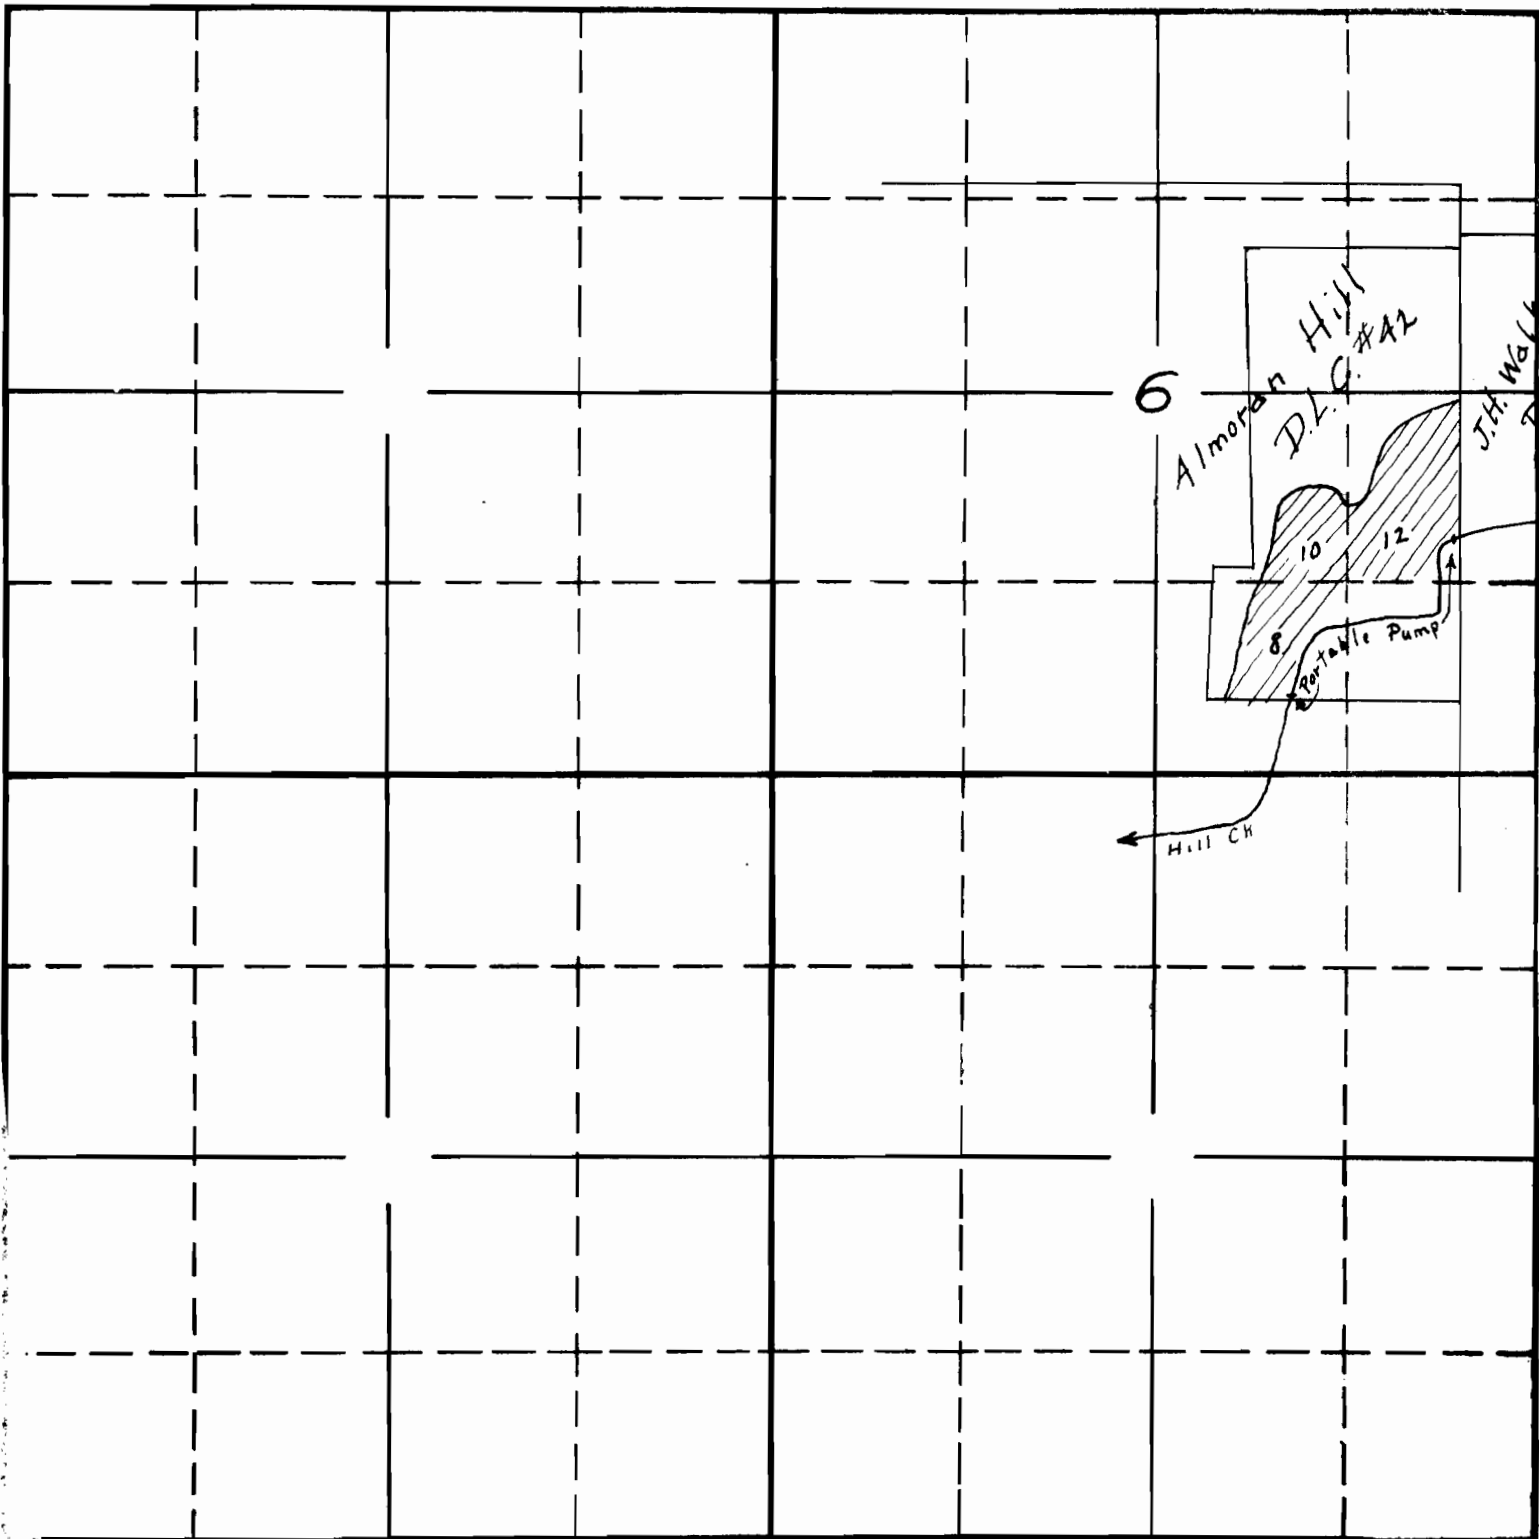

West

East

South

2-62B-16676  
APPLICATION No. 16676  
PERMIT No. 12443