


SECTION

16

TOWNSHIP 85, RANGE 40E, W. M.

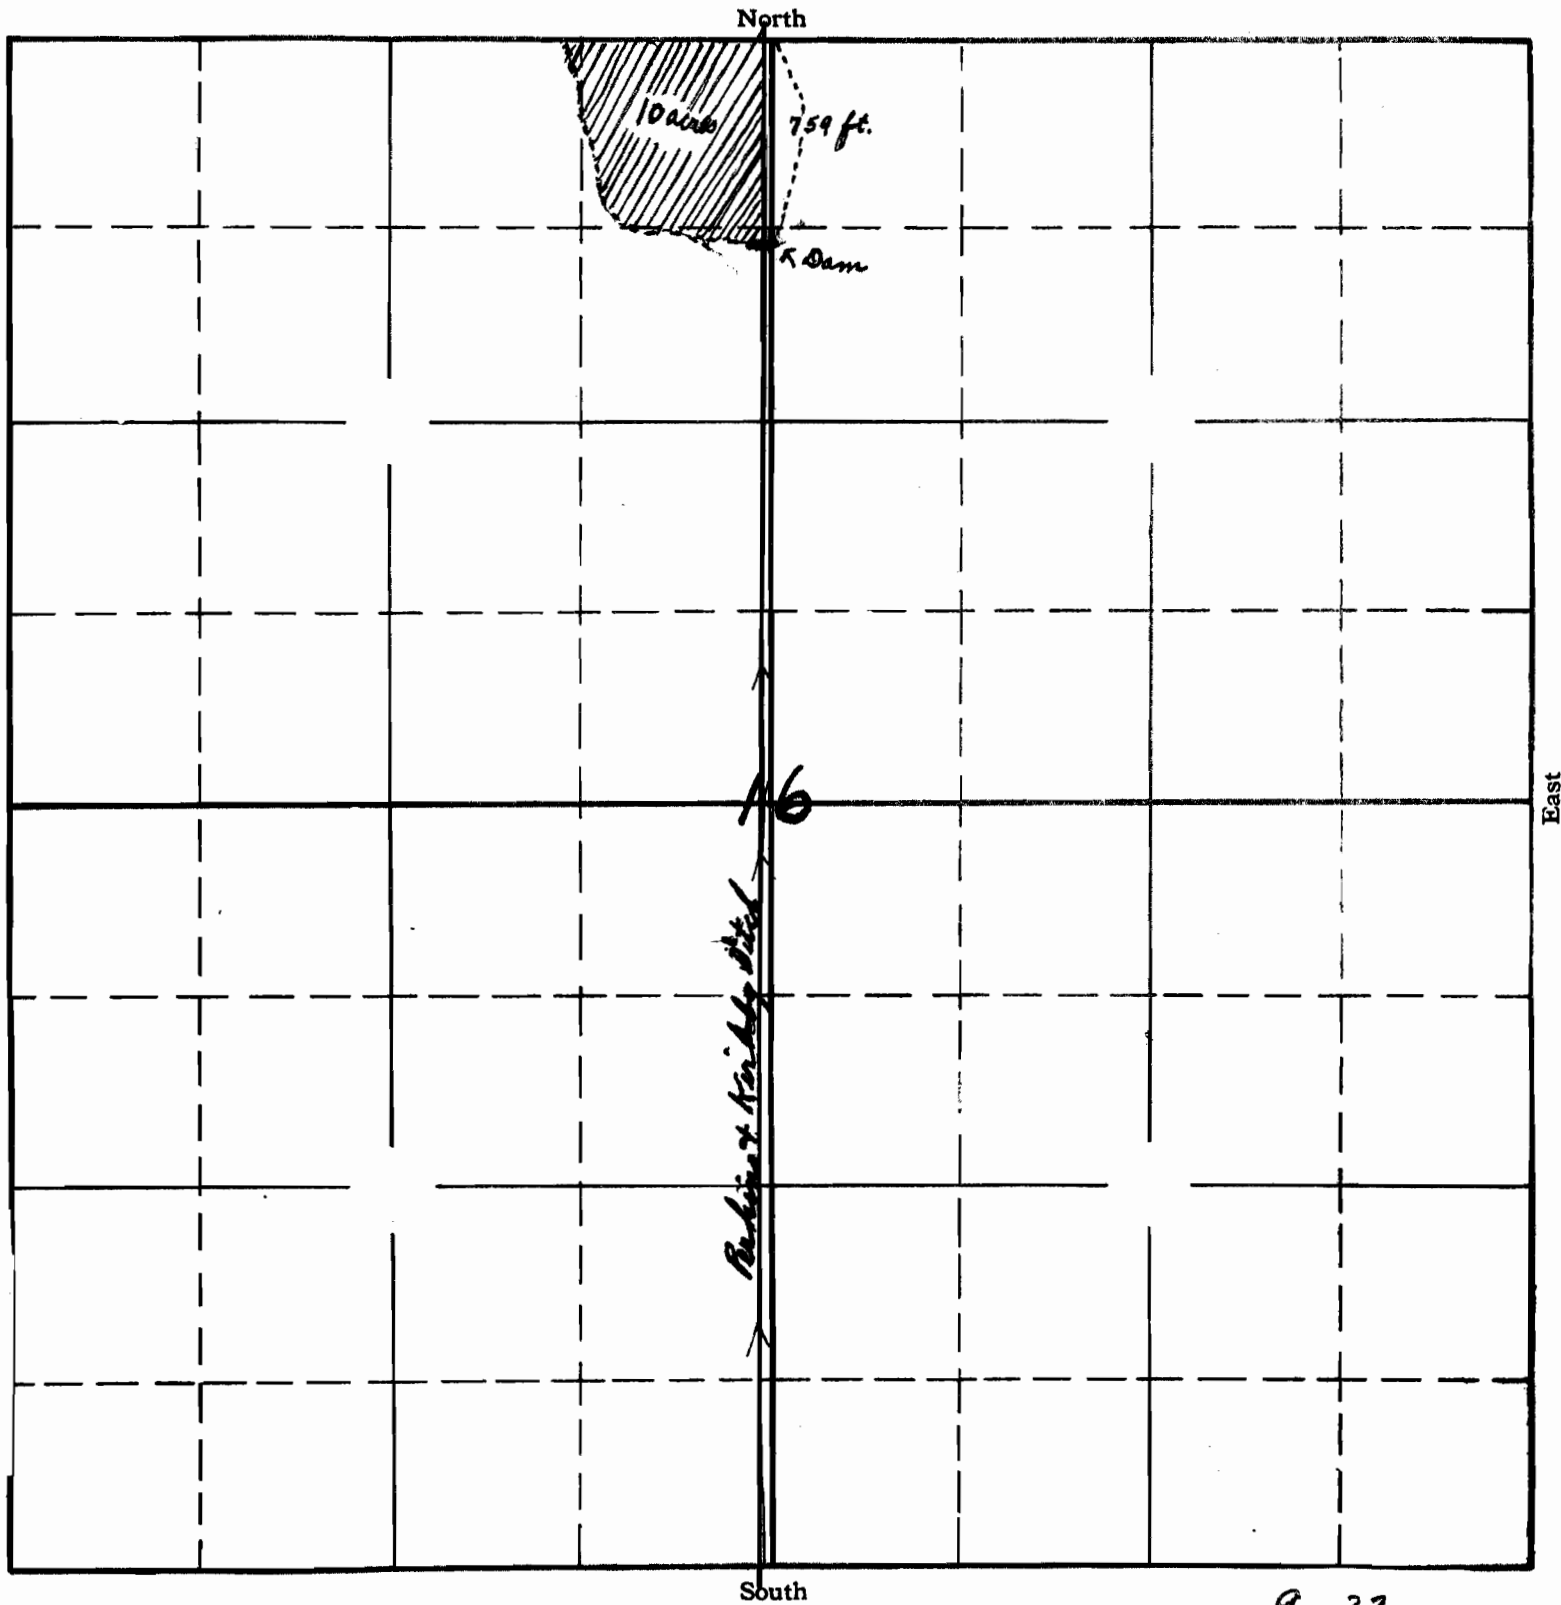

9-32  
 APPLICATION No. 16415  
 PERMIT No. 12463