


SECTION

TOWNSHIP 45, RANGE 40E, W. M.

North

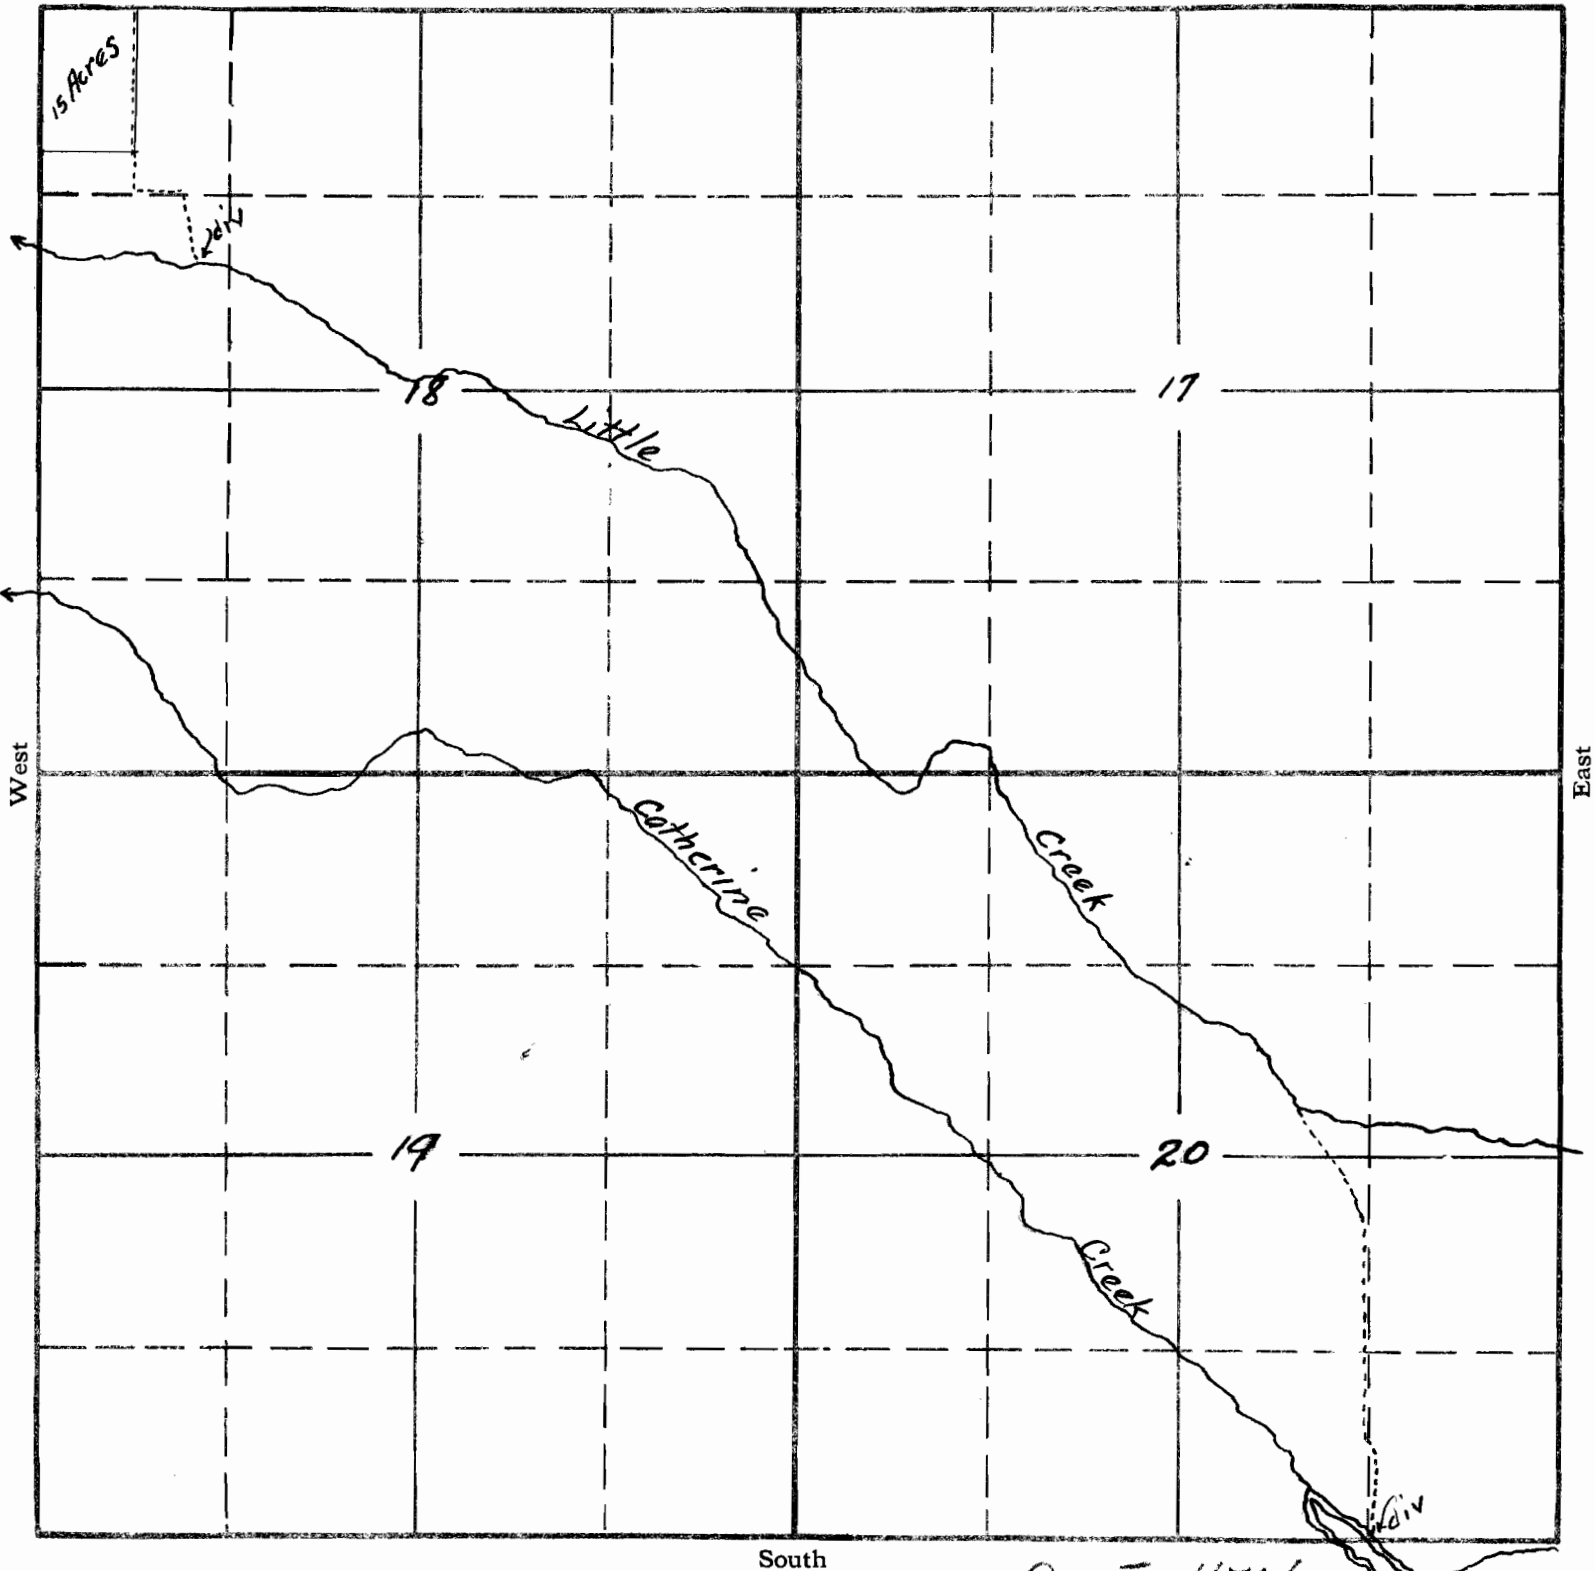

South

8-5-16706

APPLICATION No. 16706

PERMIT No. 12493