

SECTION

\_\_\_\_\_


\_\_\_\_\_

\_\_\_\_\_

\_\_\_\_\_

TOWNSHIP 34 S, RANGE 8 W., W. M.

North

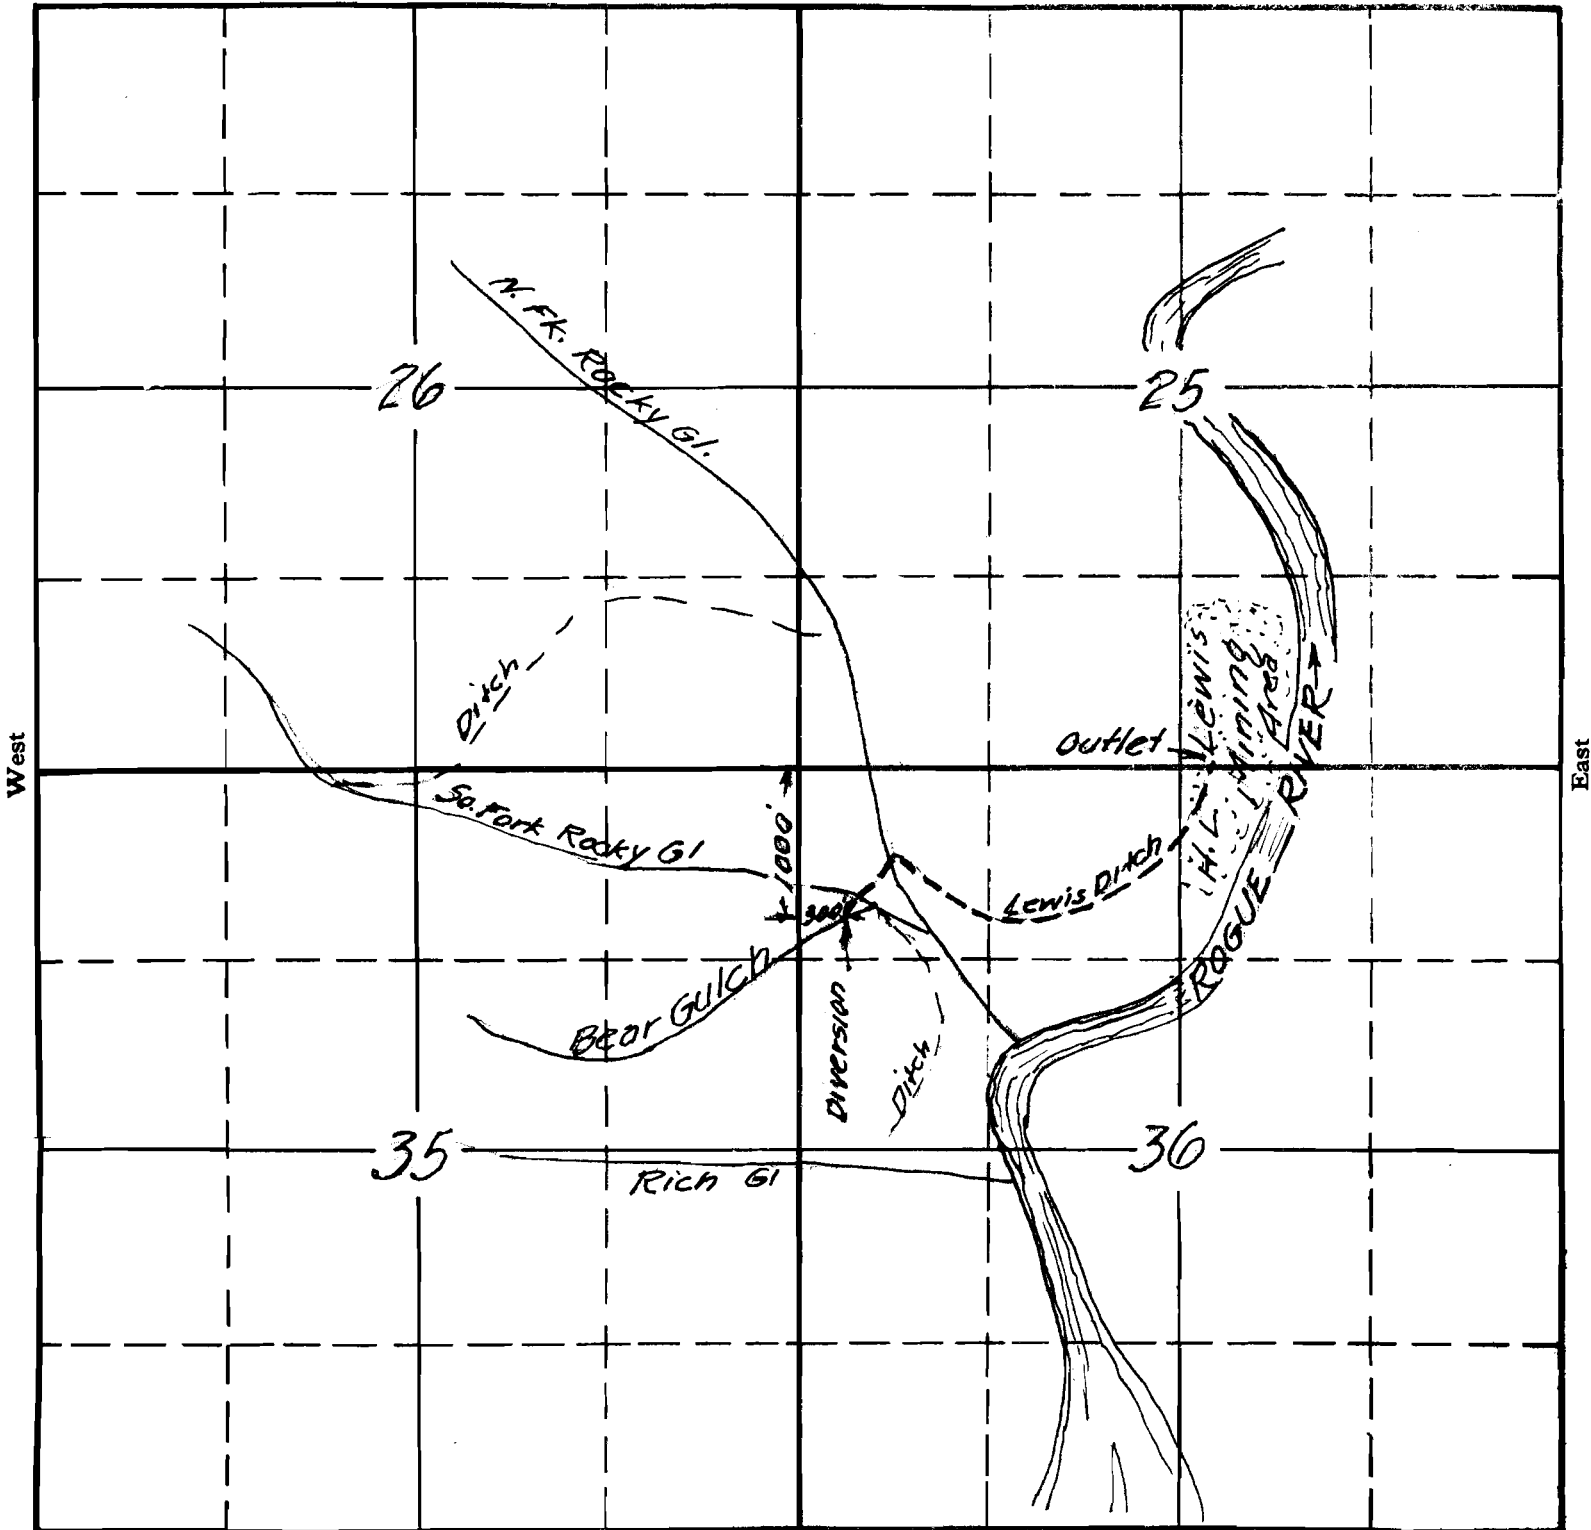

West

East

South

Dec. '36

15-74-16727-1  
 APPLICATION No. 16727  
 PERMIT No. 12511