


SECTION

8+9

TOWNSHIP 25, RANGE 4E, W. M.

North

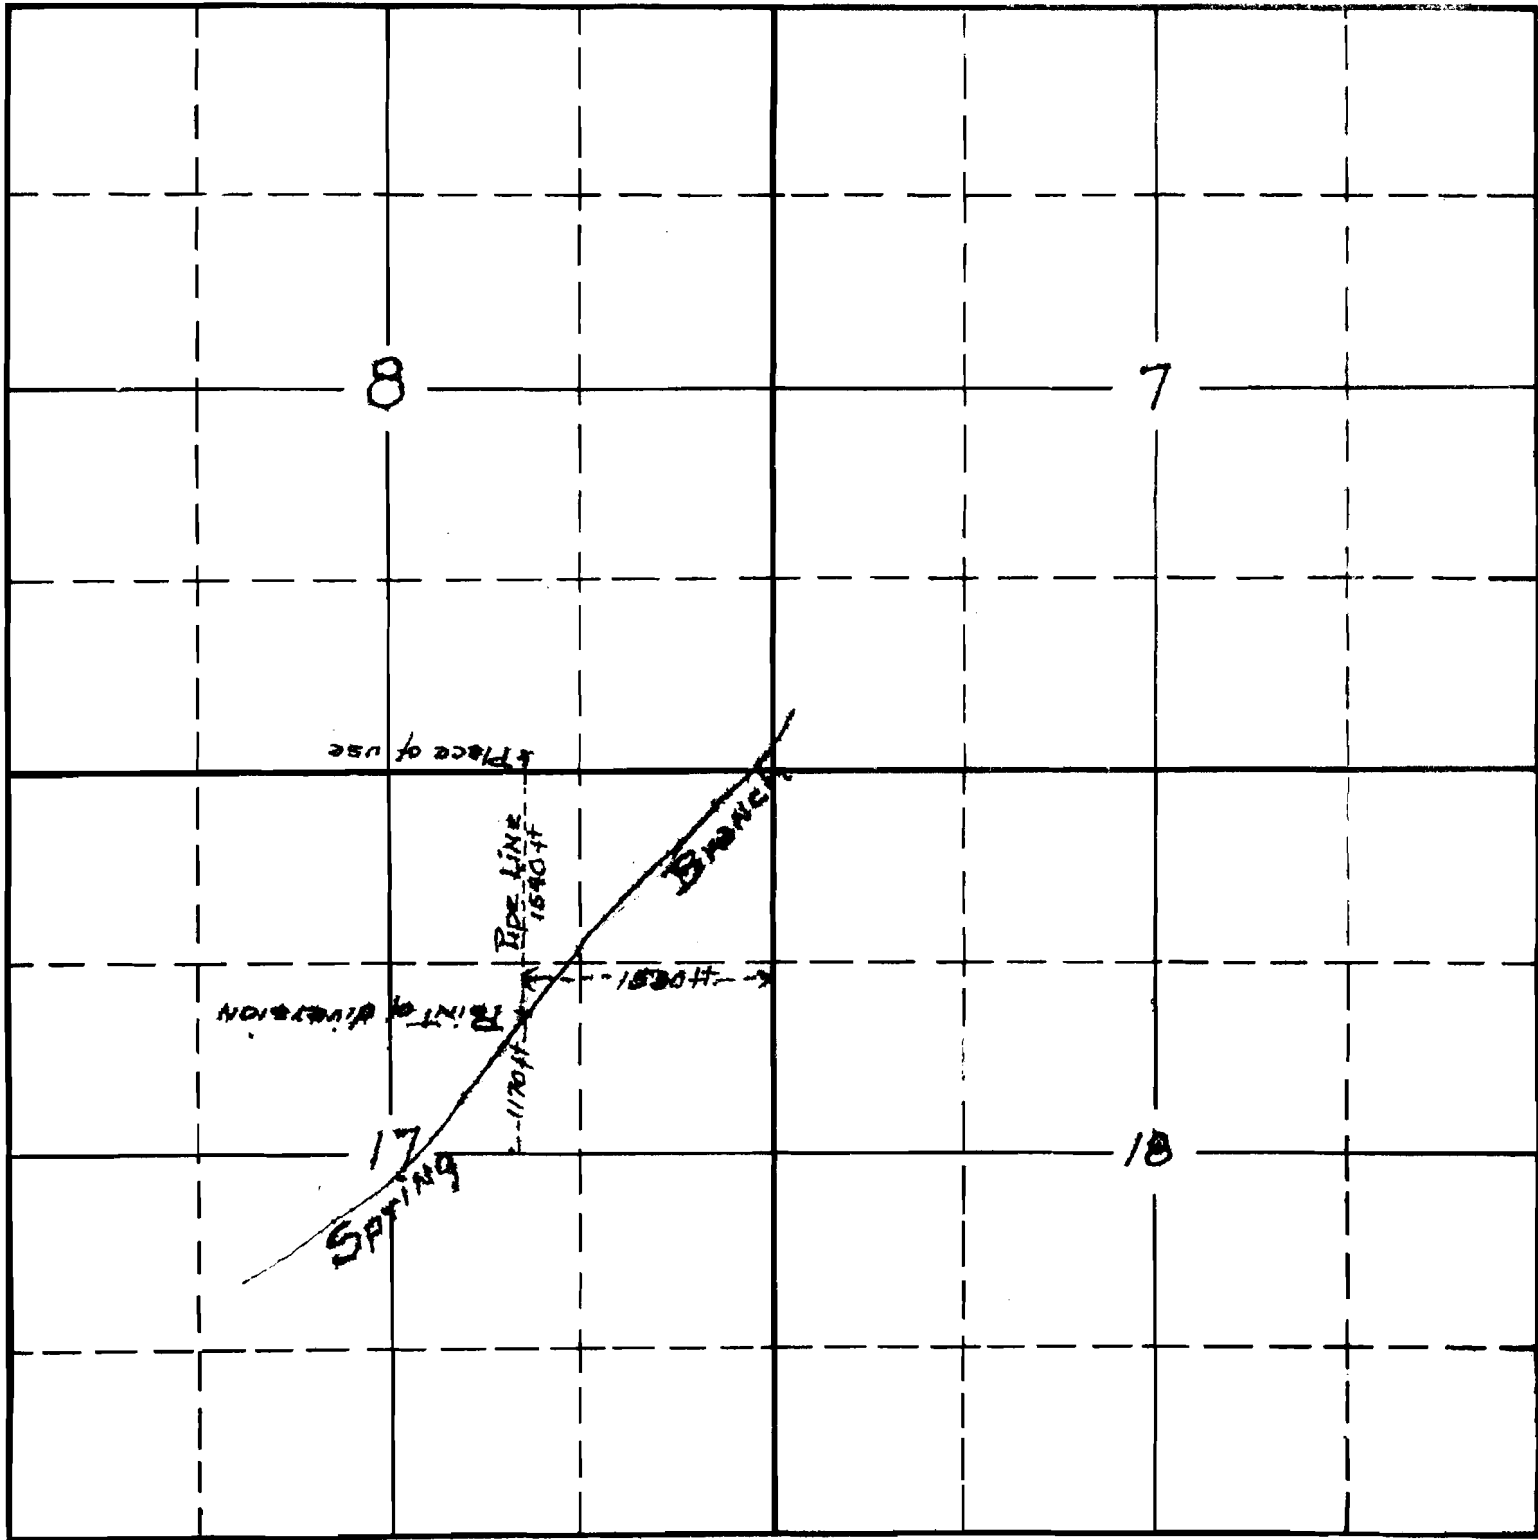

South

8-35-16732-4
 APPLICATION No. 16732
 PERMIT No. 12515

