


SECTION

TOWNSHIP 15., RANGE 3W., W. M.

North

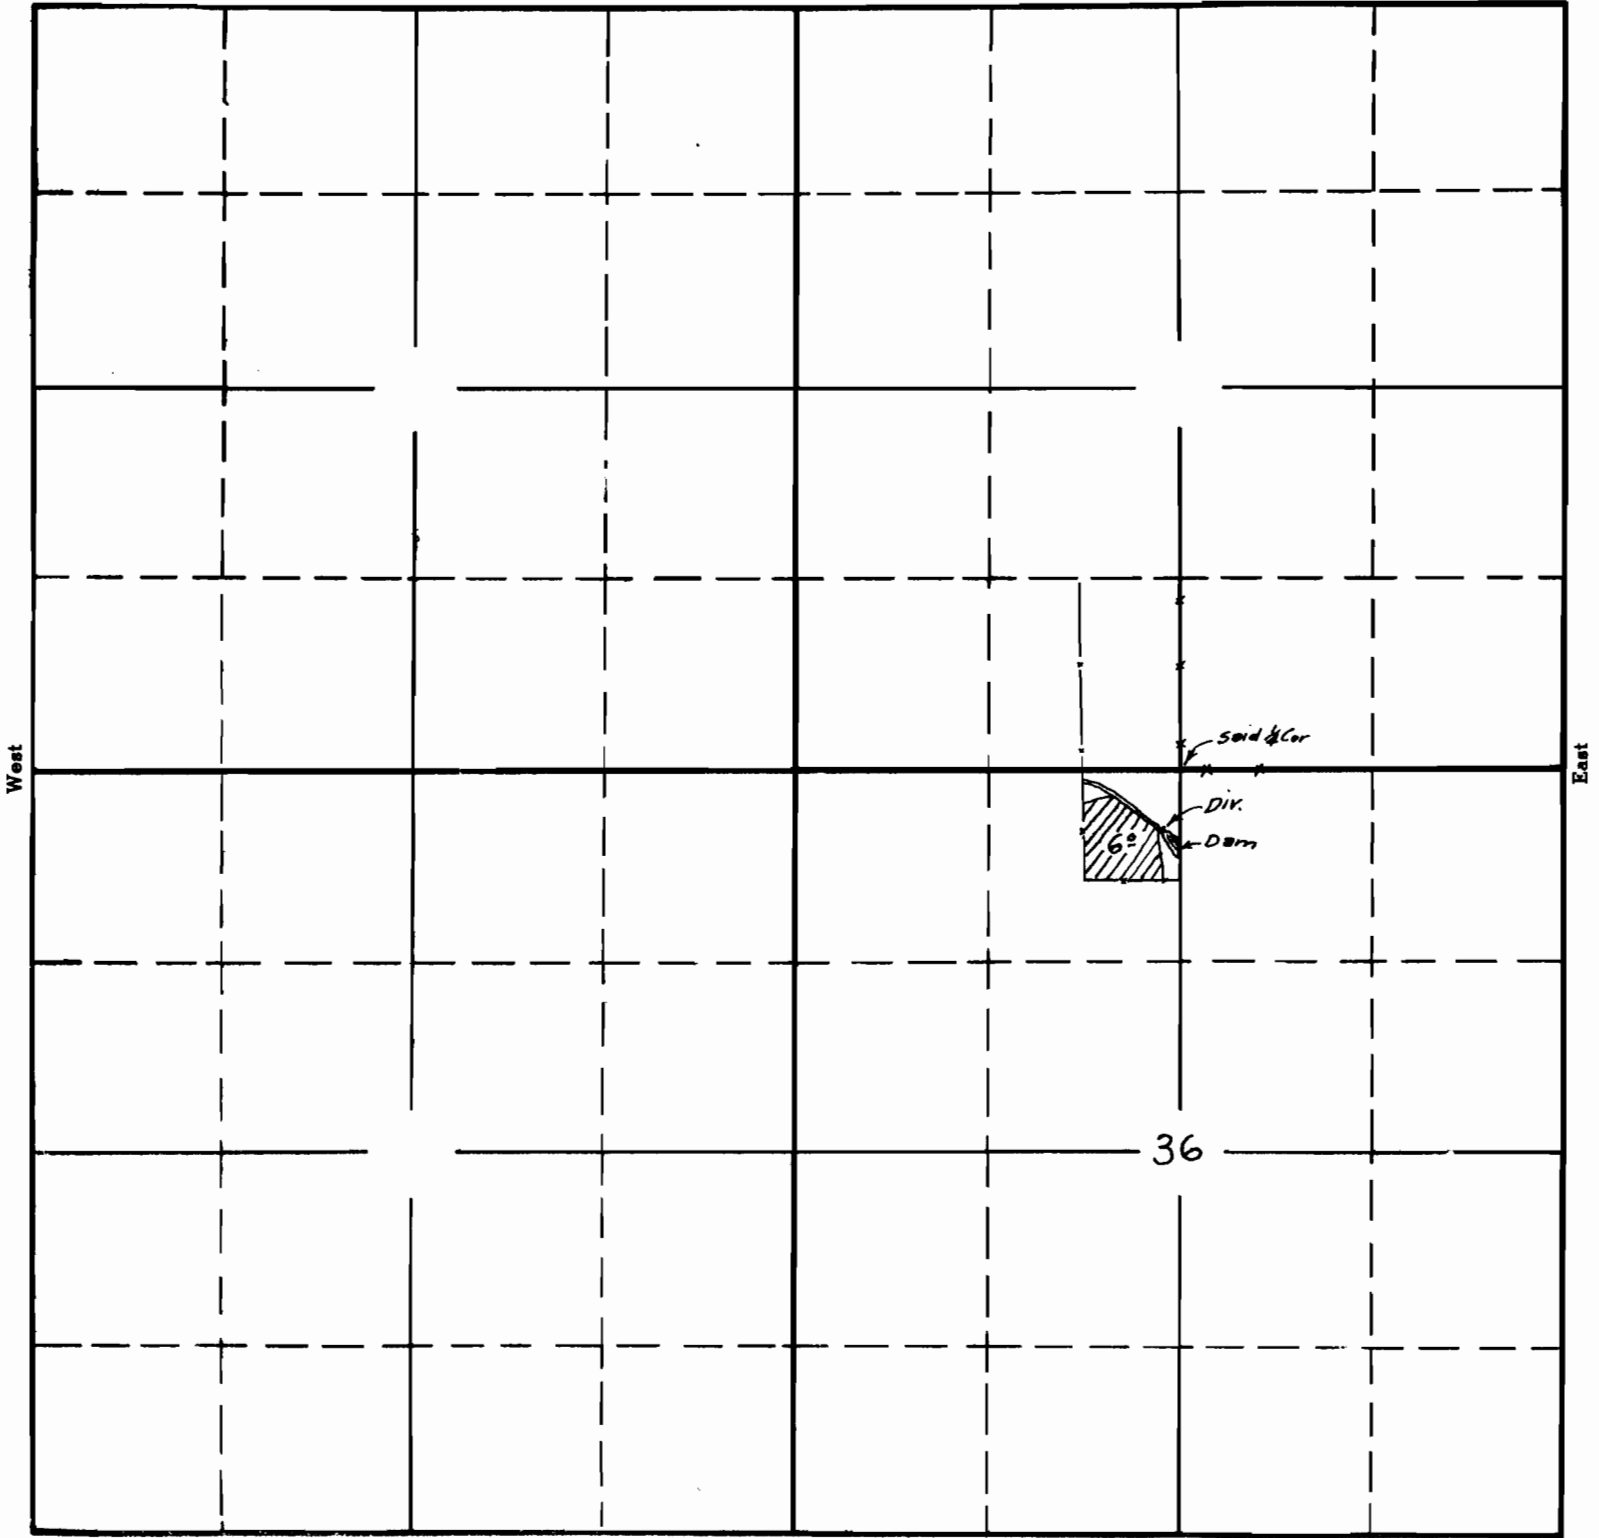

West

East

South


APPLICATION No. 16734
PERMIT No. 12517

SECTION

36

TOWNSHIP 15 , RANGE 3 W, W. M.

North

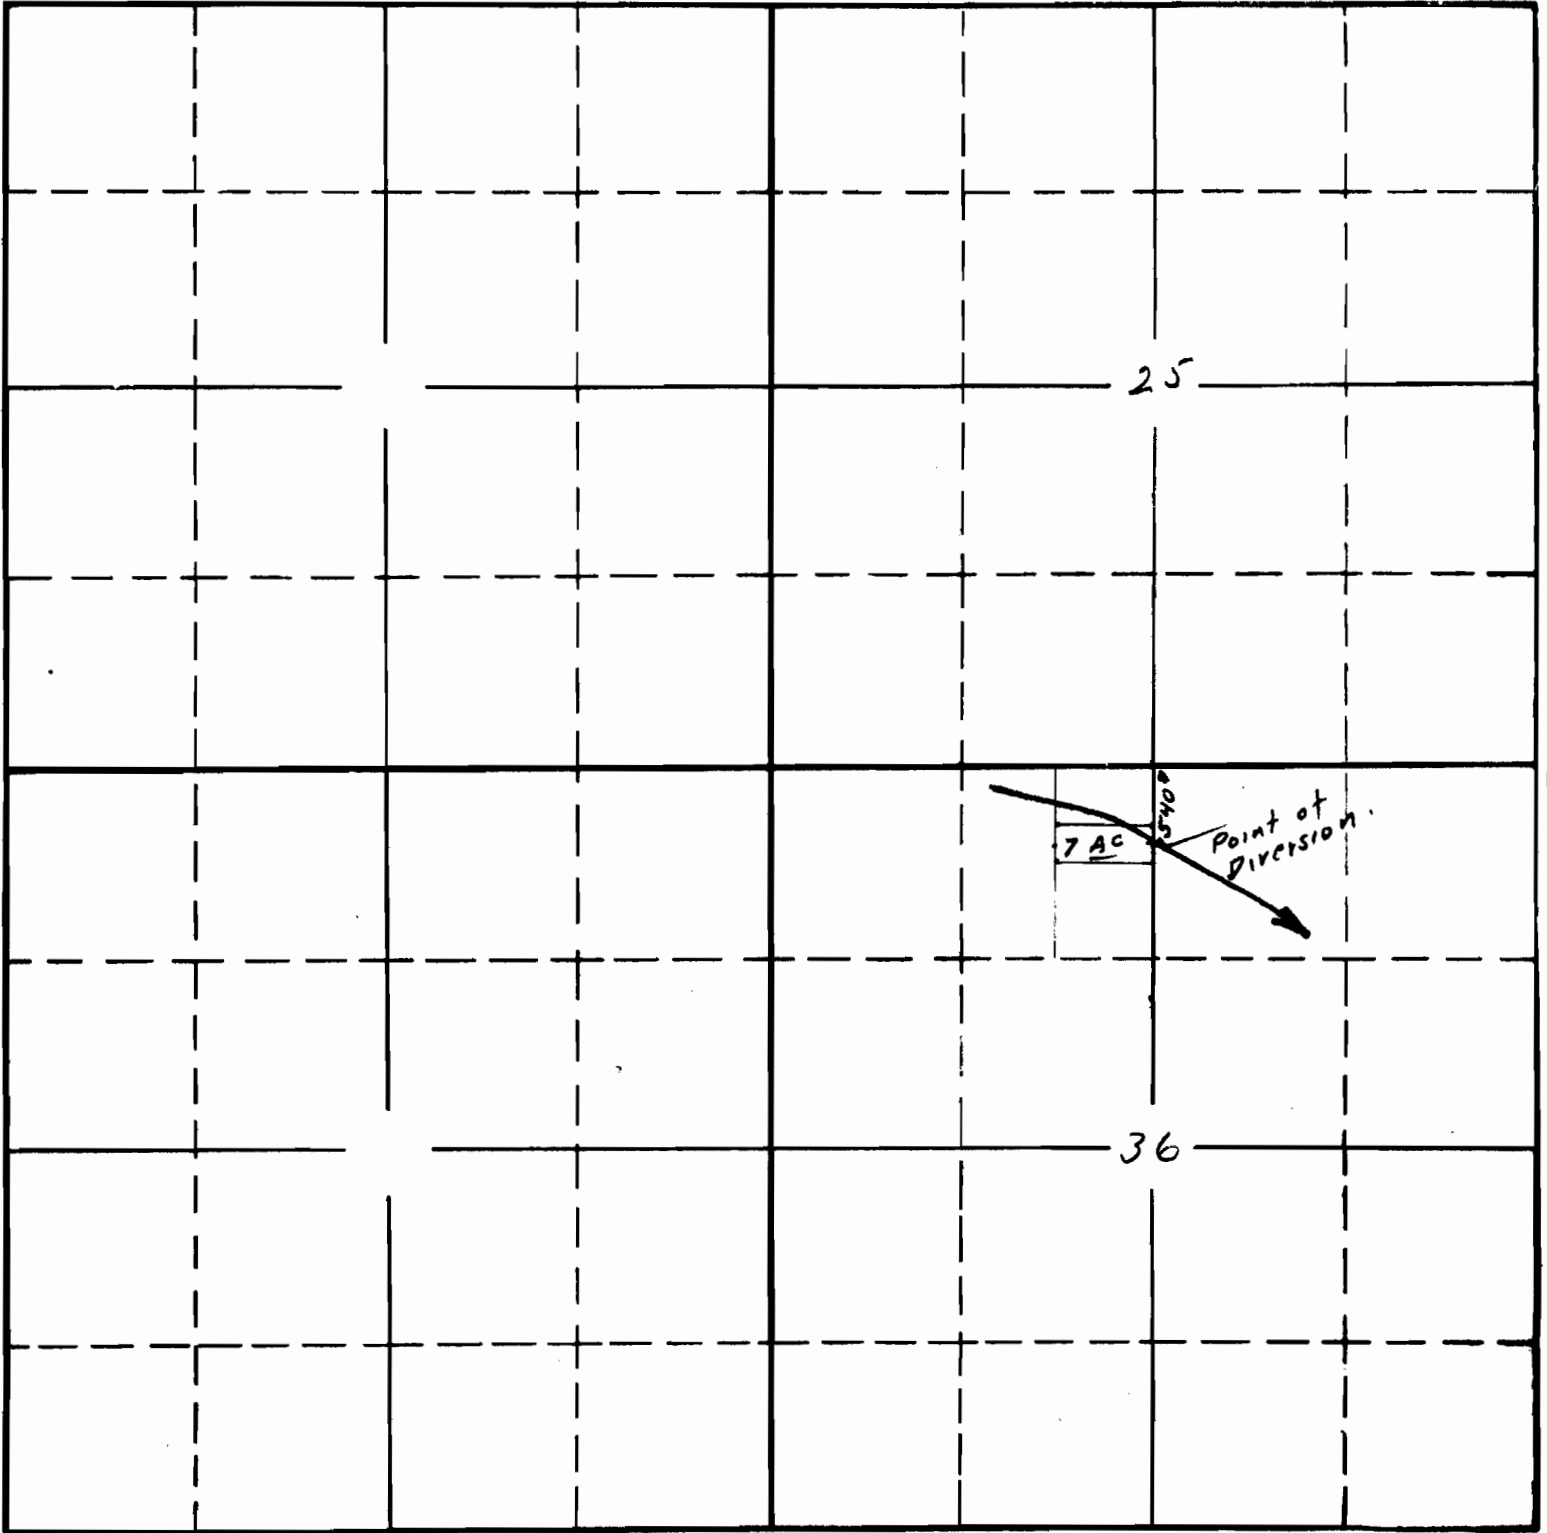

West

East

South

2-65 B-16734-1
APPLICATION No. 16734
PERMIT No. 12517