


SECTION

8

TOWNSHIP 25 , RANGE R2W, W. M.

North

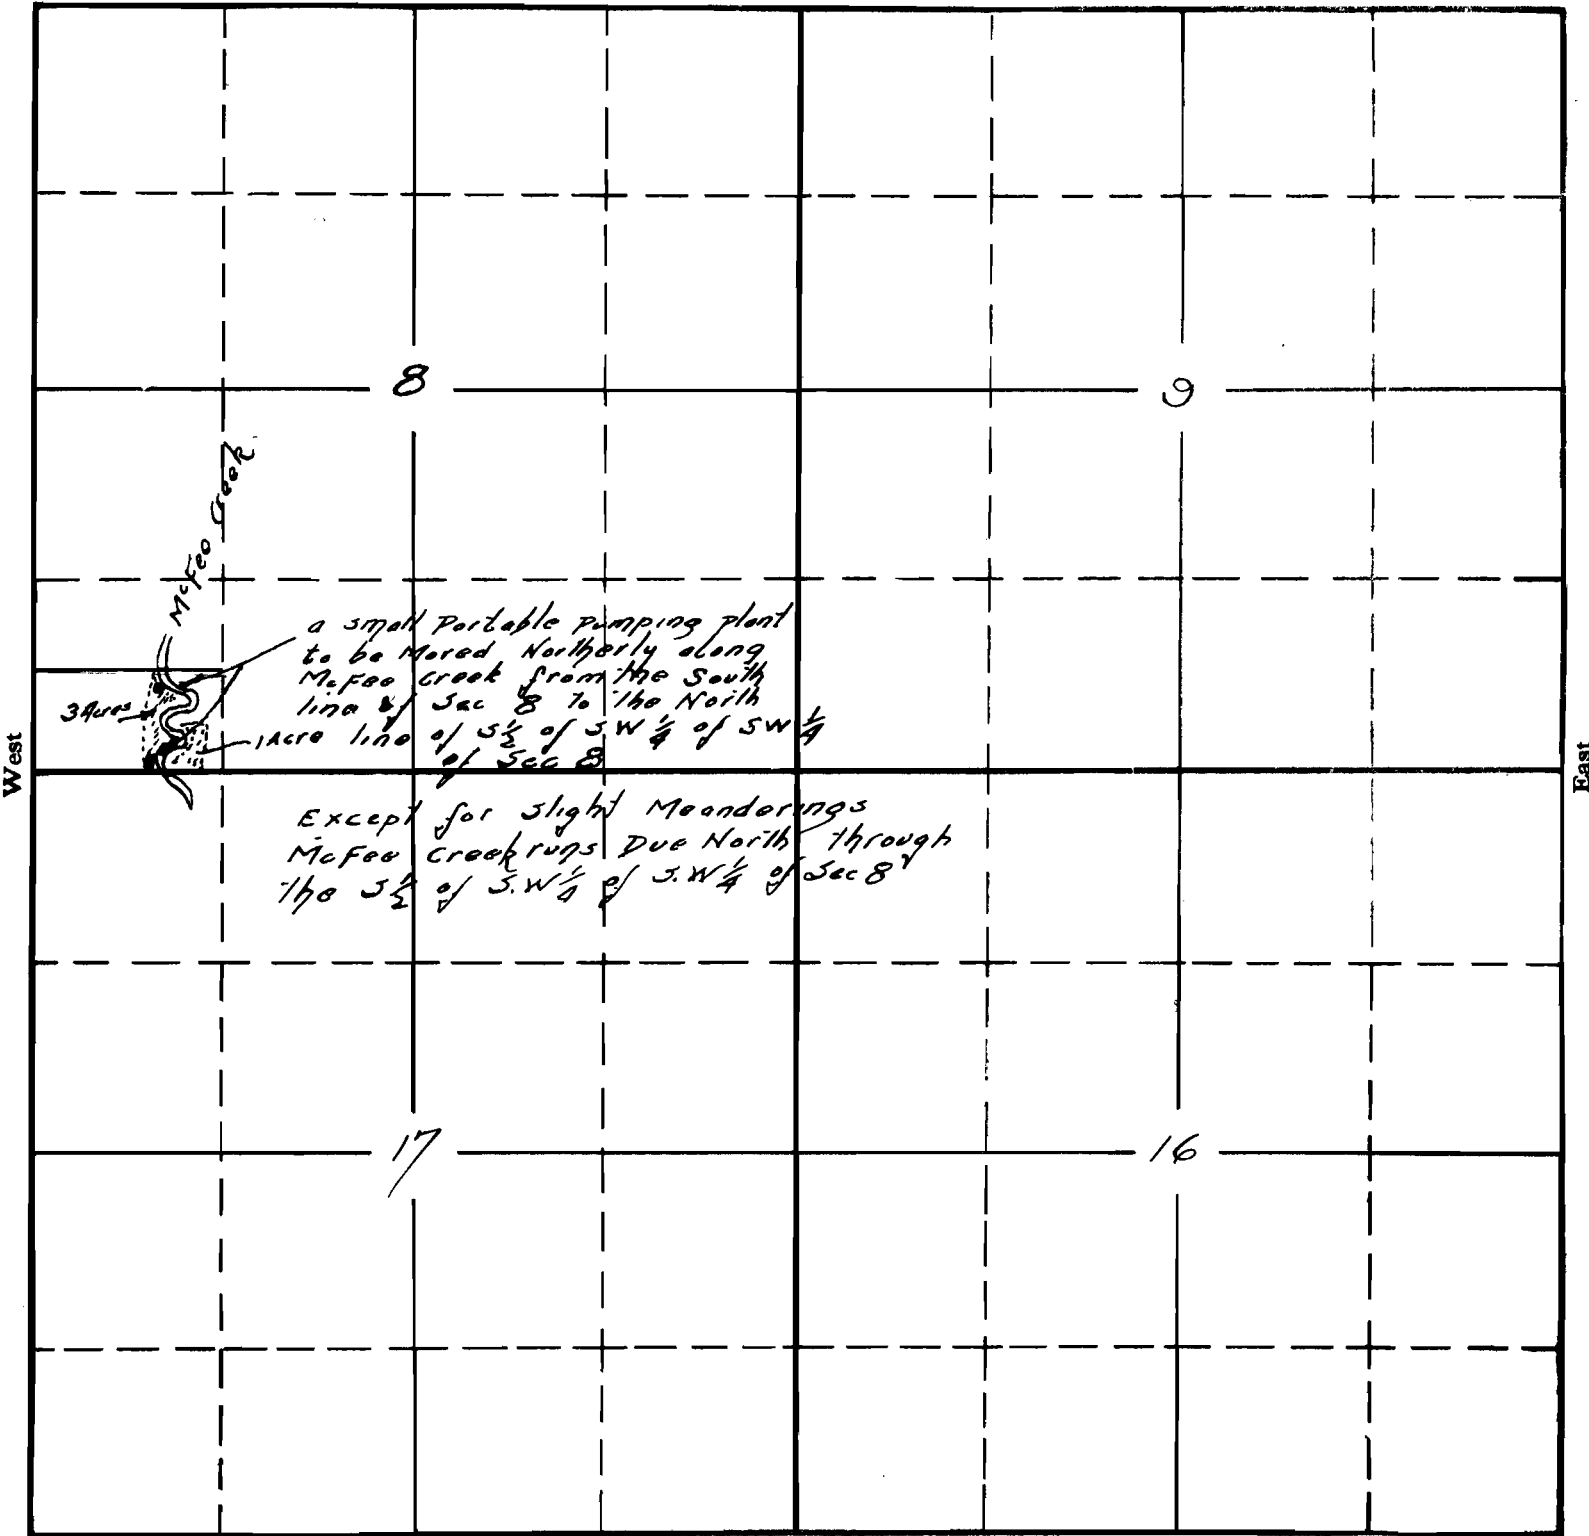

South

2-62C-16742
 APPLICATION No. 16742
 PERMIT No. 12524