


SECTION

6

Buckhorn Cabin

TOWNSHIP 32 S., RANGE 1 E., W. M.

North

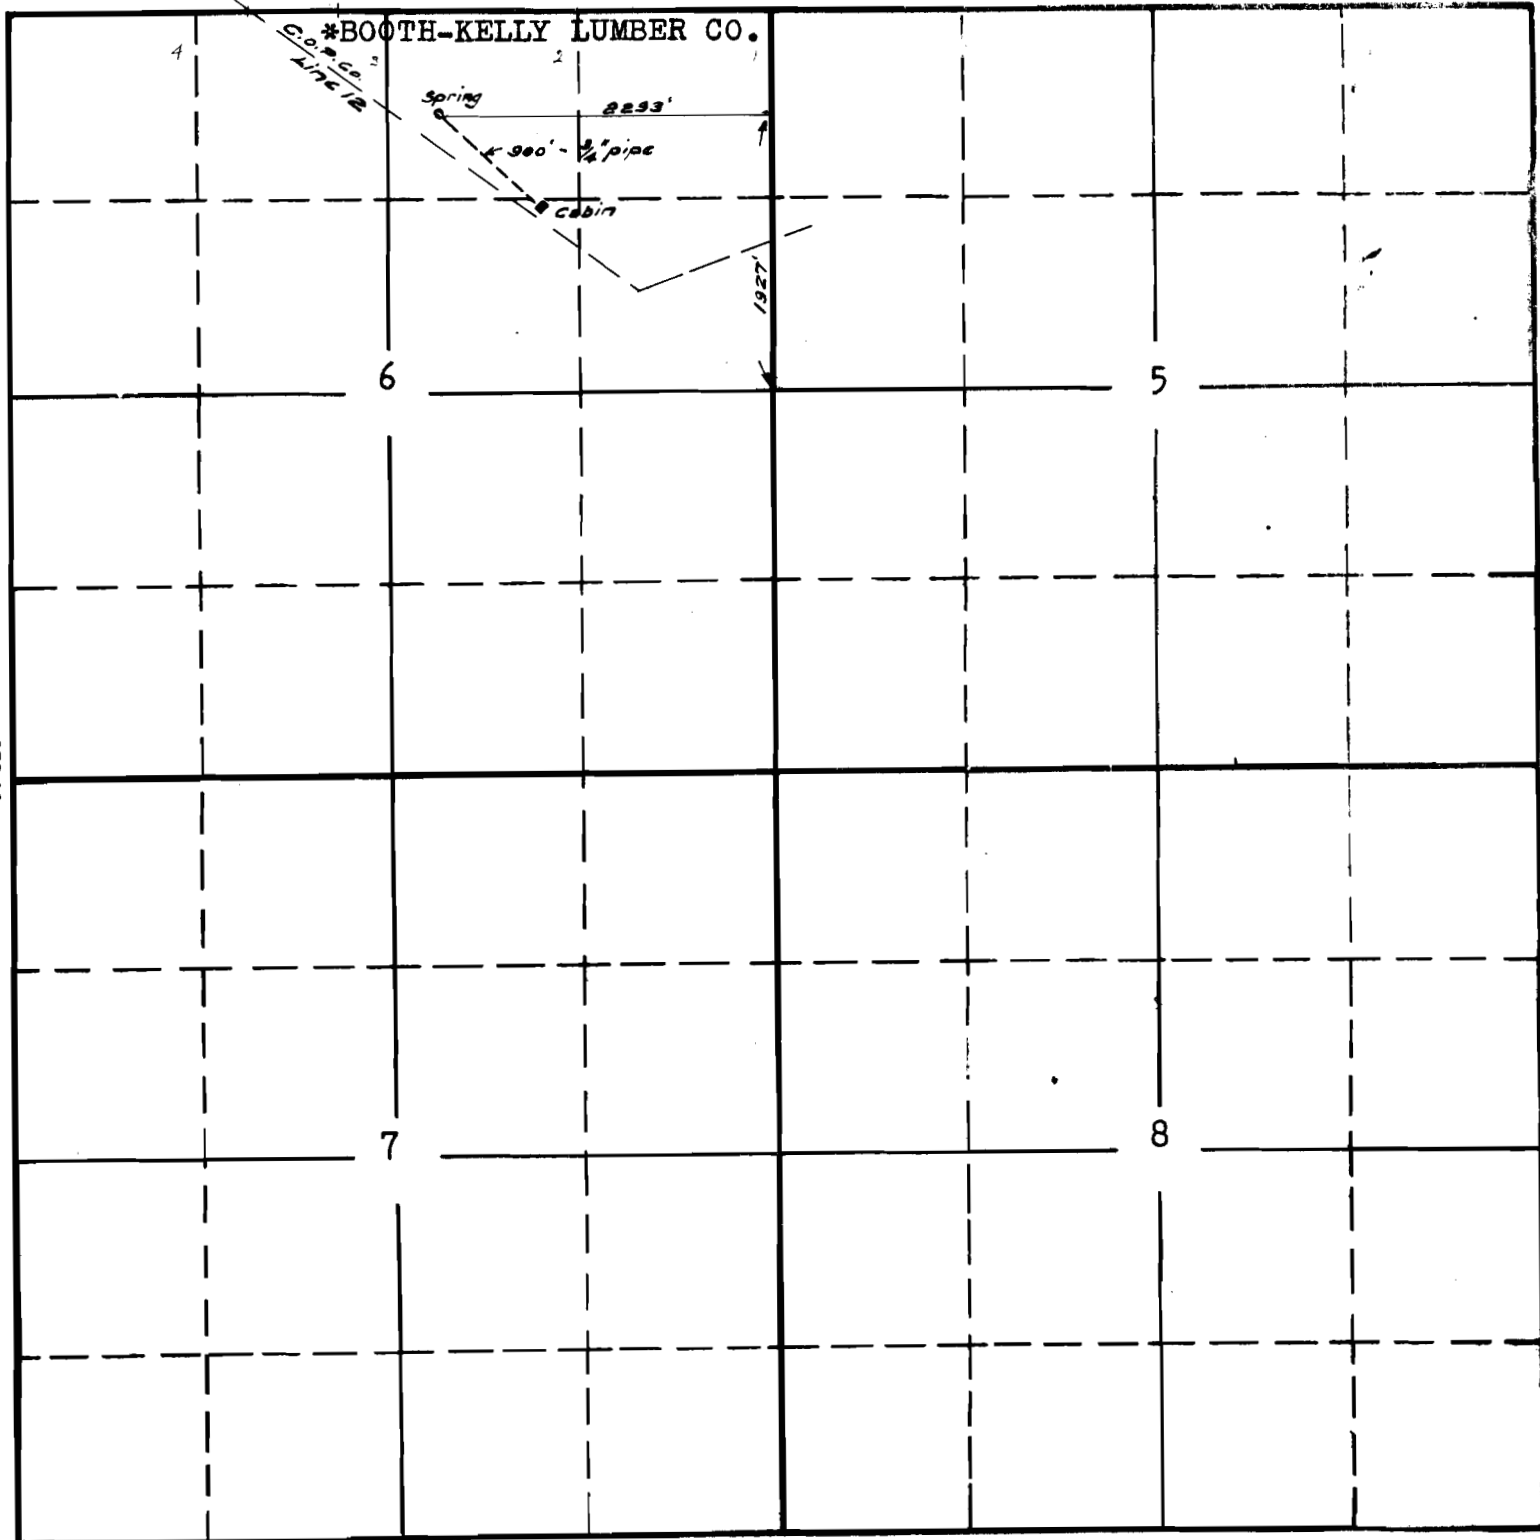

*Booth-Kelly Lumber Co., Eugene, Ore.

South

15-74-16752-4K
APPLICATION No. 16752
PERMIT No. 12532