


SECTION

27

McLeod Cabin

TOWNSHIP 33 S., RANGE 1 E., W. M.

North

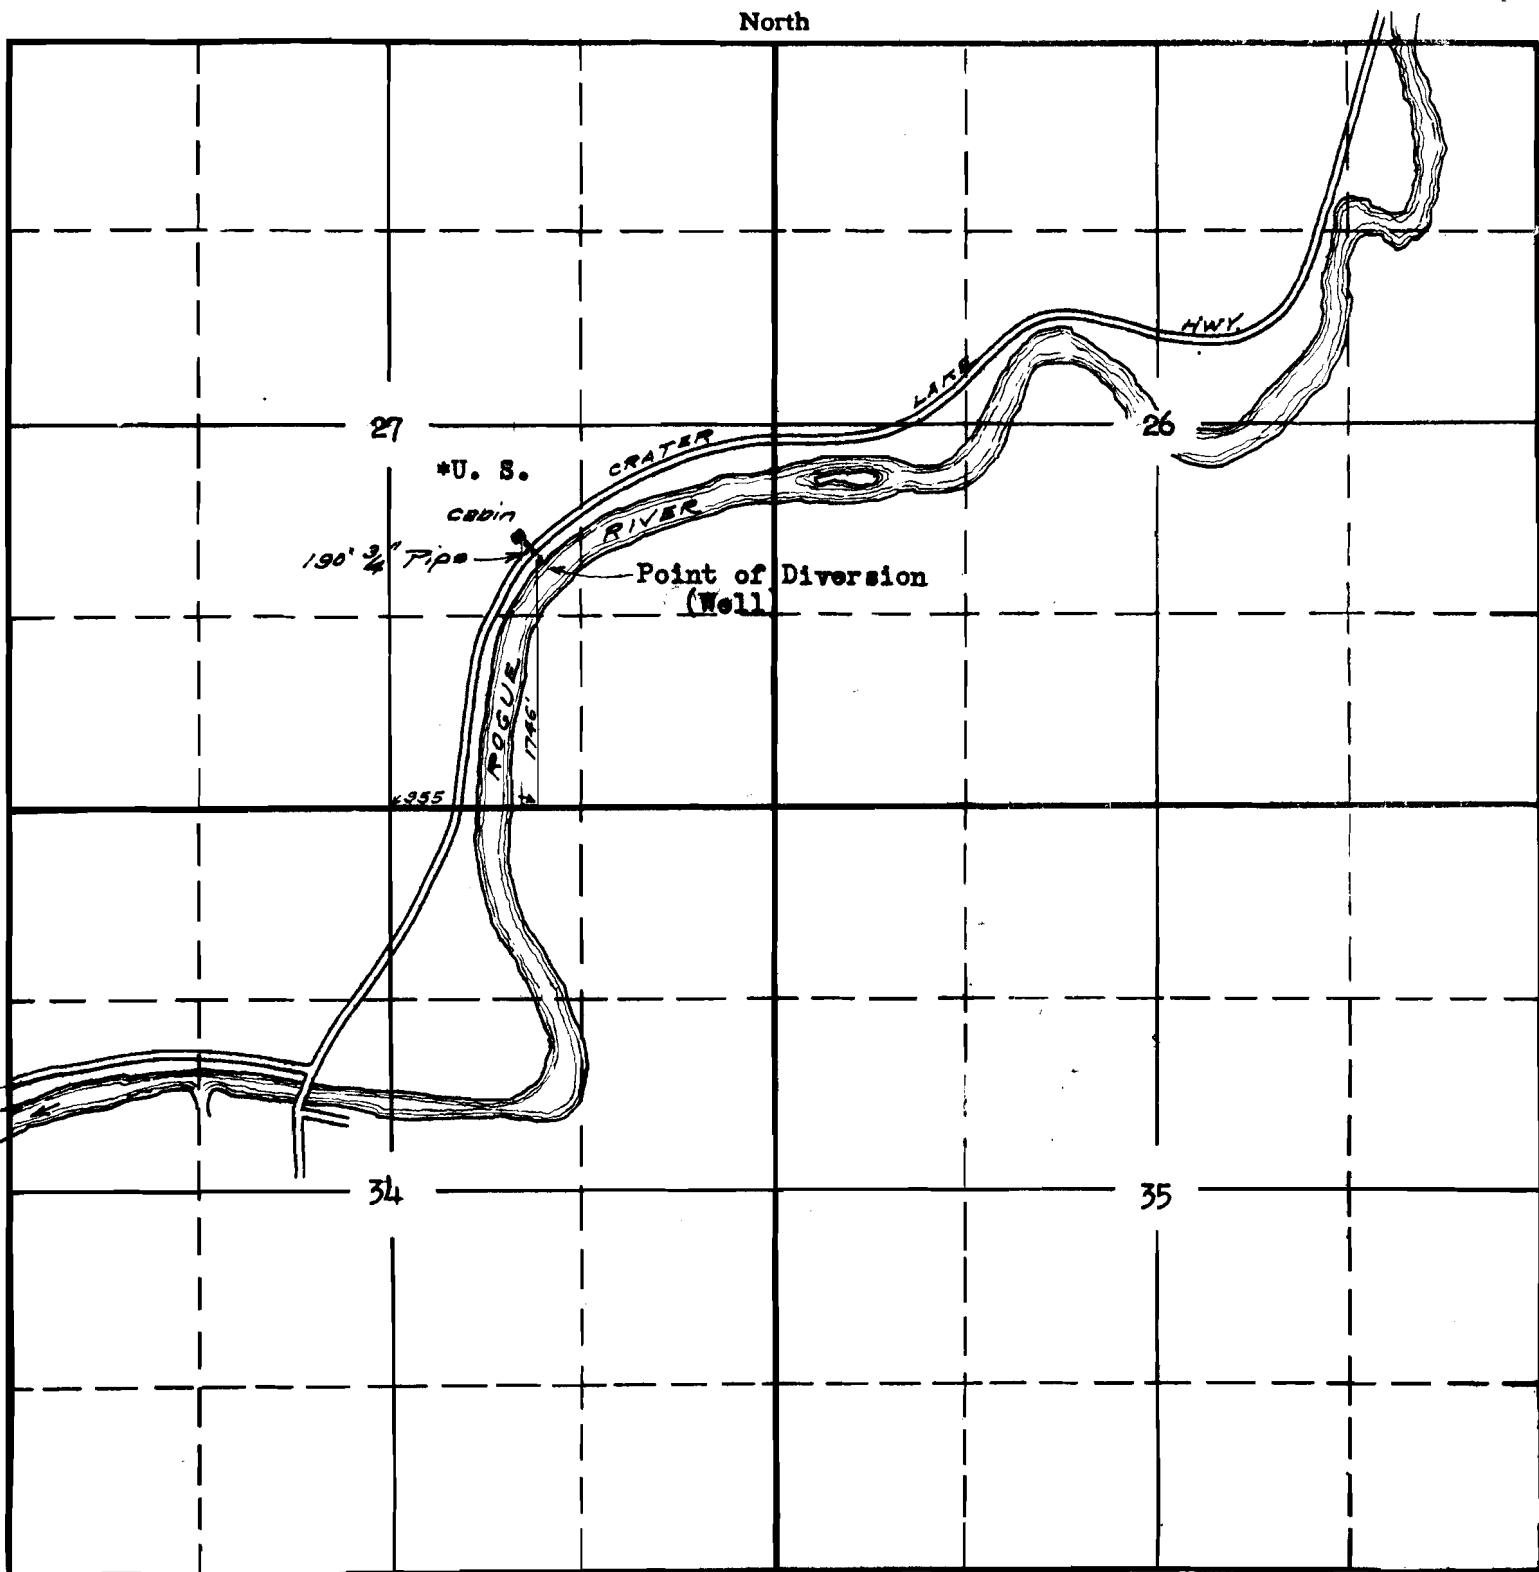

South

Note\* Well at river edge is located on U. S. power site reservation.

15- - 16753-OK-  
APPLICATION No. 16753  
PERMIT No. 12533