


SECTION

14
SW 4 of
SE 4 of
NW 4

Sec. 14 TOWNSHIP 4N, RANGE 28E, W. M.

North

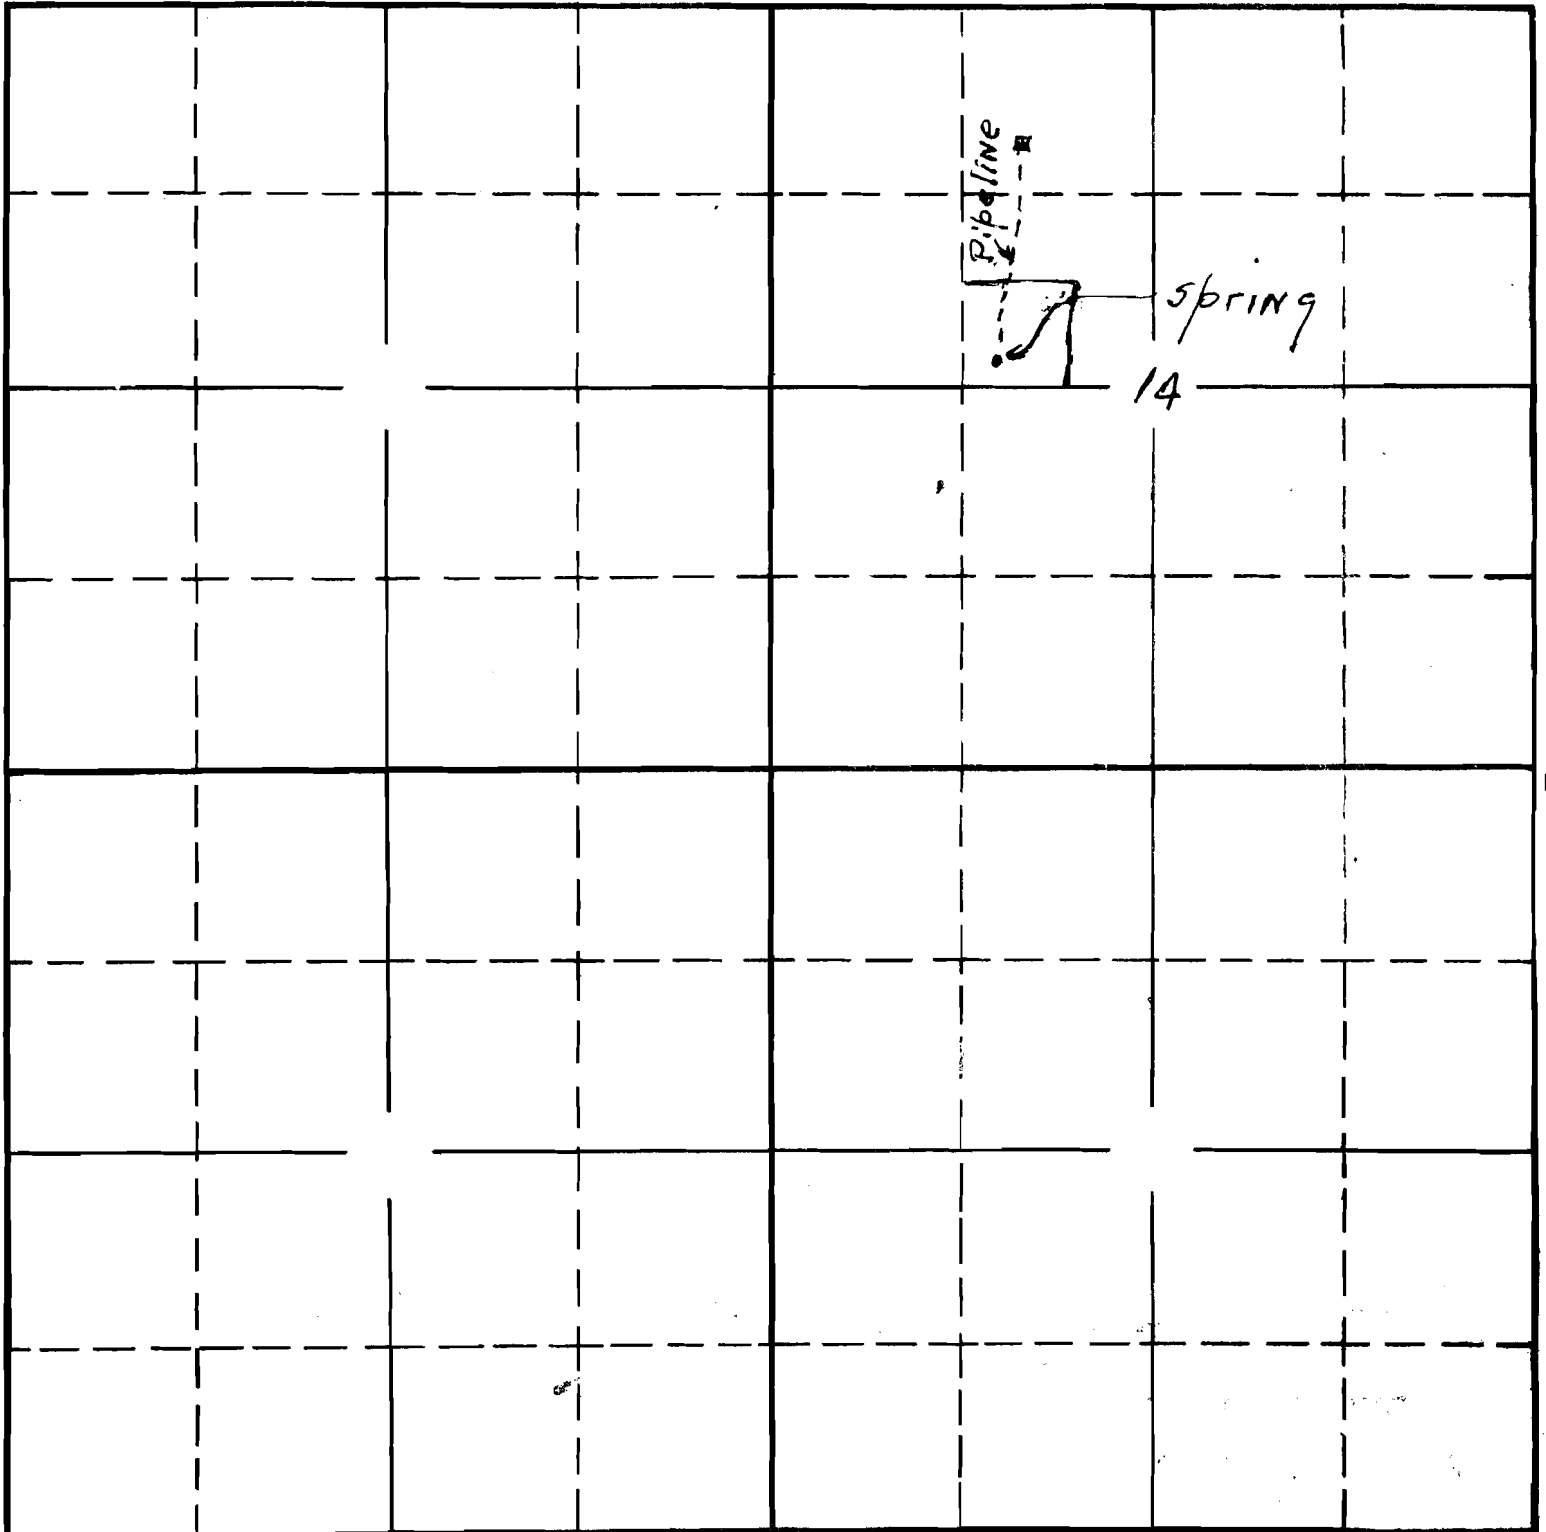

West

East

South

Spring is located
190 Ft E and 120 Ft N
of SW Cor of SW 4 SE 4 NW 4 Sec. 14 T 4N R 28E

7-15-16763-02
APPLICATION No. 16763
PERMIT No. 12549