


TOWNSHIP 5S., RANGE 2E, W. M.

North

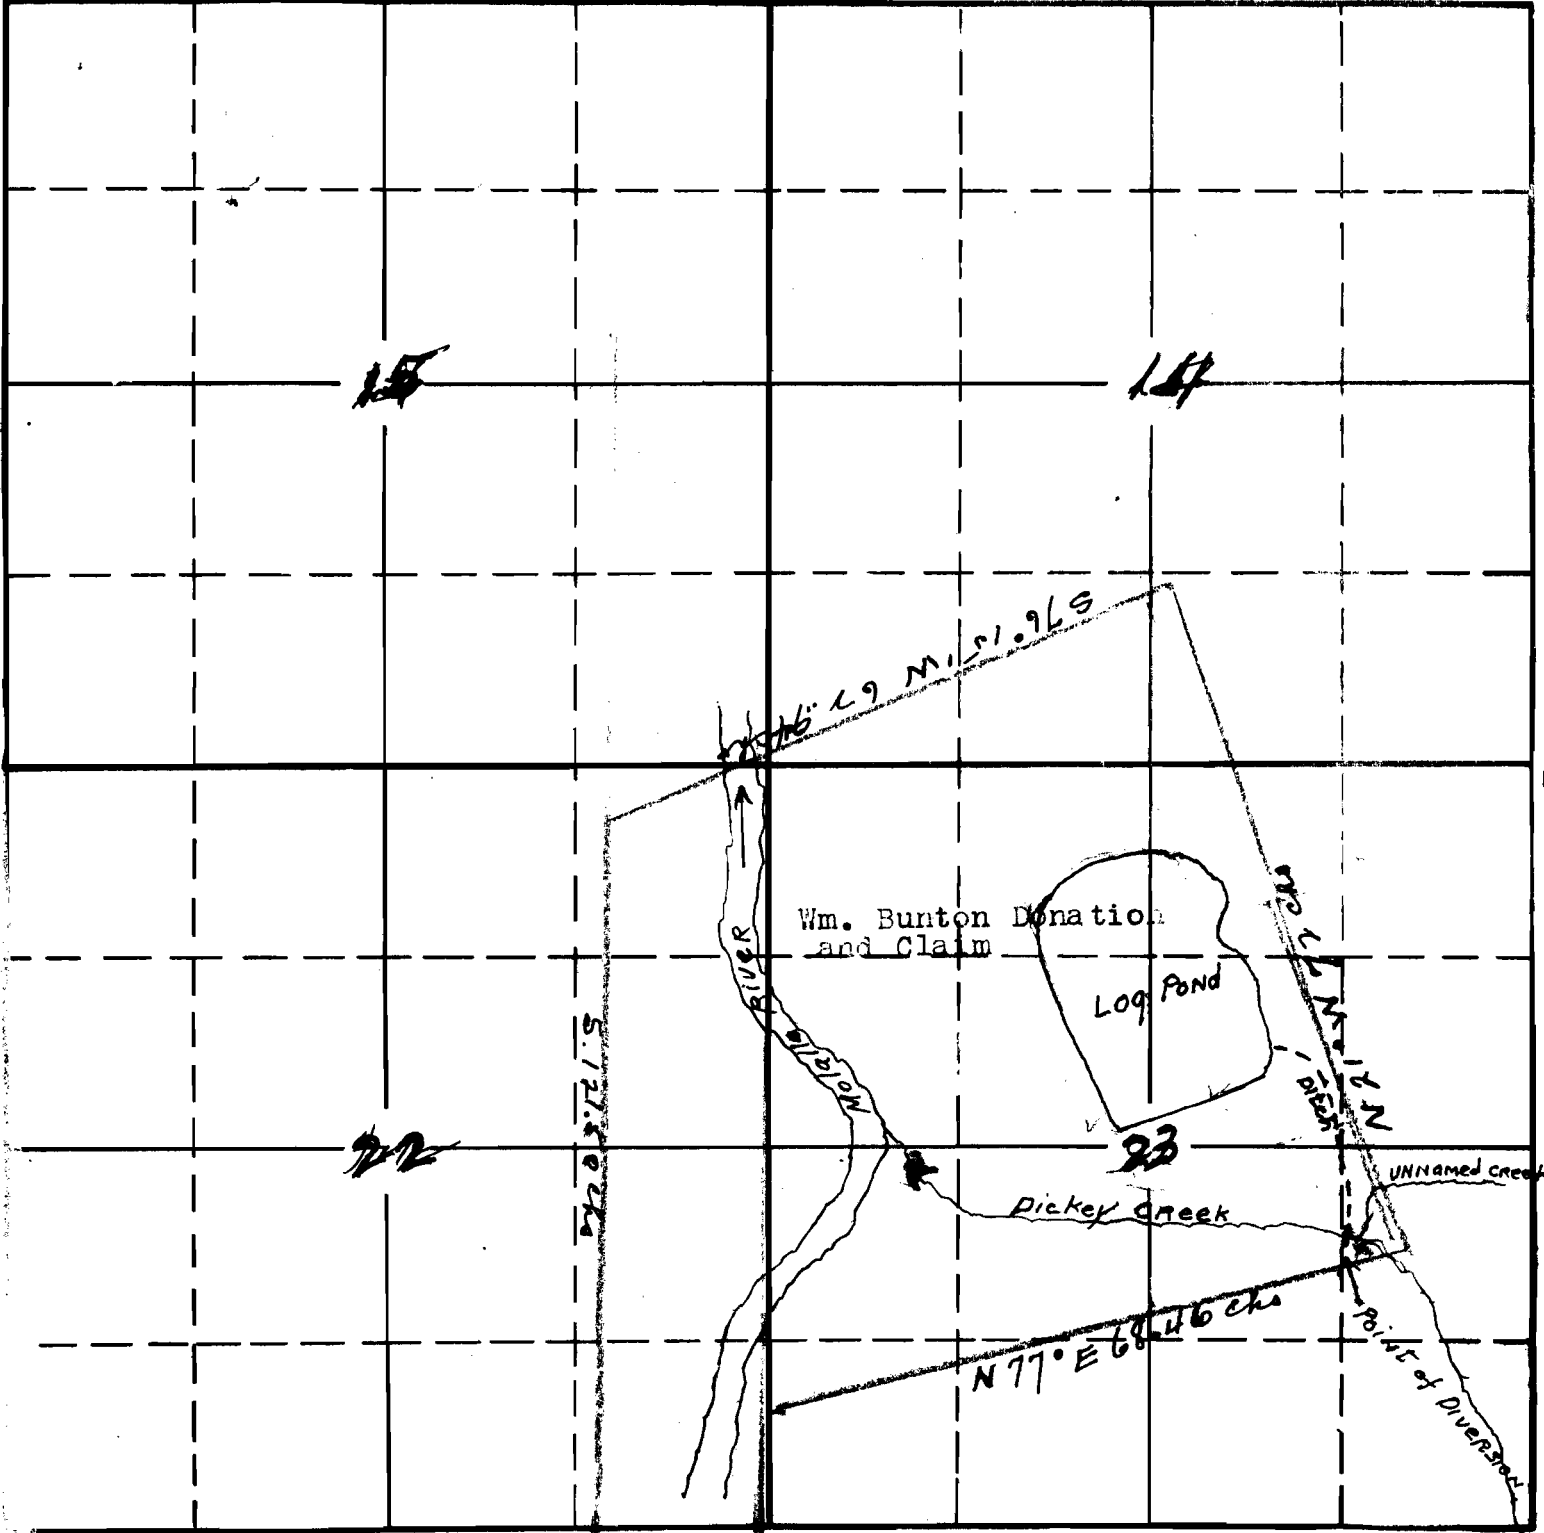

East

South

2-32A-16764-OK  
 APPLICATION No. 16764  
 PERMIT No. 12551

