
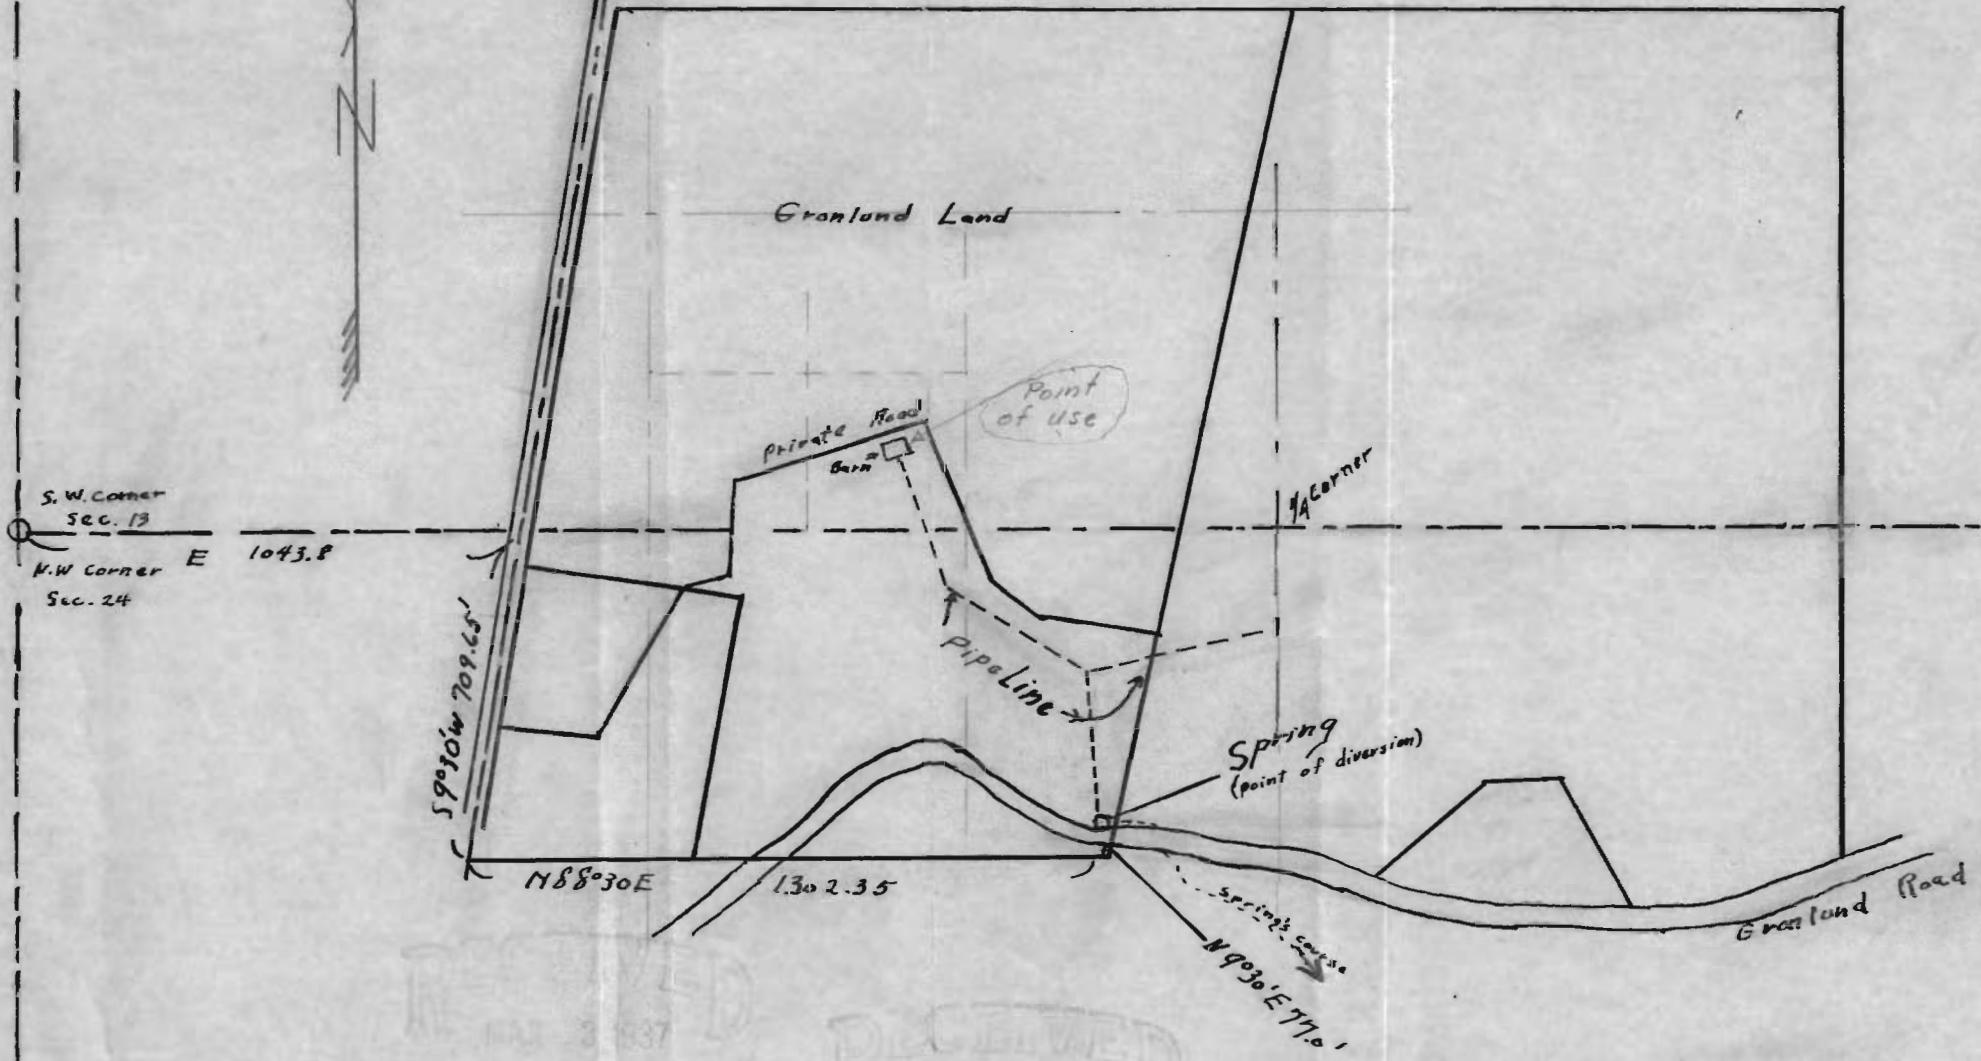
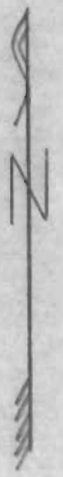


Application No. 16770
Permit No. 12552
2-10-16770 *OK*

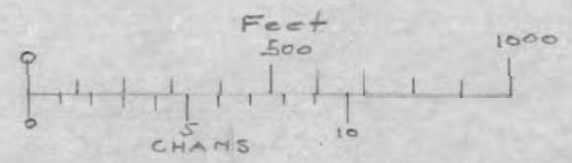

Prepared by:
George L. Hibbard
Butler Bldg.
Oregon City, Oregon

RECEIVED
FEB 13 1937
STATE ENGINEER
OREGON

Sec. 24
T. 25. R. 2. E
1" = 400'