


SECTION

21

TOWNSHIP 15, RANGE 2W, W. M.

North

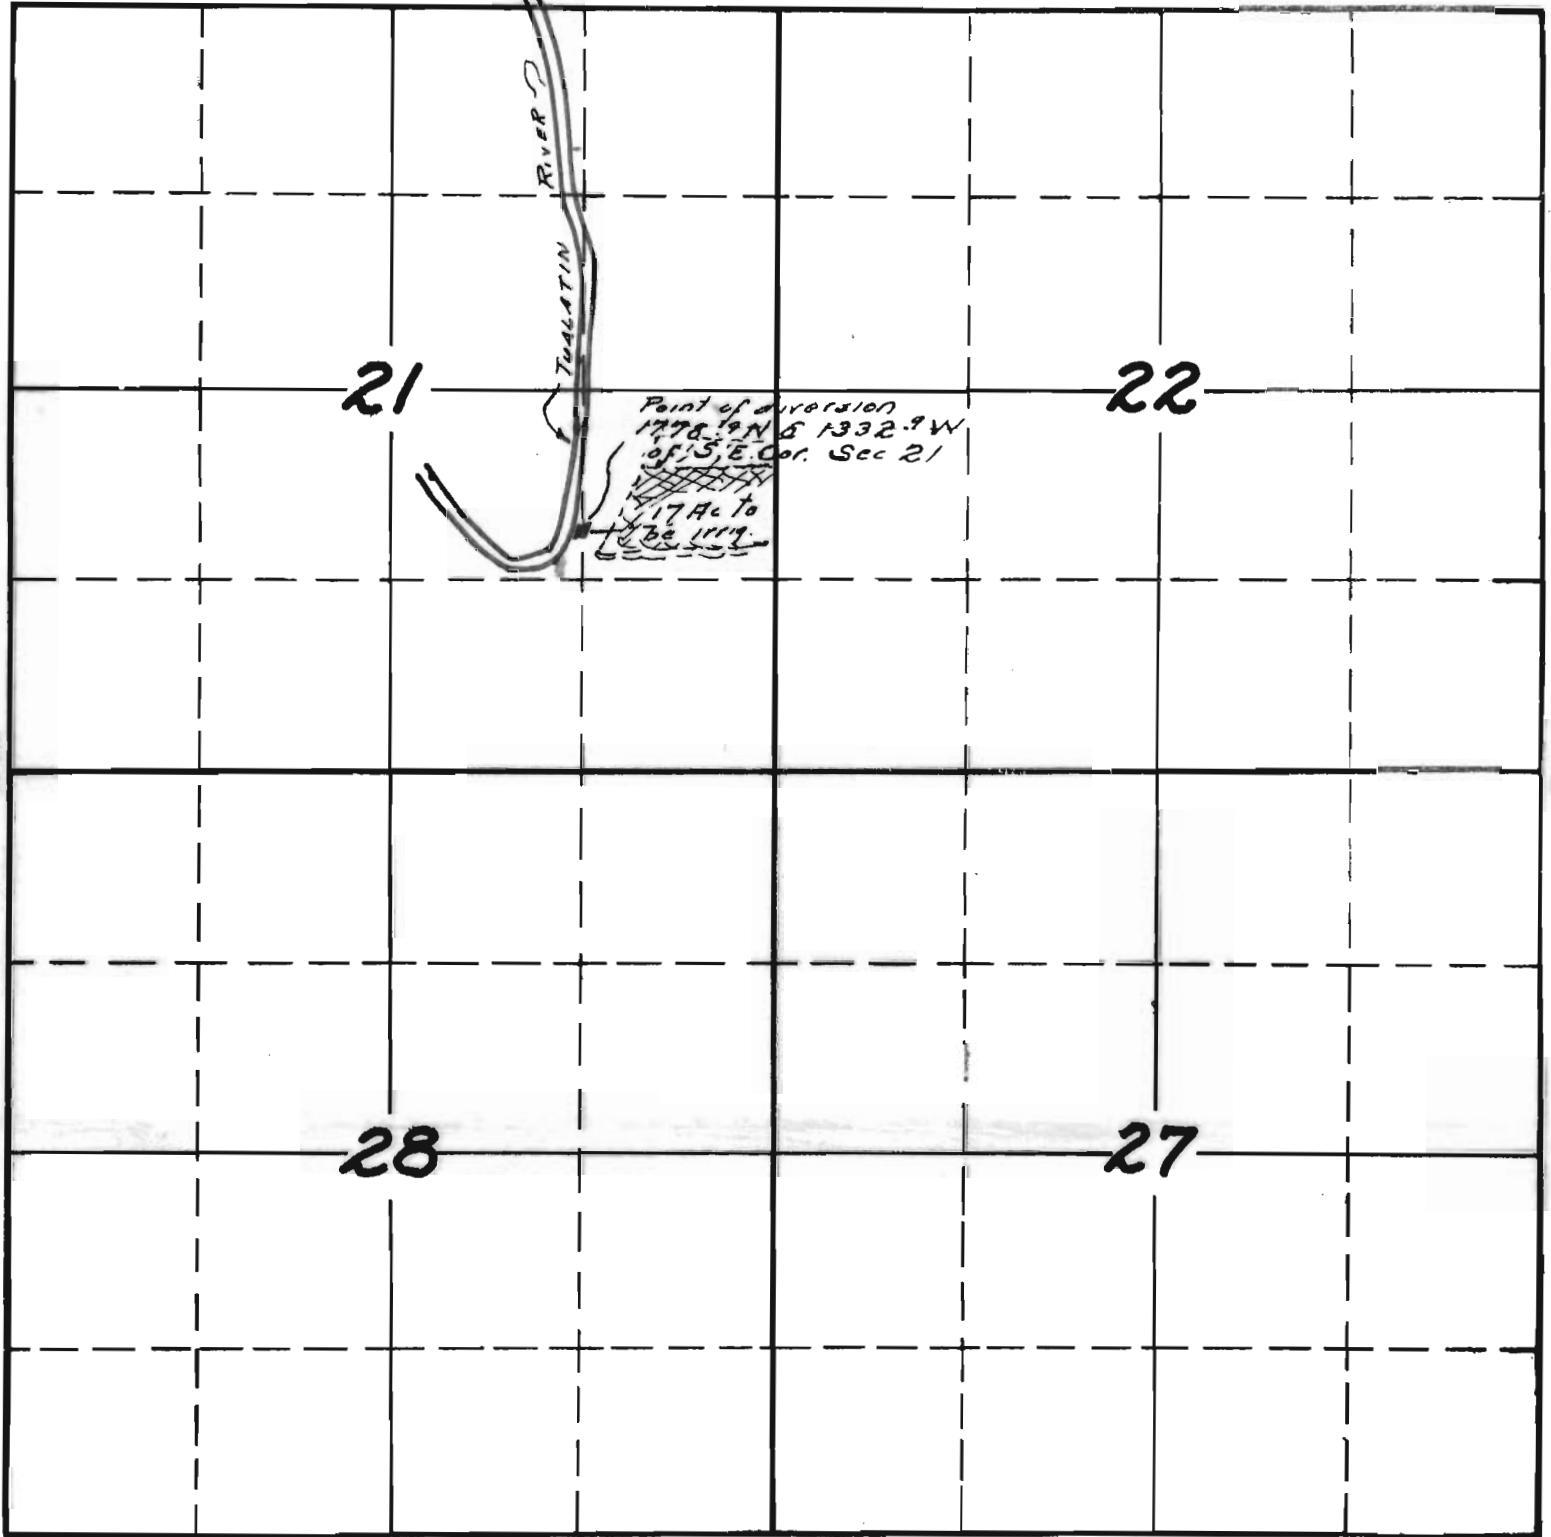

South

RECEIVED  
 FEB 22 1937  
 STATE ENGINEER  
 SALEM, OREGON


2-53-16777-OK  
 APPLICATION No. 16777  
 PERMIT No. 12558

SECTION

\_\_\_\_\_  
\_\_\_\_\_  
\_\_\_\_\_

TOWNSHIP 15, RANGE 2W., W. M.

North

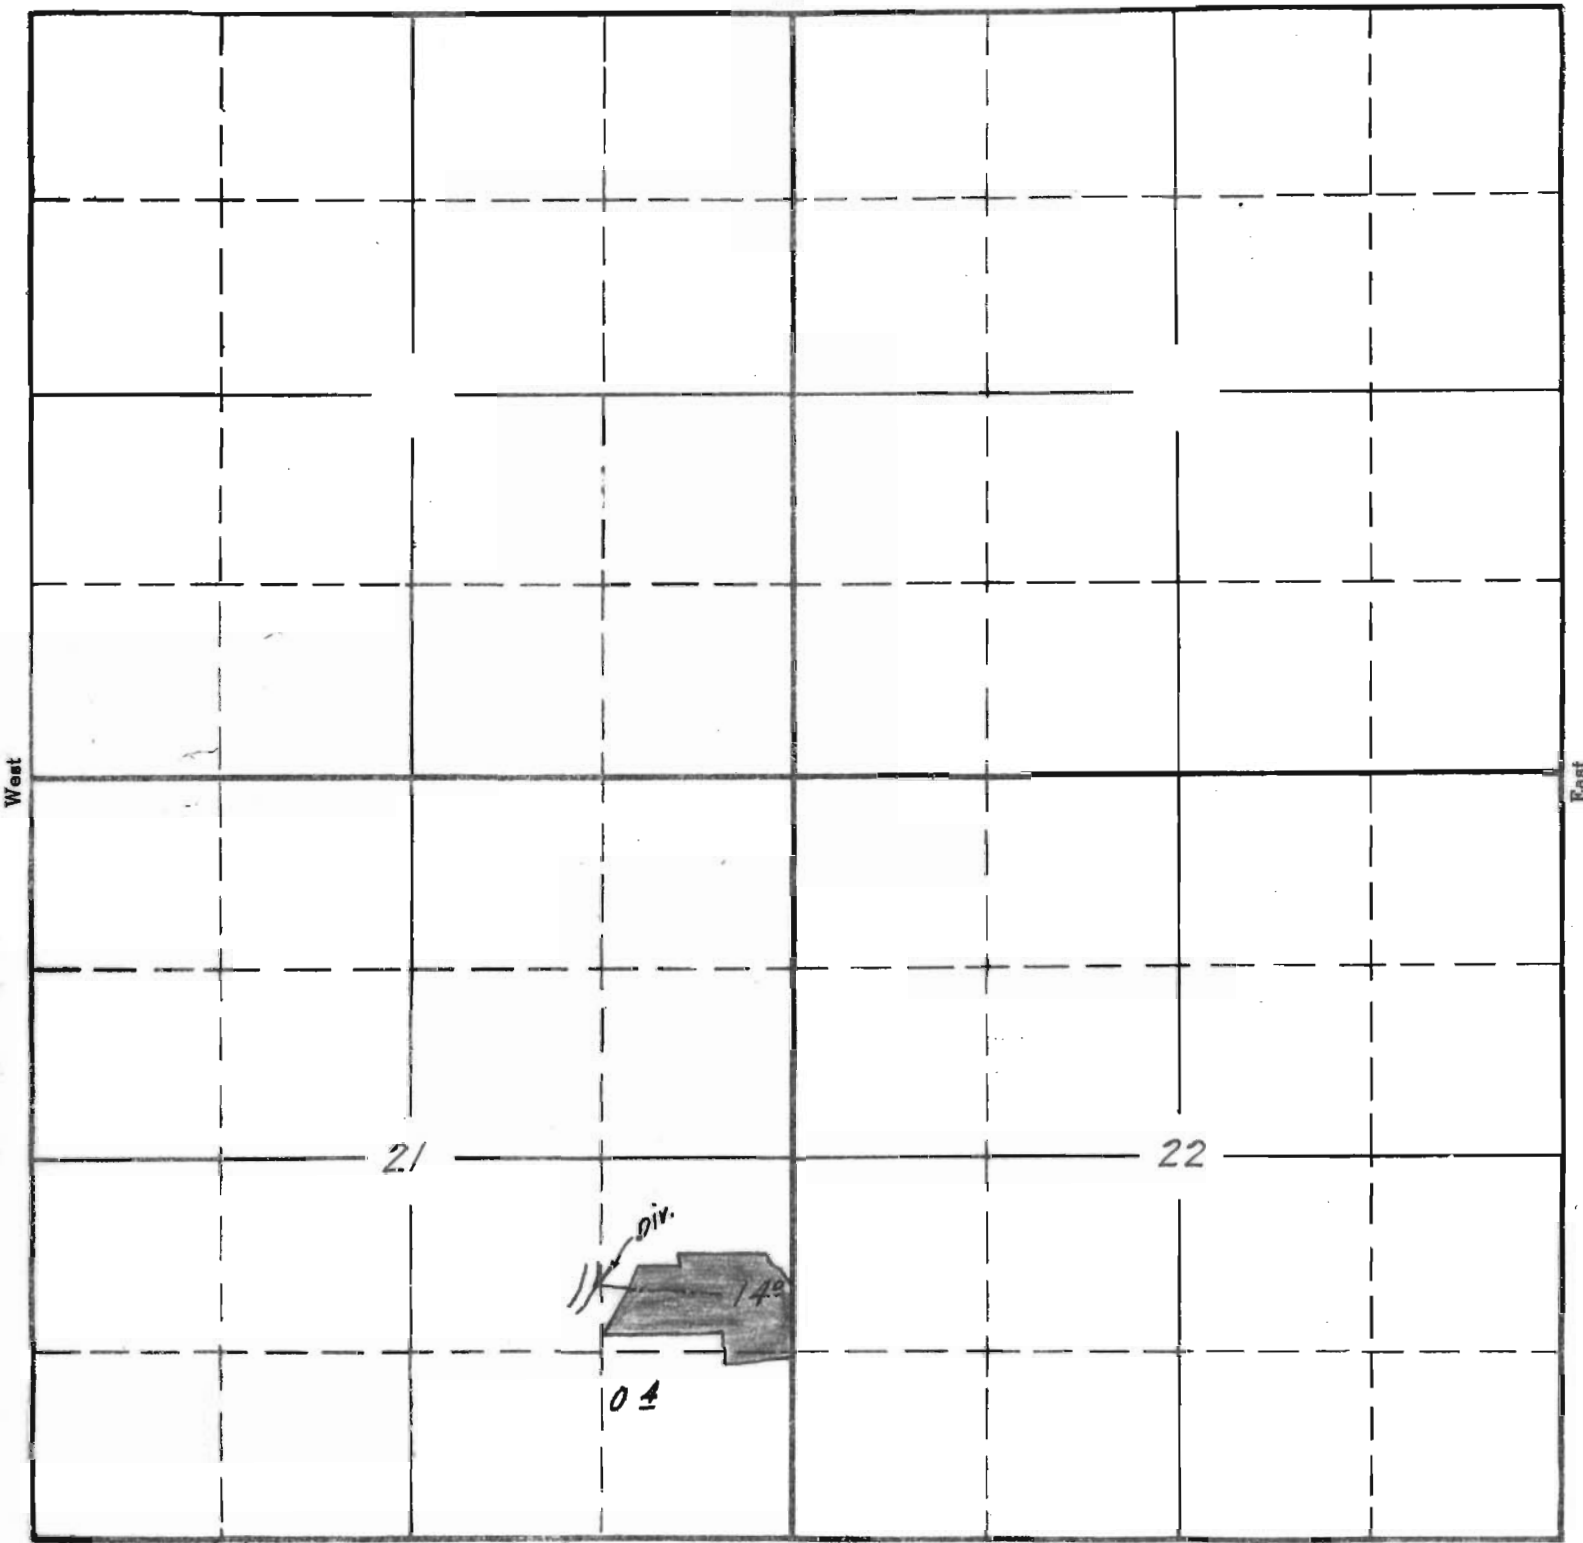

*Surveyed June 10 1940 C.A.B.*

South

APPLICATION No. 16777  
PERMIT No. 12558