

SECTION


16

TOWNSHIP 36 S, RANGE 4 W, W. M.

North

West

East

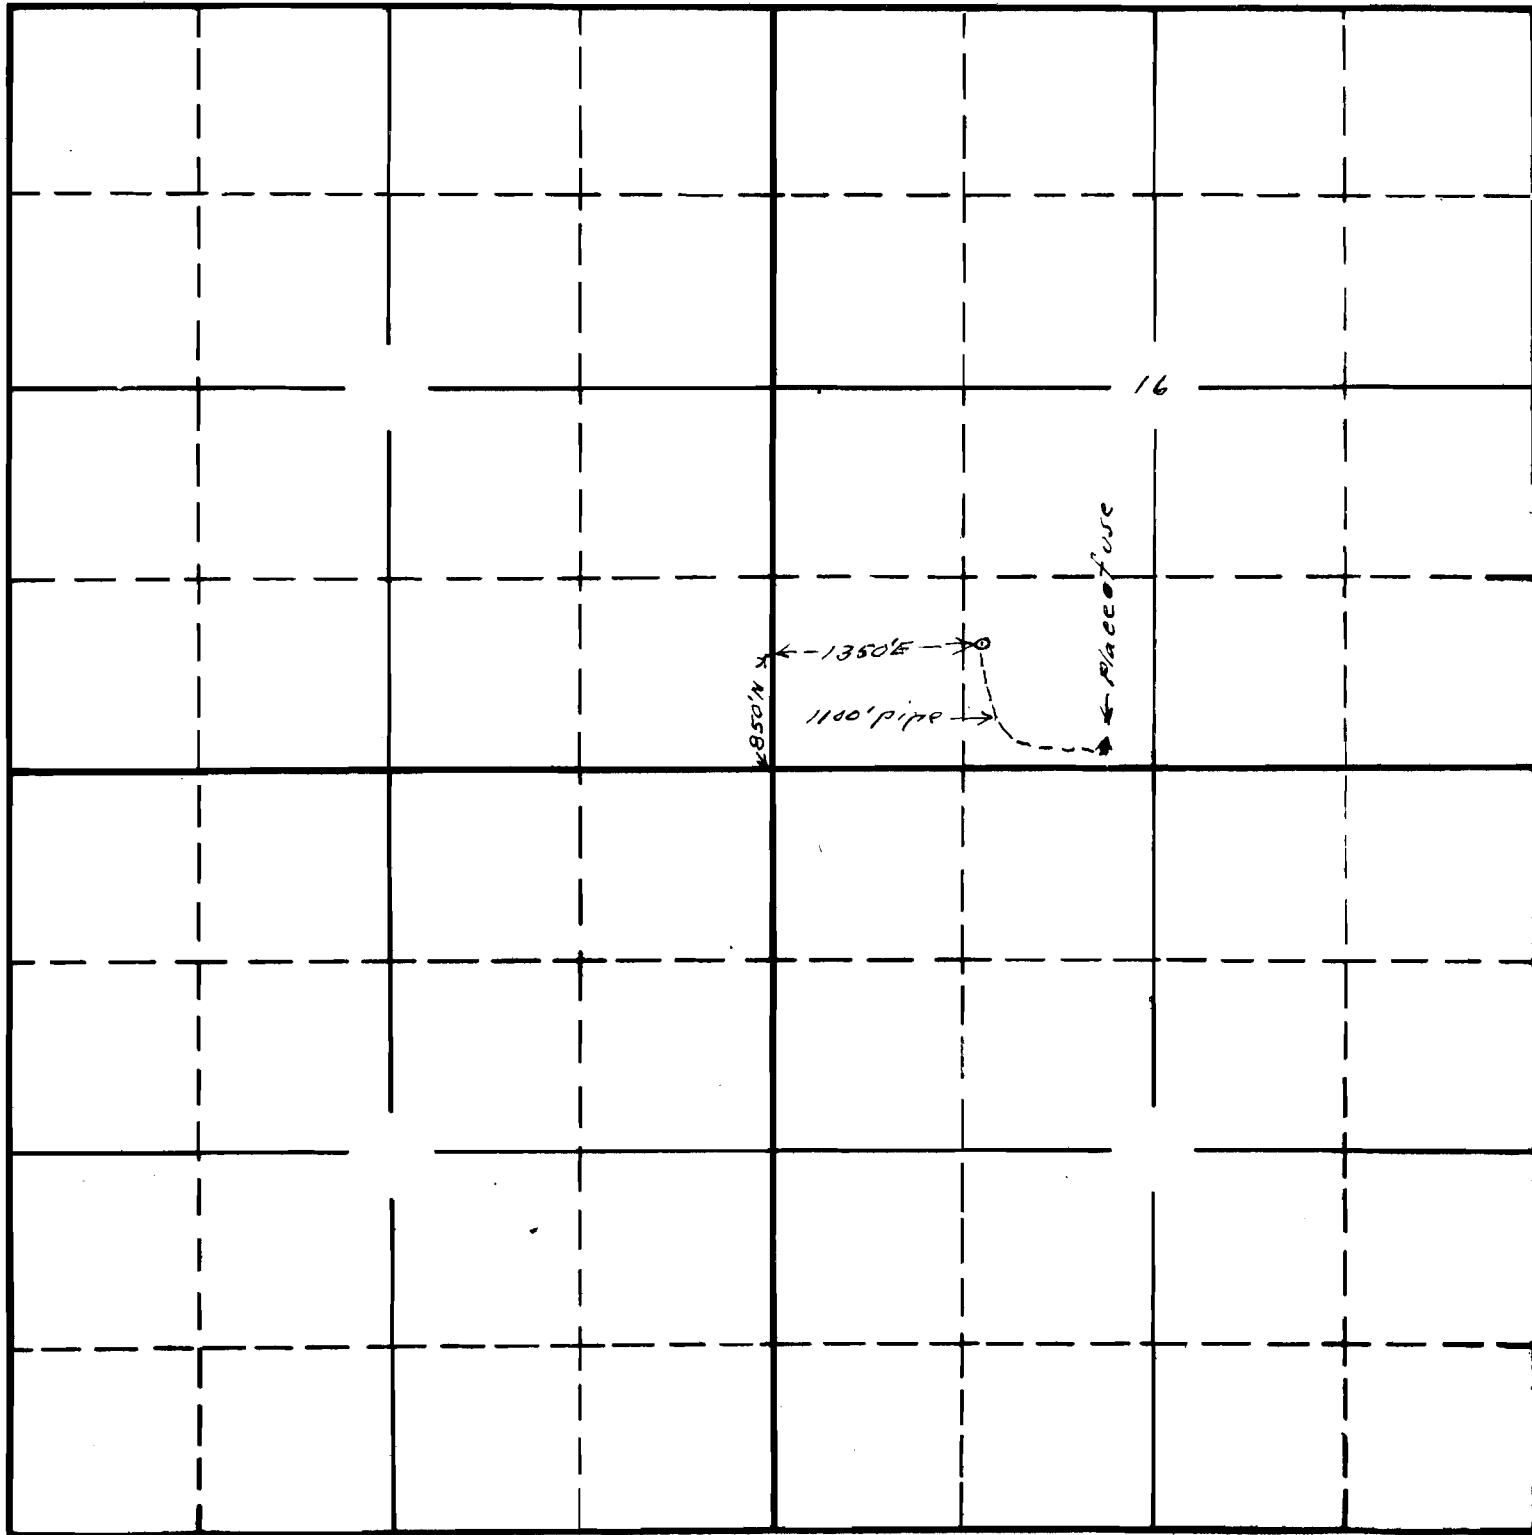

South

Sketch showing location of spring and place
 of use for application of O.L. Richardson
 for domestic and garden use.
 Measurements made in field by O.L.R.

15-74-16817-1
 APPLICATION No. 16817
 PERMIT No. 12581