


SECTION

27

TOWNSHIP 32 S., RANGE 1 E., W. M.

North

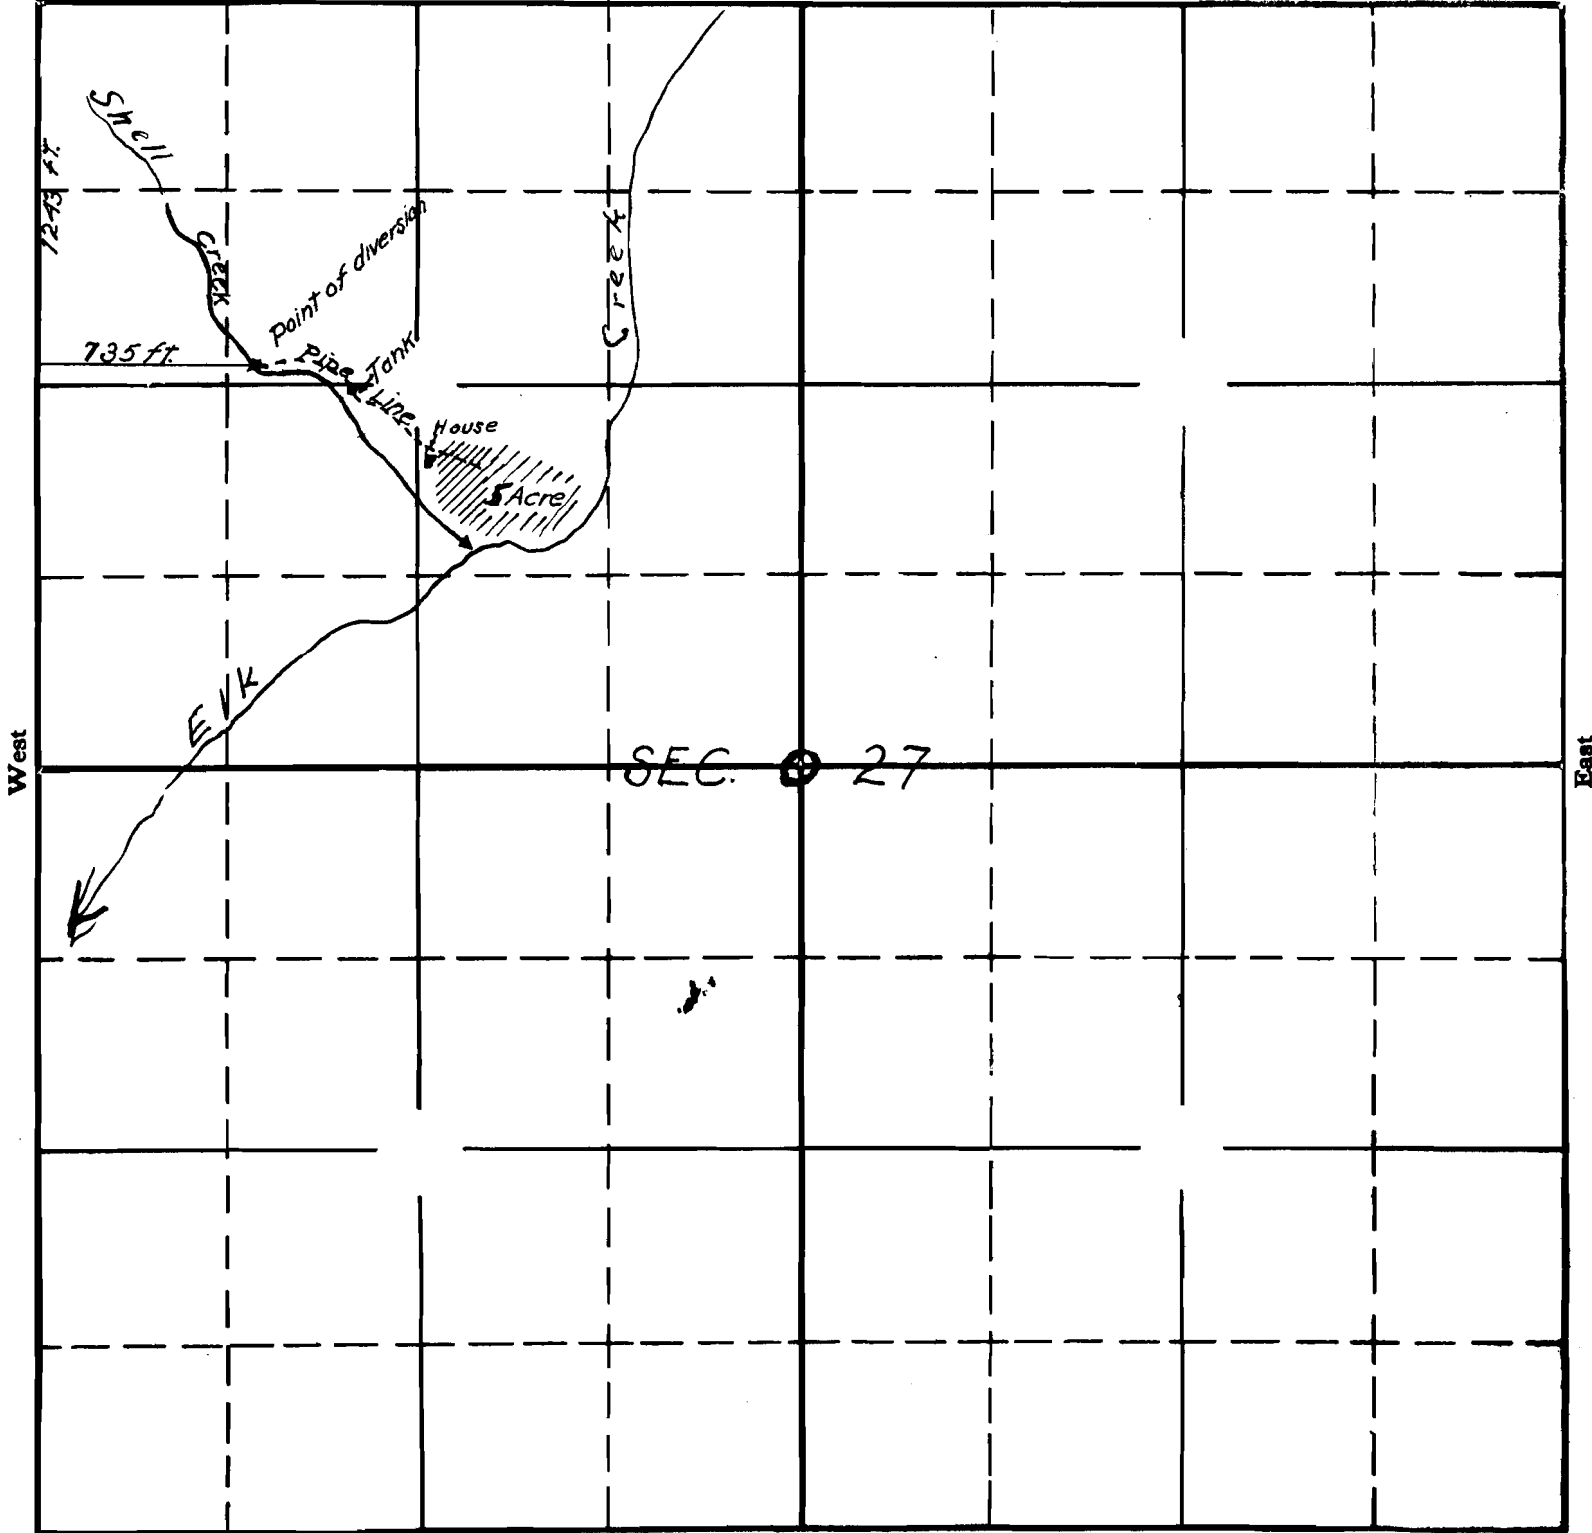

Sketch showing diversion and place of use
 for application to appropriate the
 waters of shell creek for domestic
 and garden purposes by C.B. Pullman
 Map made by C.B.P.

15-74-16826-4
 APPLICATION No. 16826
 PERMIT No. 12587