


TOWNSHIP 9S RANGE 3W W M

North

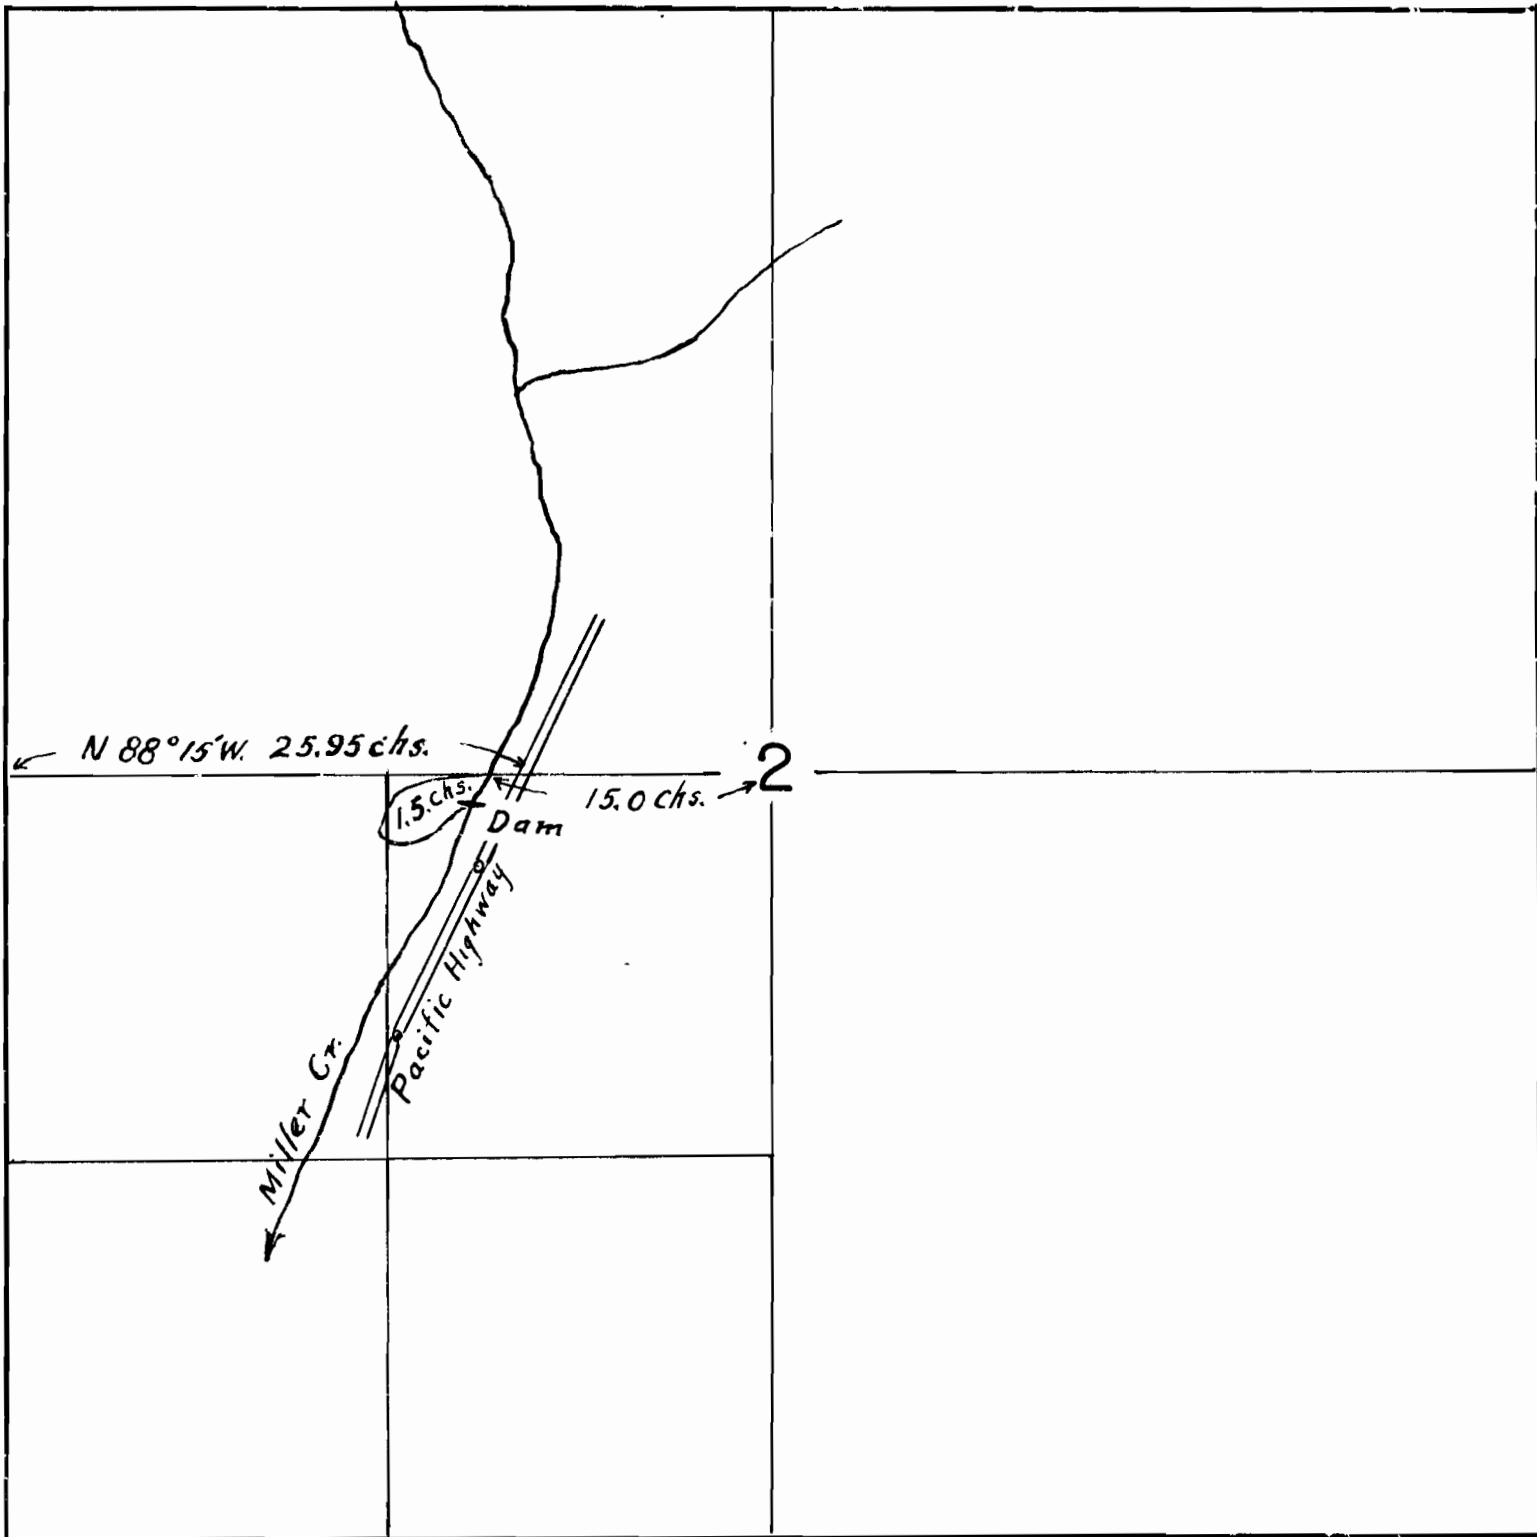


2-76C-16831
APPLICATION No. 16831
PERMIT No. 12590

SECTION

TOWNSHIP 95 , RANGE 3W , W. M.

North

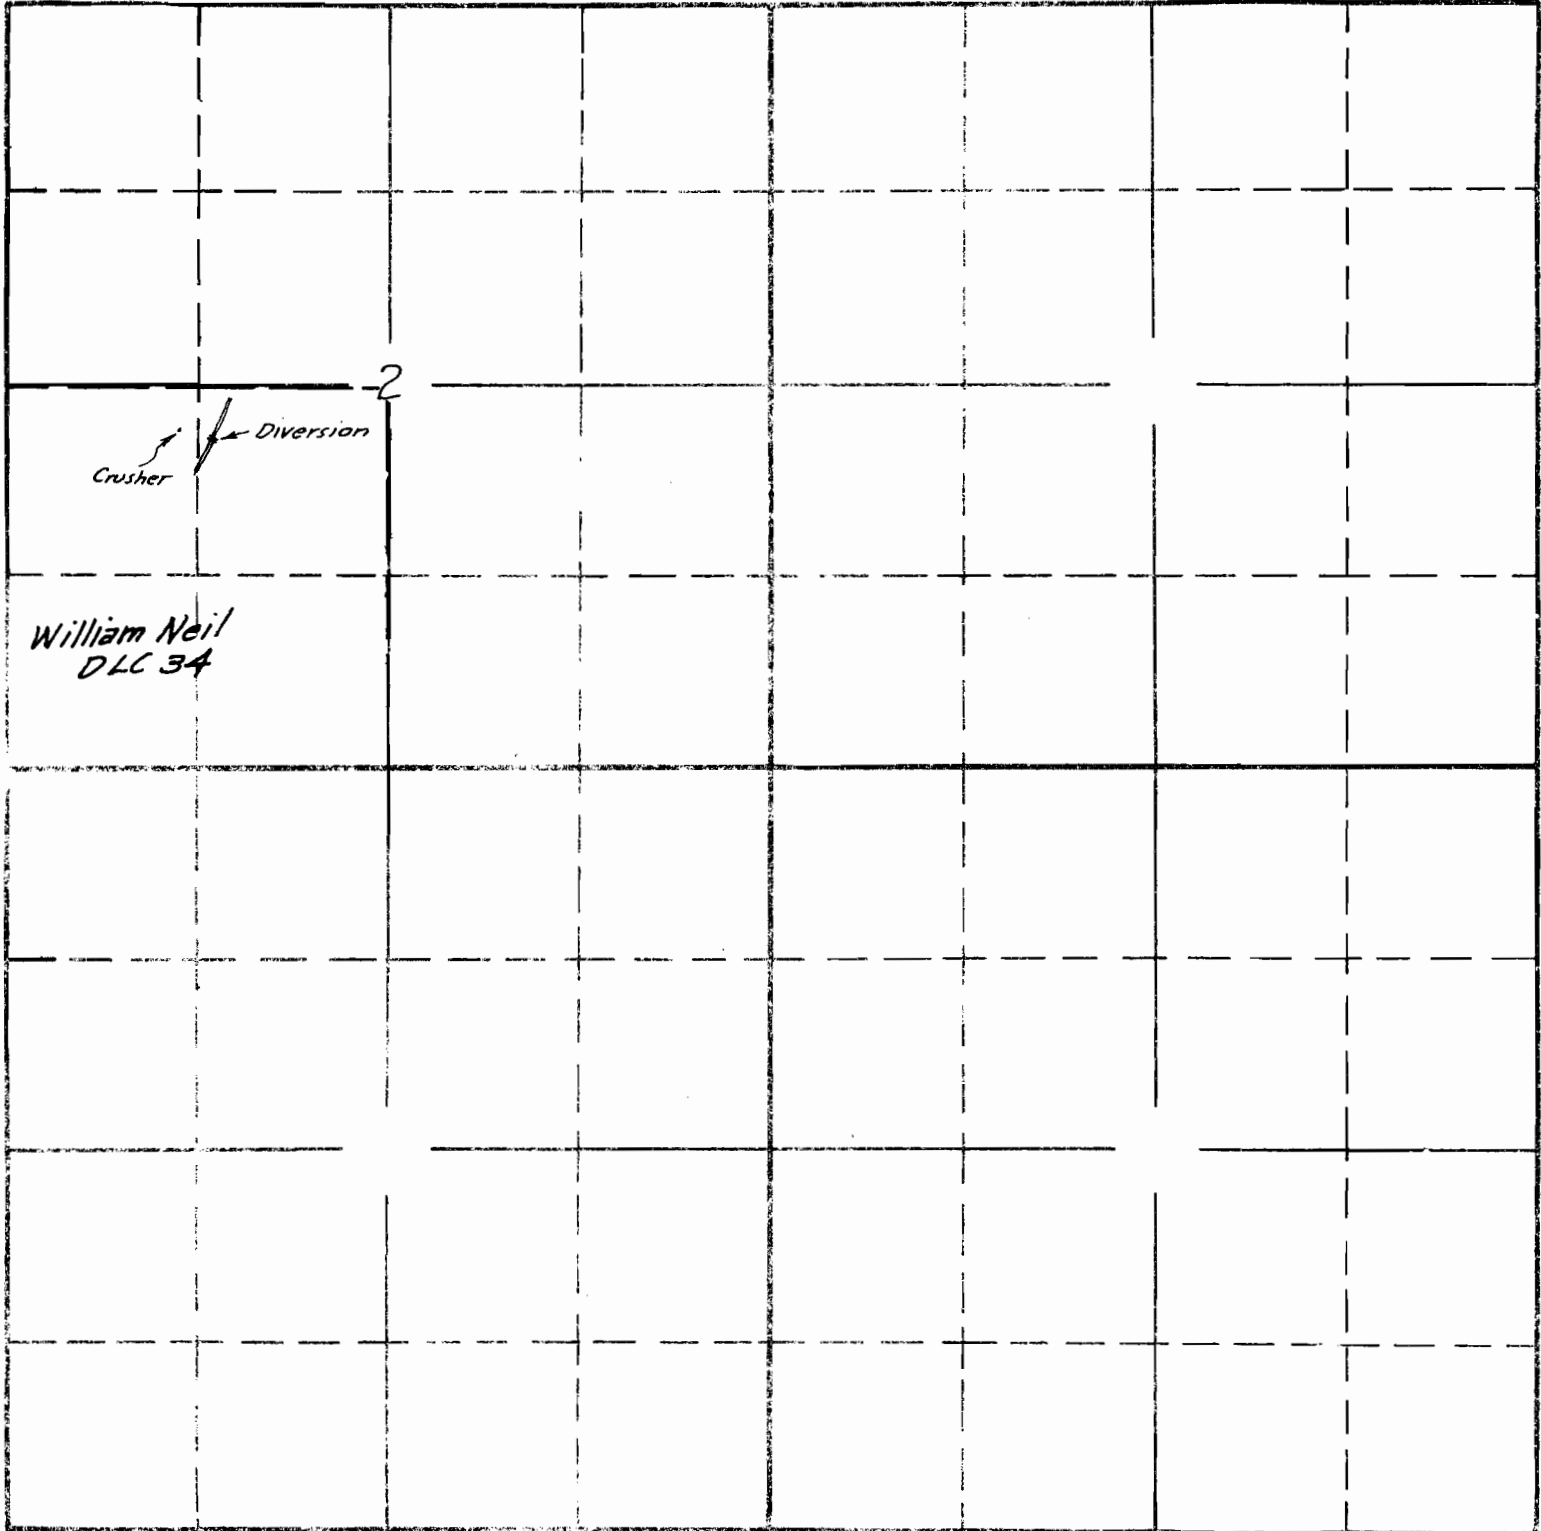

South

APPLICATION No. 16831
PERMIT No. 12590