


OFFICE OF STATE ENGINEER

RECEIVED

AUG 2 1916  
SALEM, OREGON

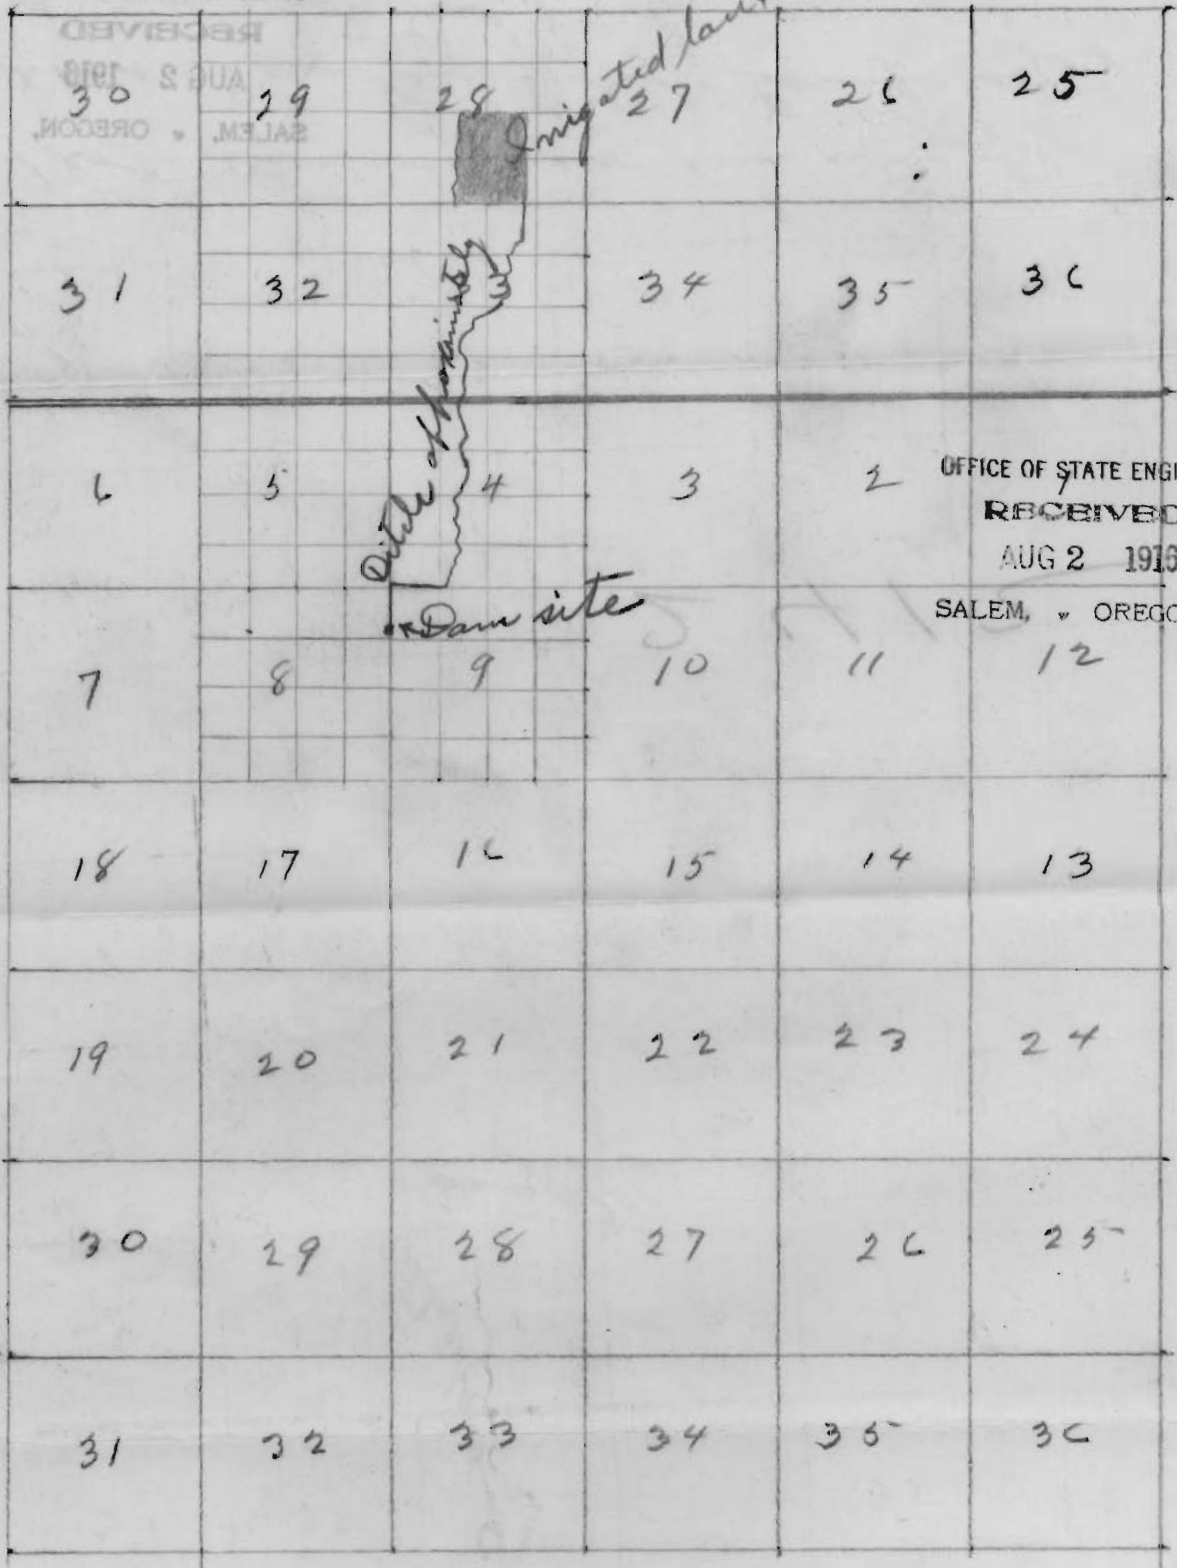

T. 8 S.R. 40

R. 9 S.R. 40

Plot showing new dam site of  
 Heddes-Snawley Ditch Company,  
 and my irrigated land.  
 C. C. Swift.