

JOHN D. GARRETT DLC 38

DLC 67

14

House

Pond

Dam
Mintthorne Cr.

03

ELISHA KELLOGG DLC.

6

5

Surveyed Aug 18, 1841.
Charles C. Buckingham

App. 16838


Permit 12604

SECTION

5

TOWNSHIP 25, RANGE 26, W. M.

North

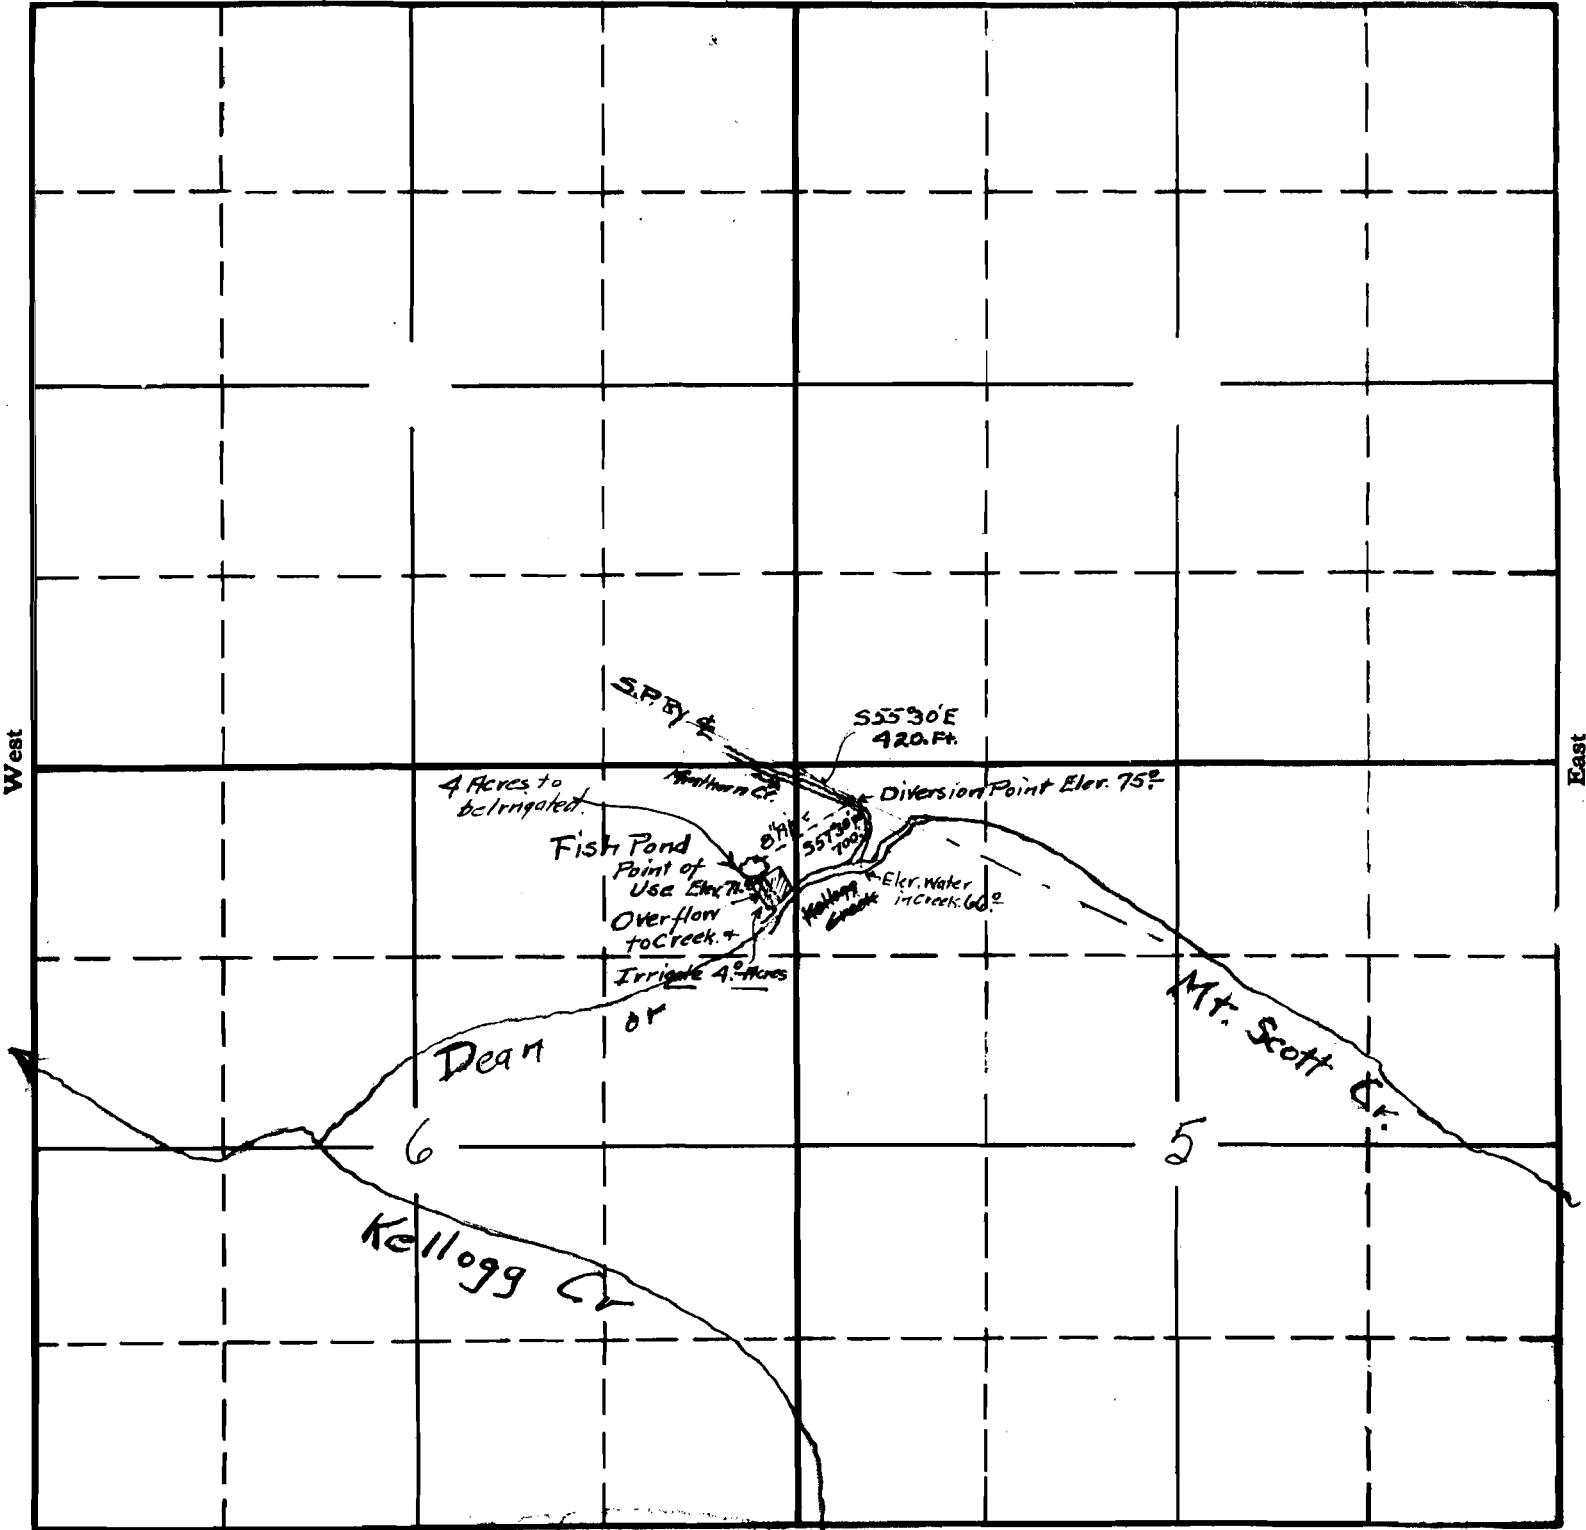

West

East

South

2-76C-16838-*bl*
 APPLICATION No. 16838
 PERMIT No. 12604